DISTRICT	COUNTY	ROUTE	PROJECT	SHEET
5-0	BERKS	I-78		
WINDSOR TWP. AND BORO OF HAMBURG				
REVISIONS				

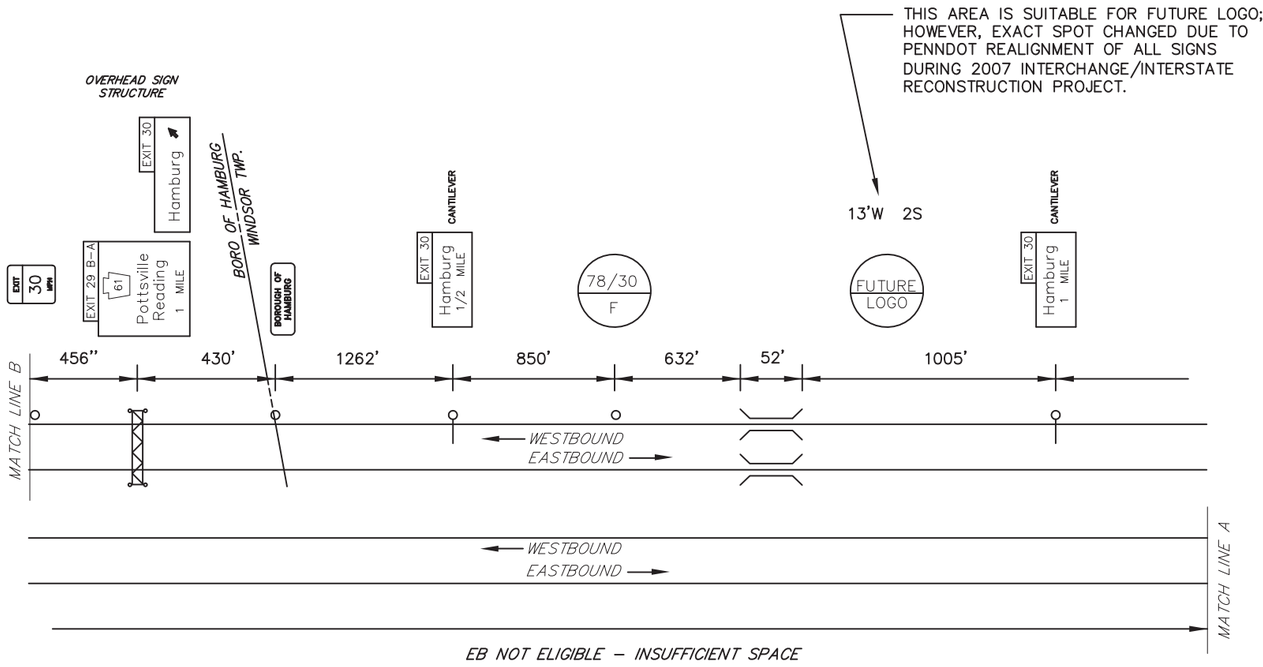

MAINLINE SCHEMATIC
NOT TO SCALE

TABULATION OF QUANTITIES		
ITEM	UNIT	QUANTITY
POST MOUNTED SIGNS, TYPE A, LOGO	SQ.FT.	
POST MOUNTED SIGNS, TYPE B, LOGO	SQ.FT.	
POST MOUNTED SIGNS, TYPE C, LOGO	SQ.FT.	
BREAKAWAY SYSTEMS	EACH	
* STEEL S OR W BEAM POSTS	LBS.	
LOGO SIGN MOUNTING	EACH	
REMOVAL OF POST MOUNTED MOTORIST SERVICE SIGNS, TYPES B, C & F	L.S.	–

* APPROXIMATE QUANTITY FOR INFORMATION ONLY

SYMBOLS
- ○ *Existing Sign to Remain*
- △ *Existing Sign to be Removed*
- □ *Existing Sign Reset as Shown*
- ● NEW SIGN
- × FUTURE SIGN
- Ø *Existing Utility Pole*

DO NOT CLOSE OR RESTRICT TRAVEL LANES
BETWEEN 6:00 AM & 9:00 AM, AND
BETWEEN 3:00 PM & 6:00 PM, MONDAY THRU FRIDAY.
DO NOT WORK DURING HOLIDAY PERIODS.

EXIT 30 SPECIFIC INFORMATION PANEL			
SIGN NUMBER	LEGEND	BUSINESS	LOGO. NO.
78/30 F WB	FOOD		
		ARBY'S	2

WB SIGNS

6'Hx13'W
FUTURE 16'H
W14x30 A572
B650– #1, #2
BURIED 12"

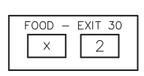

23/07/2018 FIELD INSPECTION
NOTED GMS FOOD SIGN TO BE
REMOVED

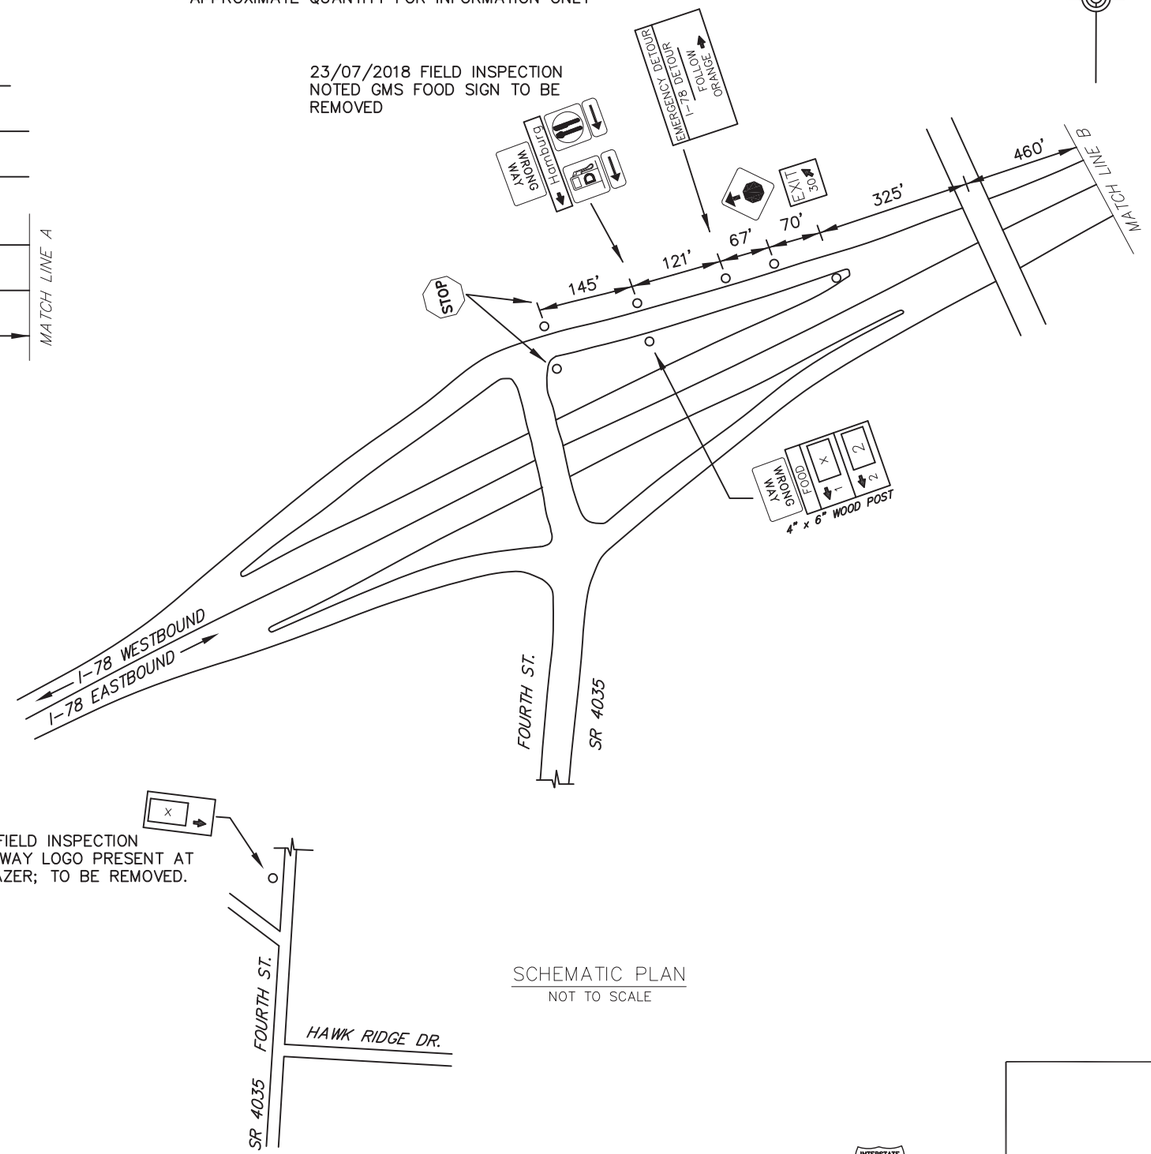

23/07/2018 FIELD INSPECTION
NOTED A SUBWAY LOGO PRESENT AT
THIS TRAILBLAZER; TO BE REMOVED.

SCHEMATIC PLAN
NOT TO SCALE

INTERSTATE 78
HAMBURG
EXIT 30

D:\2015_ID\E57-215\97\v-01\Vol\PSE\AS-BUILT DRAWINGS\PENNDOT DISTRICT 05\BERKS - 06\10-XX SHTXX-178_EXIT 30 PLAN
July/26/2018 9:44 AM