DISTRICT	COUNTY	ROUTE	PROJECT	SHEET
12-0	GREENE	I-79		

FRANKLIN TOWNSHIP

REVISIONS

TABULATION OF QUANTITIES		
ITEM	UNIT	QUANTITY
POST MOUNTED SIGNS, TYPE A, LOGO	SQ.FT.	
POST MOUNTED SIGNS, TYPE B, LOGO	SQ.FT.	
POST MOUNTED SIGNS, TYPE C, LOGO	SQ.FT.	
BREAKAWAY SYSTEMS	EACH	
* STEEL S OR W BEAM POSTS	LBS.	
LOGO SIGN MOUNTING	EACH	
REMOVAL OF POST MOUNTED MOTORIST SERVICE SIGNS, TYPES A, B, C, E & F	L.S.	–

* APPROXIMATE QUANTITY FOR INFORMATION ONLY

SYMBOLS

- ○ *Existing Sign to Remain*
- △ *Existing Sign to be Removed*
- □ *Existing Sign Reset as Shown*
- ● NEW SIGN
- × FUTURE SIGN
- Ø *Existing Utility Pole*

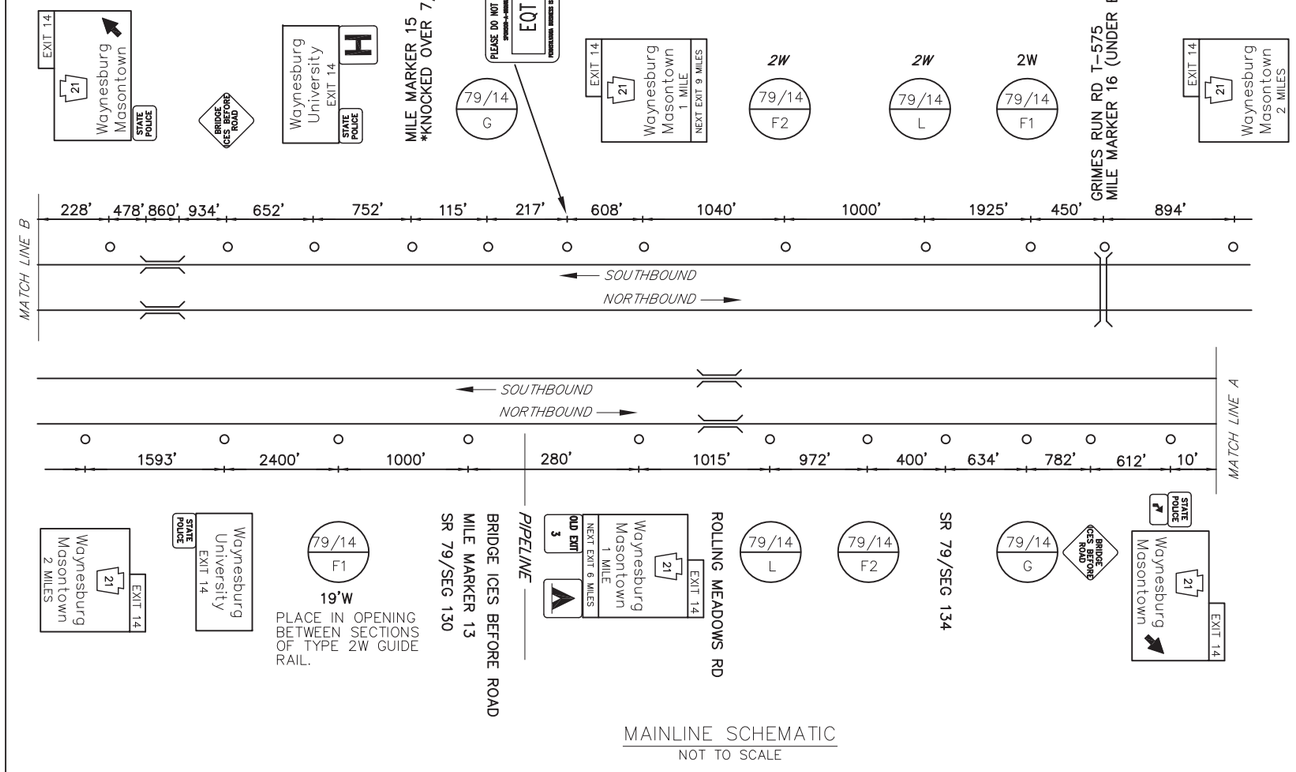

MAINLINE SCHEMATIC
NOT TO SCALE

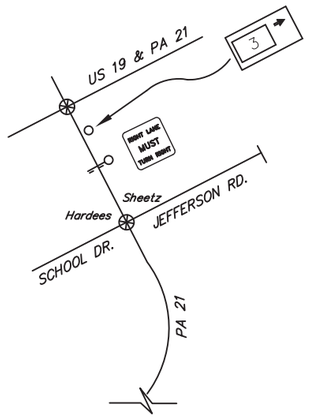

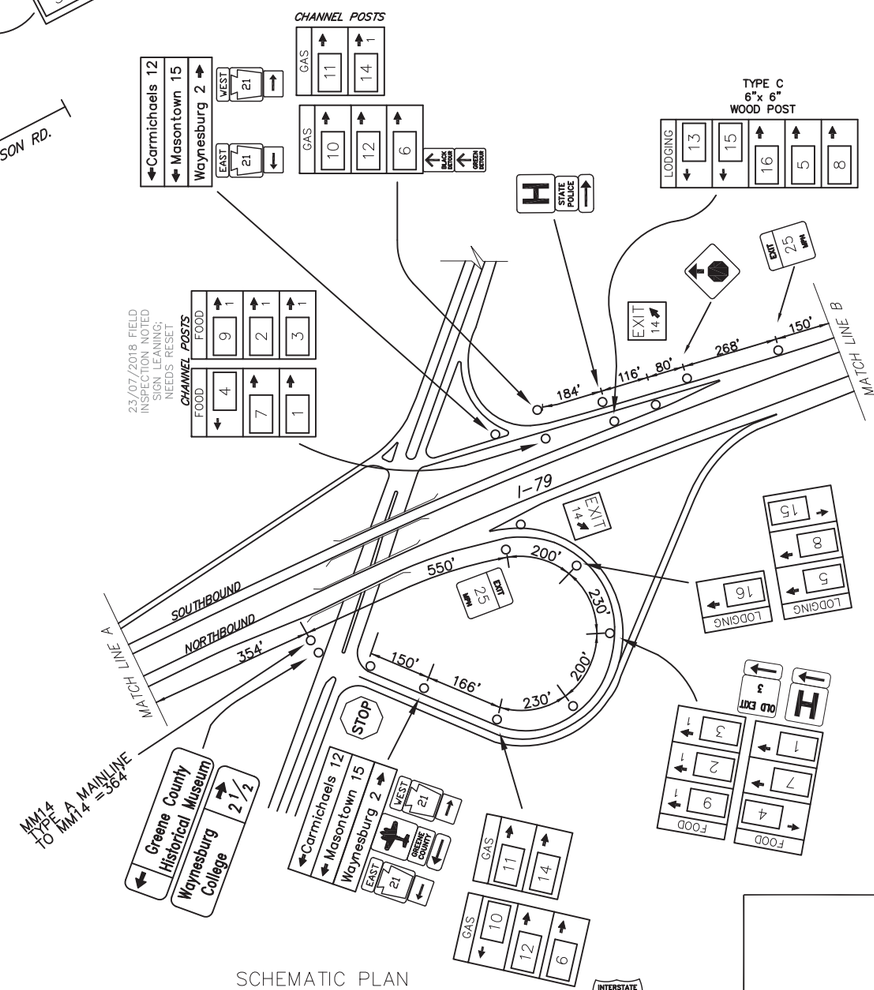

SCHEMATIC PLAN
NOT TO SCALE

WORK ALONG FREEWAY PERMITTED
BETWEEN 9:00 AM AND 3:00 PM.
DO NOT WORK DURING HOLIDAY PERIODS.
REINSTALL GUIDE RAIL AT END OF EACH DAY.

EXIT 14 SPECIFIC INFORMATION PANEL			
SIGN NUMBER	LEGEND	BUSINESS	LOGO. NO.
79/14 F NB 79/14 F SB	FOOD	WENDY'S	1
		HARDEE'S	2
		McDONALD'S (24 HOURS)	3
		BURGER KING	9
		DAIRY QUEEN	7
		BOB EVANS	4
		ARBY'S	17
79/14 G NB 79/14 G SB	GAS	BP (DIESEL)	10
		GETGO	6
		SUNOCO (Diesel/24 Hours)	11
		EXXON	12
		SHEETZ	14
79/14 L NB 79/14 L SB	LODGING	ECONOLODGE	5
		SUPER 8	8
		COMFORT INN	13
		MICROTEL INN & SUITES BY WYNDHAM	15
		HAMPTON INN	16

NB SIGNS

10'Hx16'W
48"W LOGO
W8x21
3M TYPE III
B650 – #?, #2

GAS – EXIT 14: 6 10 11 / 12 14

F2
14'Hx13'W
W10x26
3M TYPE III
B650 – #1, #1

FOOD – EXIT 14: 1 2 / 7 3 / 9 4

14'Hx13'W
W8x21 A572
3M TYPE III
B650 – #1, #2

LODGING – EXIT 14: 5 8 / 13 15 / 16

23/07/2018 FIELD INSPECTION NOTED GAS LOGOS 10, 11, & 14 ARE 3'X4'

SB SIGNS

23/07/2018 FIELD INSPECTION NOTED CORNER OF SB GAS ML BENT

GAS – EXIT 14: 6 10 11 / 12 14

10'Hx16'W
48"W LOGO
W8x18
3M TYPE III
B525 – #?, #3

FOOD – EXIT 14: 1 2 / 7 3 / 9 4

F2
14'Hx13'W
W10x26
3M TYPE III
B650 – #1, #1

LODGING – EXIT 14: 5 8 / 13 15 / 16

14'Hx13'W
FUTURE 16'H
W14x30 A572
3M TYPE III
B650 – #1, #1

WAYNESBURG
EXIT 14

D:\2015\DB3\215076-01\WW\PSE&AS-BUILT DRAWINGS\PENNDOT DISTRICT 12\GREENE - 30\10-XX SHTXX-179_ EXIT 14 PLAN
July/31/2018 11:20 AM