DISTRICT	COUNTY	ROUTE	PROJECT	SHEET
5-0	BERKS	PA-12		

MUHLENBERG TOWNSHIP

REVISIONS

TABULATION OF QUANTITIES		
ITEM	UNIT	QUANTITY
POST MOUNTED SIGNS, TYPE A, LOGO	SQ.FT.	
POST MOUNTED SIGNS, TYPE B, LOGO	SQ.FT.	
POST MOUNTED SIGNS, TYPE C, LOGO	SQ.FT.	
BREAKAWAY SYSTEMS	EACH	
* STEEL S OR W BEAM POSTS	LBS.	
LOGO SIGN MOUNTING	EACH	
REMOVAL OF POST MOUNTED MOTORIST SERVICE SIGNS, TYPES A & E	EACH	
REMOVAL OF POST MOUNTED MOTORIST SERVICE SIGNS, TYPES B, C & F	L.S.	

* APPROXIMATE QUANTITY FOR INFORMATION ONLY

SYMBOLS

- ○ *Existing Sign to Remain*
- △ *Existing Sign to be Removed*
- □ *Existing Sign Reset as Shown*
- ● NEW SIGN
- × FUTURE SIGN
- Ø *Existing Utility Pole*

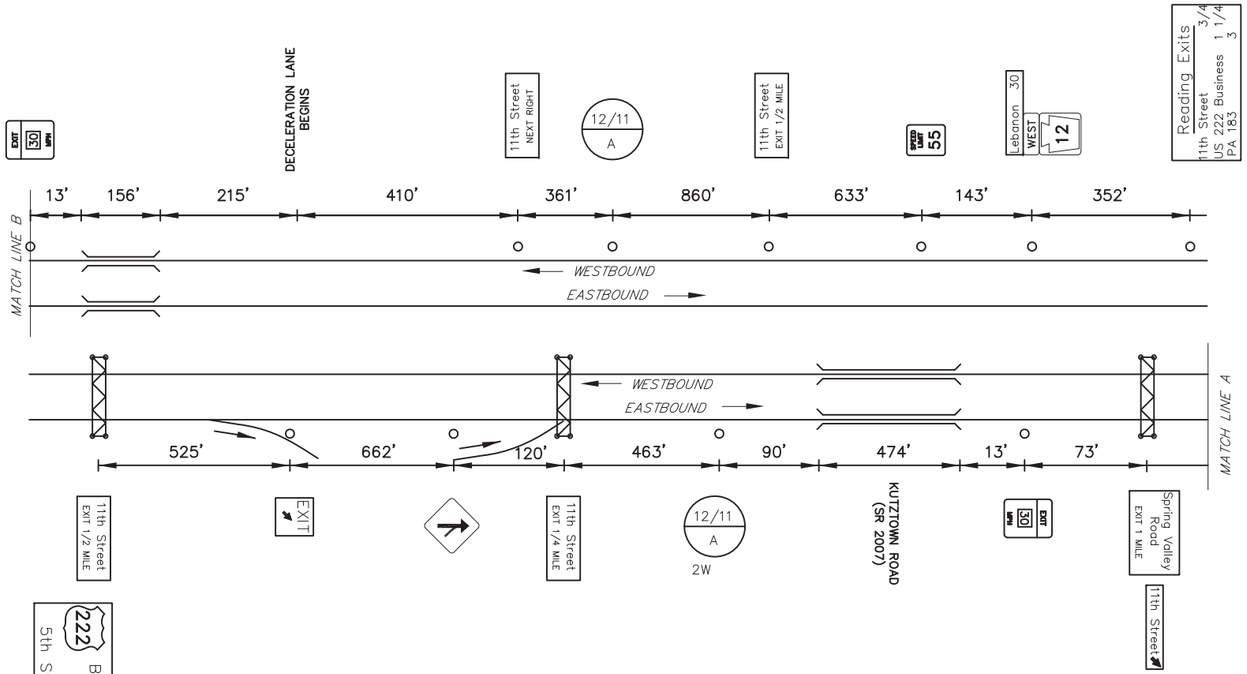

MAINLINE SCHEMATIC
NOT TO SCALE

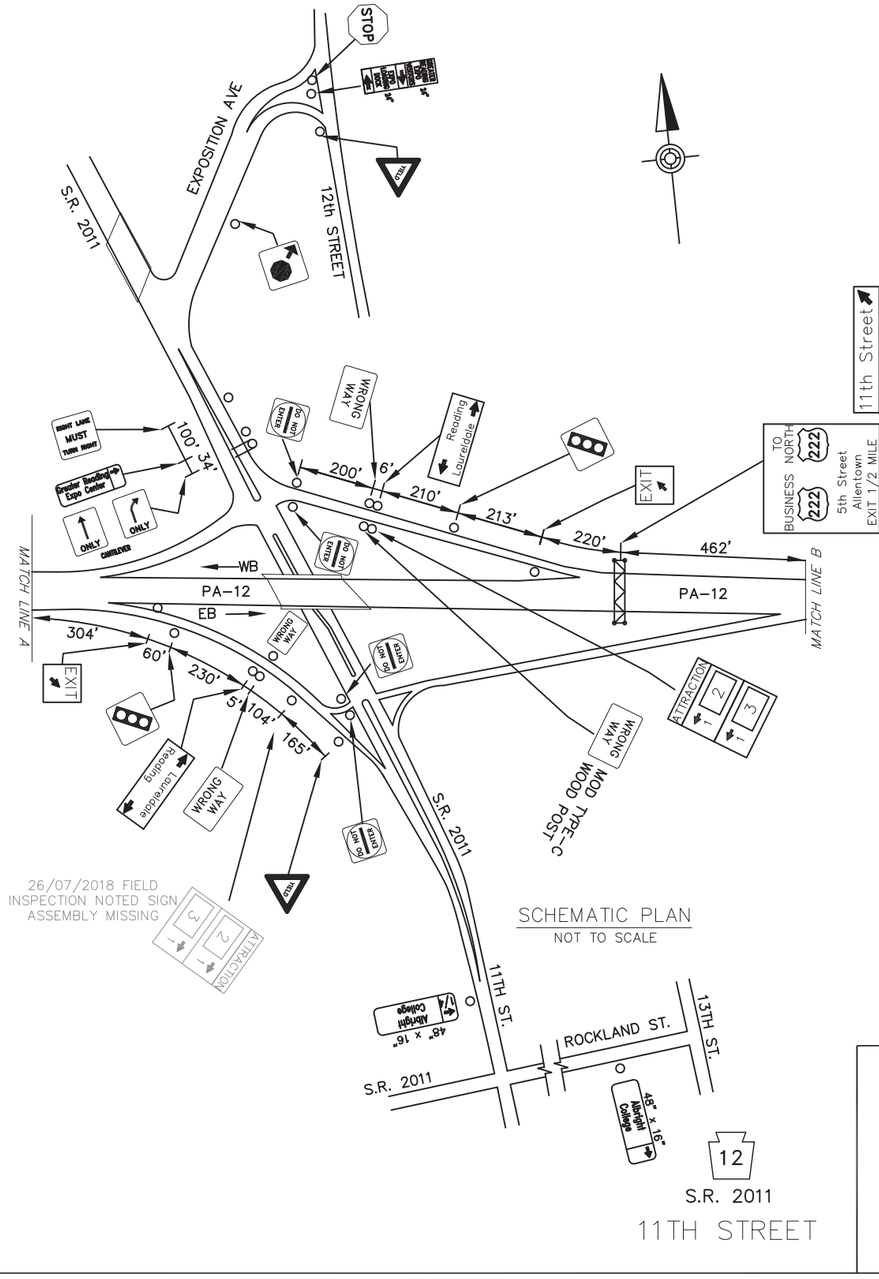

SCHEMATIC PLAN
NOT TO SCALE

DO NOT CLOSE OR RESTRICT TRAVEL LANES
BETWEEN 6:00 AM AND 9:00 AM, AND
BETWEEN 3:00 PM AND 6:00 PM, MONDAY THRU FRIDAY.
DO NOT WORK DURING HOLIDAY PERIODS.

11TH ST. EXIT SPECIFIC INFORMATION PANEL			
SIGN NUMBER	LEGEND	BUSINESS	LOGO. NO.
12/11 A EB 12/11 A WB	ATTRACTION		
		ALBRIGHT COLLEGE	2
		HIESTER LANE FAMILY ENTERTAINMENT CENTER	3

EB SIGNS

6'Hx13'W
FUTURE 12'H
W10x26
TYPE IX LEGEND
TYPE III BACKGROUND
B650 – #1, #1

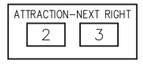

WB SIGNS

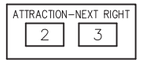

6'Hx13'W
FUTURE 12'H
W8x21
TYPE IX LEGEND
TYPE III BACKGROUND
B525 – #1, #1

D:\2015-JDB3-021507\6-01\MAPS\PSE\AS-BUILT DRAWINGS\PENNDOT DISTRICT 05\BERKS - 06\10-XX SHTXX-PA12_EXIT 11TH ST PLAN
JULY/31/2018 1:49 PM