DISTRICT	COUNTY	ROUTE	PROJECT	SHEET
12-0	WASHINGTON	I-70		
BUFFALO TOWNSHIP				
REVISIONS				

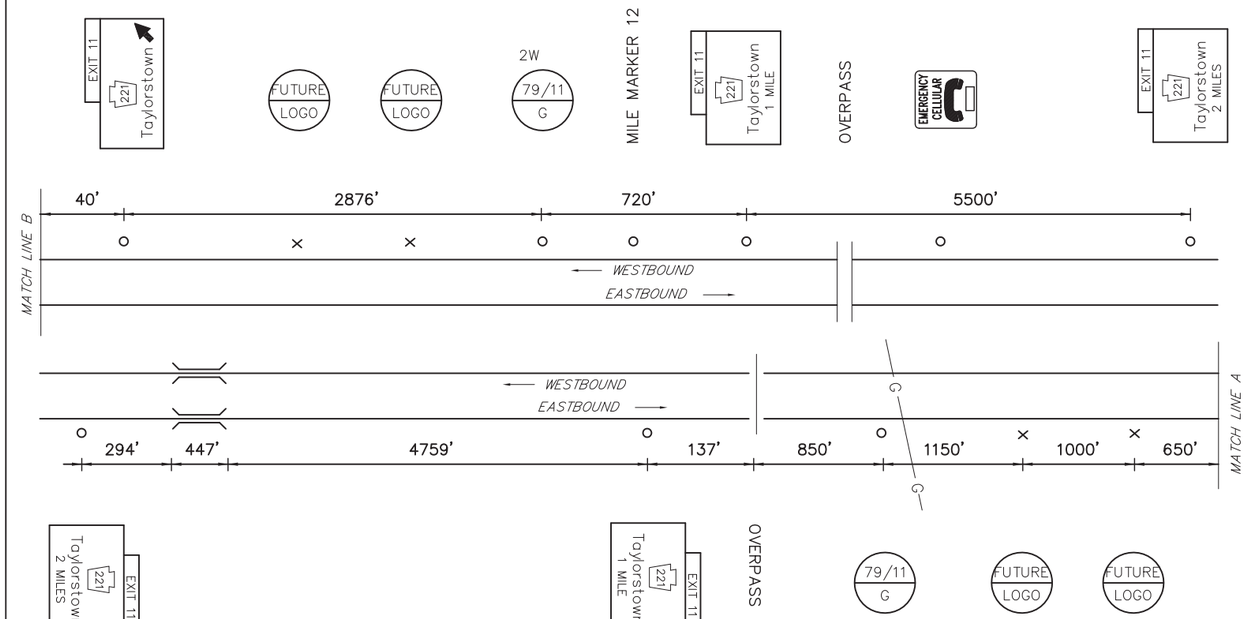

MAINLINE SCHEMATIC
NOT TO SCALE

TABULATION OF QUANTITIES		
ITEM	UNIT	QUANTITY
POST MOUNTED SIGNS, TYPE A, LOGO	SQ.FT.	
POST MOUNTED SIGNS, TYPE B, LOGO	SQ.FT.	
POST MOUNTED SIGNS, TYPE C, LOGO	SQ.FT.	–
BREAKAWAY SYSTEMS	EACH	
* STEEL S OR W BEAM POSTS	LBS.	
LOGO SIGN MOUNTING	EACH	
REMOVAL OF POST MOUNTED MOTORIST SERVICE SIGNS, TYPES A & E	EACH	
REMOVAL OF POST MOUNTED MOTORIST SERVICE SIGNS, TYPES B, C & F	L.S.	1

* APPROXIMATE QUANTITY FOR INFORMATION ONLY

SYMBOLS

- ○ *Existing Sign to Remain*
- △ *Existing Sign to be Removed*
- □ *Existing Sign Reset as Shown*
- ● NEW SIGN
- × FUTURE SIGN
- Ø *Existing Utility Pole*

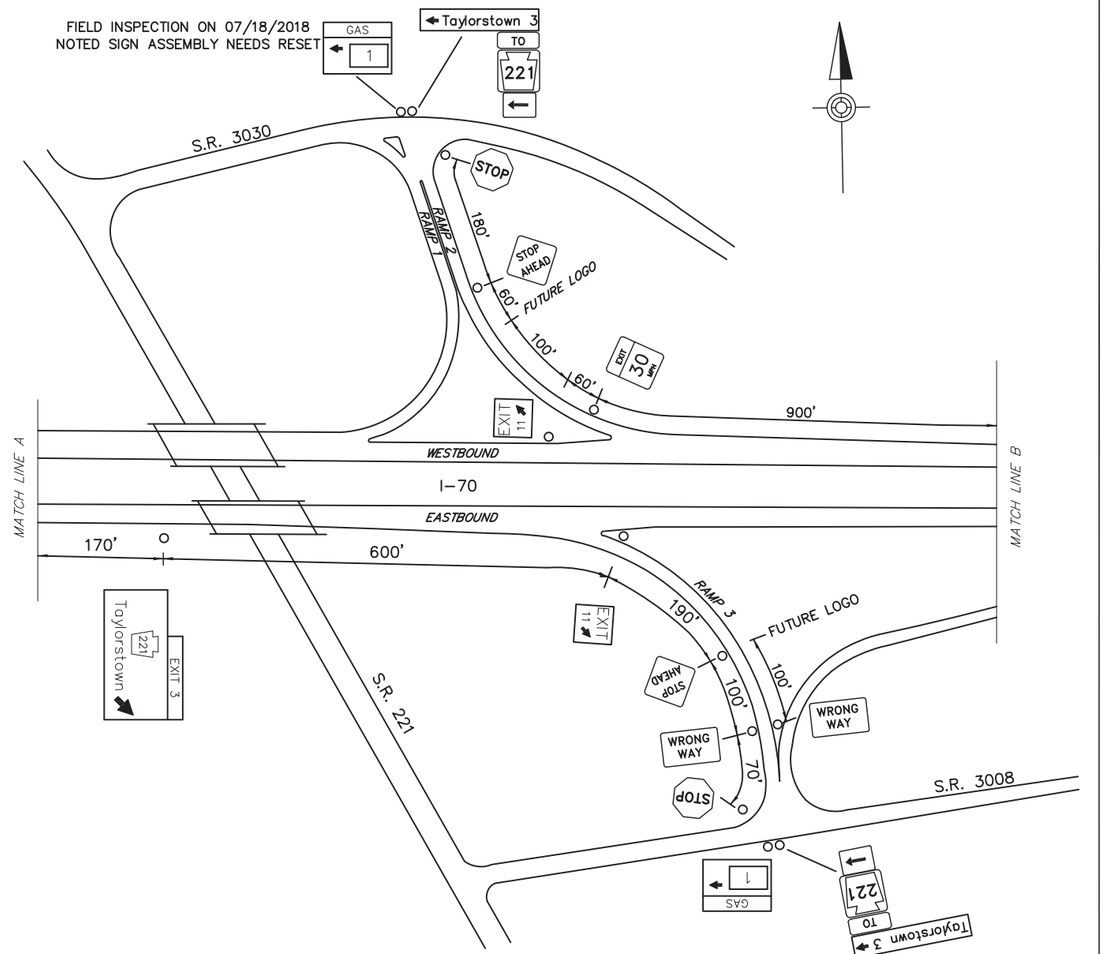

SCHEMATIC PLAN
NOT TO SCALE

EXIT 11 SPECIFIC INFORMATION PANEL			
SIGN NUMBER	LEGEND	BUSINESS	LOGO. NO.
70/11 G EB 70/11 G WB	GAS	BP (diesel)	1

EB SIGNS

6'Hx13'W
FUTURE 16'H
W12x26
TYPE III
B650 – #2, #2

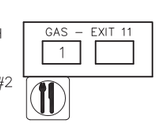

WB SIGNS

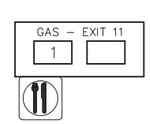

6'Hx13'W
FUTURE 12'H
W10x26 A572
TYPE III
B650 – #1, #1

INTERSTATE 70
TAYLORSTOWN
EXIT 11

D:\2015JOBS\215076-01\HW\PSE\AS-BUILT DRAWINGS\PENNDOT DISTRICT 12\WASHINGTON - 62\10-XX SHTXX-170_EXIT 11 PLAN
July/24/2018 10:29 AM