DISTRICT	COUNTY	ROUTE	PROJECT	SHEET
6-0	CHESTER	SR 202		

EAST WHITELAND & TREDYFFRIN TOWNSHIPS

REVISIONS

TABULATION OF QUANTITIES		
ITEM	UNIT	QUANTITY
POST MOUNTED SIGNS, TYPE A, LOGO	SQ.FT.	
POST MOUNTED SIGNS, TYPE B, LOGO	SQ.FT.	
POST MOUNTED SIGNS, TYPE C, LOGO	SQ.FT.	–
BREAKAWAY SYSTEMS	EACH	–
* STEEL S OR W BEAM POSTS	LBS.	
LOGO SIGN MOUNTING	EACH	
REMOVAL OF POST MOUNTED MOTORIST SERVICE SIGNS, TYPES A & E	EACH	–
REMOVAL OF POST MOUNTED MOTORIST SERVICE SIGNS, TYPES B, C & F	L.S.	–

* APPROXIMATE QUANTITY FOR INFORMATION ONLY

SYMBOLS

- ○ *Existing Sign to Remain*
- △ *Existing Sign to be Removed*
- □ *Existing Sign Reset as Shown*
- ● NEW SIGN
- × FUTURE SIGN
- Ø *Existing Utility Pole*

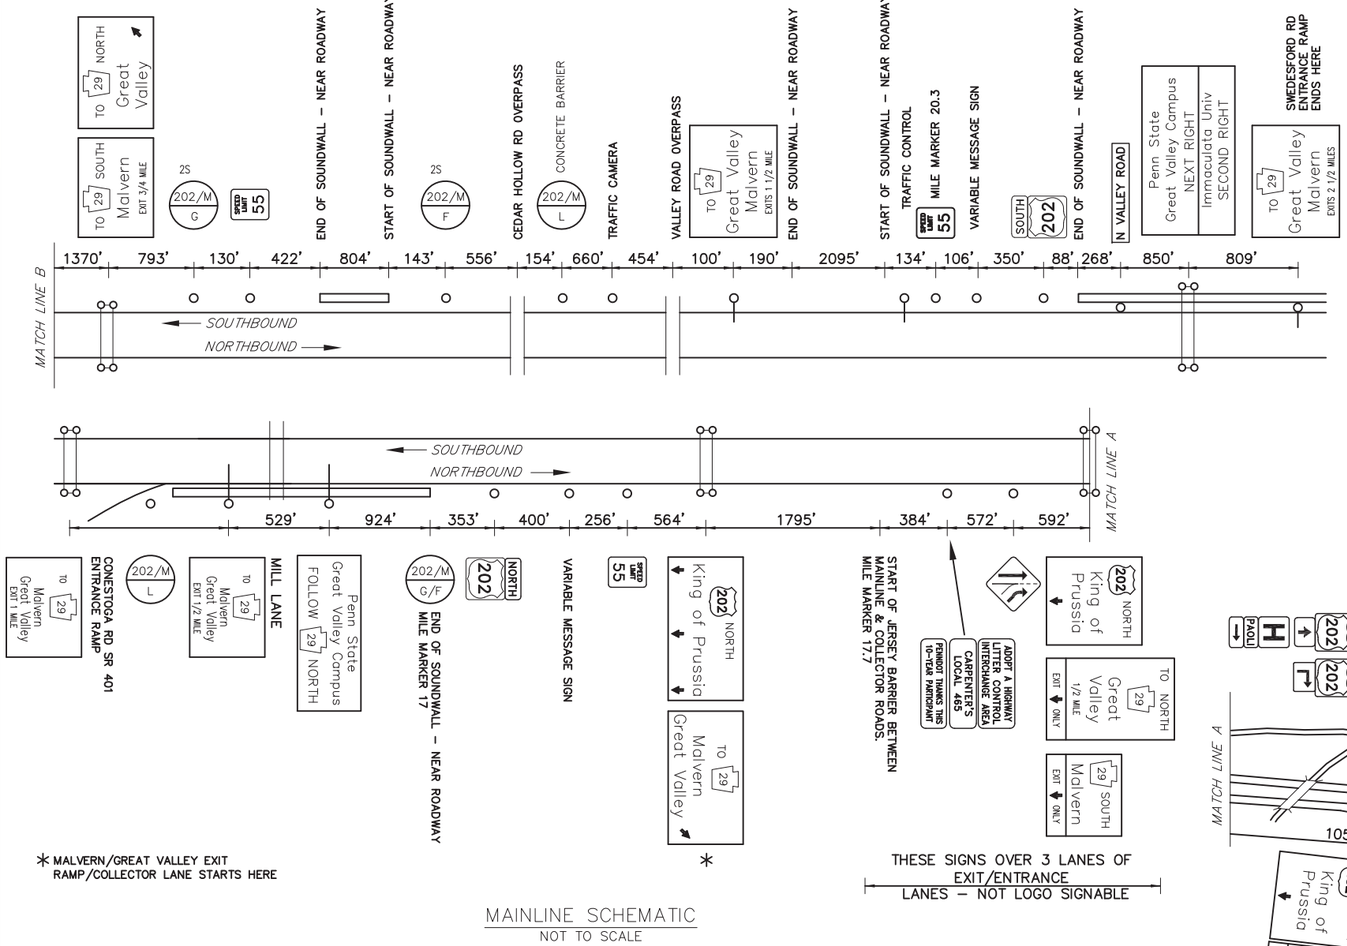

MAINLINE SCHEMATIC
NOT TO SCALE

MALVERN EXIT SPECIFIC INFORMATION PANEL			
SIGN NUMBER	LEGEND	BUSINESS	LOGO. NO.
202/M F NB 202/M F SB	FOOD	FRIENDLY'S	6
		WEGMANS MARKET CAFE'	10
		PANERA BREAD	12
202/M L NB 202/M L SB	LODGING	THE DESMOND	1
		HOMEWOOD SUITES – HILTON	2
		HOLIDAY INN EXPRESS	3
		COURTYARD BY MARRIOTT	5
		EXTENDED STAY AMERICA	11
		RESIDENCE INN	13
202/M G NB 202/M G SB	GAS		
		WAWA (DIESEL)	8

NB SIGNS

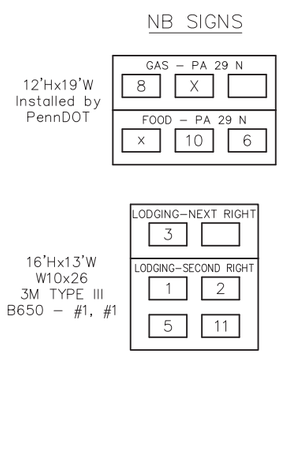

SB SIGNS

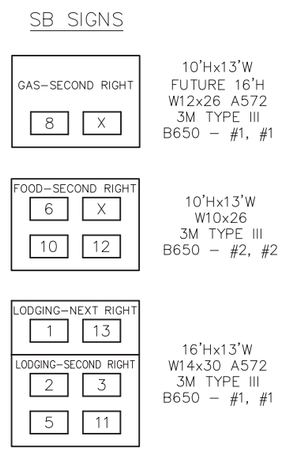

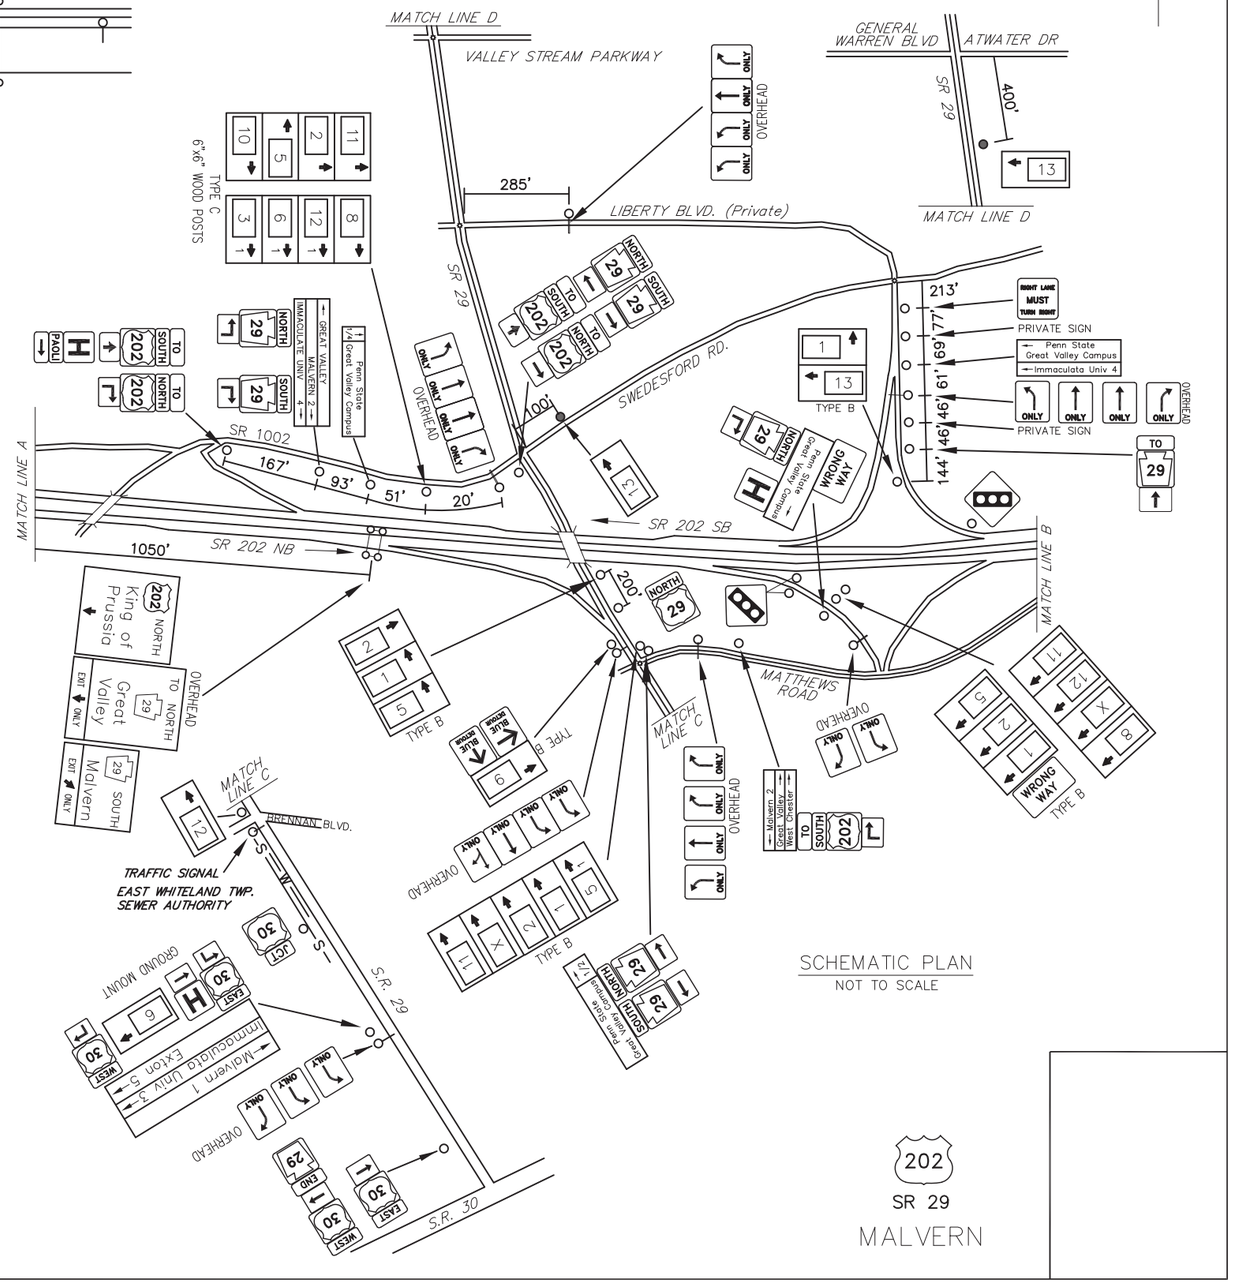

SCHEMATIC PLAN
NOT TO SCALE

202
SR 29
MALVERN

\\DAVFPROJ01\PROJECTS\2015\D3B5\D25076-01\Hwy\PSE\As-Built Draw\MGS\PENNDOT DISTRICT 06\CHESTER - 15\10-XX_SHTXX US202_MALVERN PLAN
September/10/2018 11:14 AM