DISTRICT	COUNTY	ROUTE	PROJECT	SHEET
11-0	ALLEGHENY	PA-28		
	HARRISON TOWNSHIP			
10-0	BUTLER			
	BUFFALO TOWNSHIP			
	REVISIONS			

TABULATION OF QUANTITIES		
ITEM	UNIT	QUANTITY
POST MOUNTED SIGNS, TYPE A, LOGO	SQ.FT.	
POST MOUNTED SIGNS, TYPE B, LOGO	SQ.FT.	
POST MOUNTED SIGNS, TYPE C, LOGO	SQ.FT.	
BREAKAWAY SYSTEMS	EACH	
* STEEL S OR W BEAM POSTS	LBS.	
LOGO SIGN MOUNTING	EACH	
REMOVAL OF POST MOUNTED MOTORIST SERVICE SIGNS, TYPES A & E	EACH	
REMOVAL OF POST MOUNTED MOTORIST SERVICE SIGNS, TYPES B, C & F	L.S.	–

* APPROXIMATE QUANTITY FOR INFORMATION ONLY

SYMBOLS

- ○ *Existing Sign to Remain*
- △ *Existing Sign to be Removed*
- □ *Existing Sign Reset as Shown*
- ● NEW SIGN
- × FUTURE SIGN
- Ø *Existing Utility Pole*

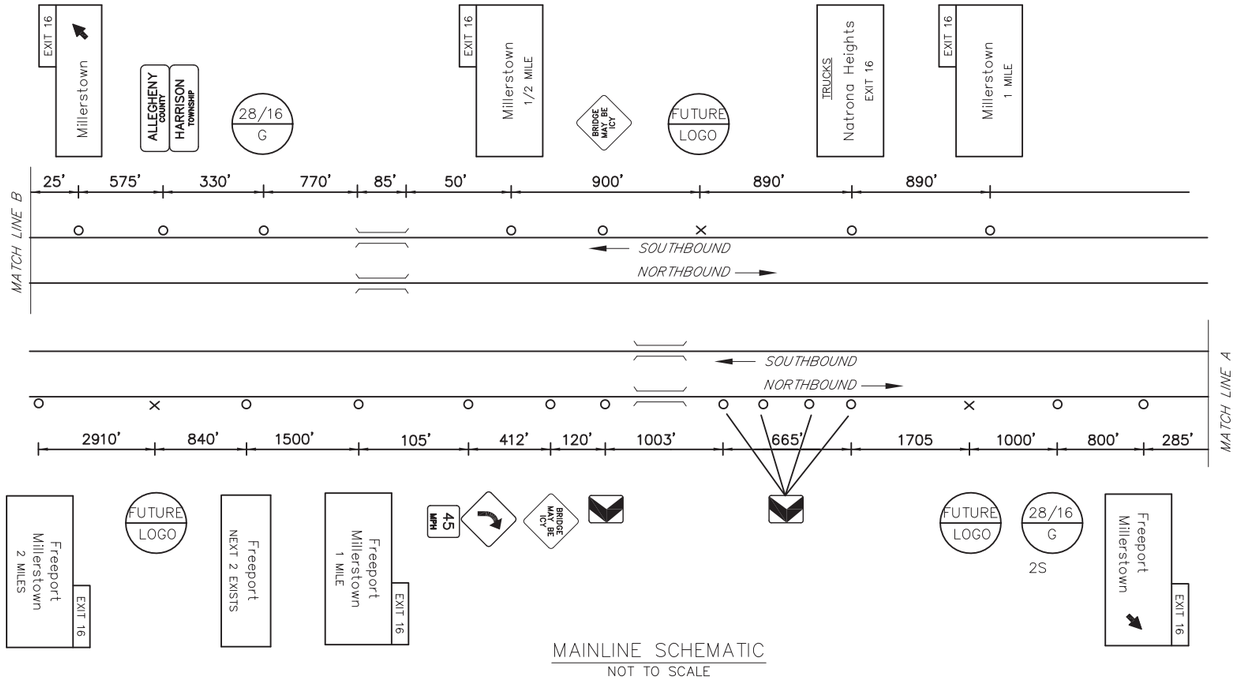

MAINLINE SCHEMATIC
NOT TO SCALE

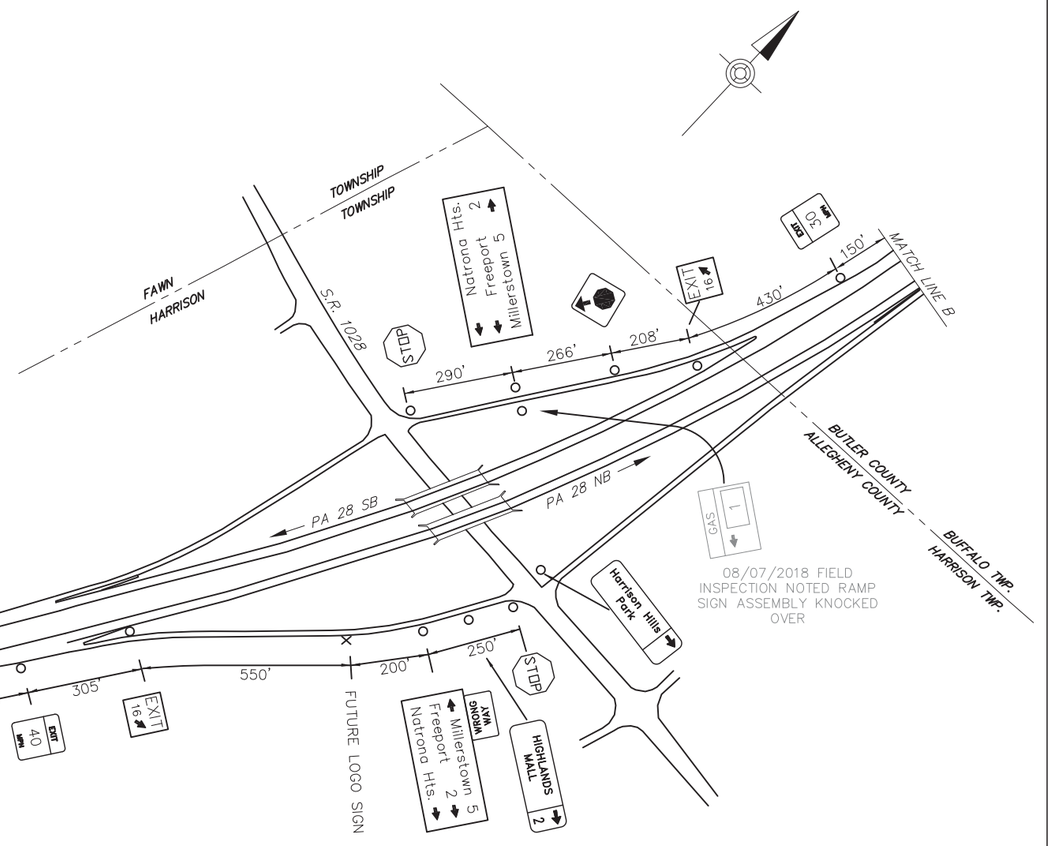

SCHEMATIC PLAN
NOT TO SCALE

EXIT 16 SPECIFIC INFORMATION PANEL			
SIGN NUMBER	LEGEND	BUSINESS	LOGO. NO.
28/16 G NB 28/16 G SB	GAS	BP (diesel)	1

NB SIGNS

6'Hx13'W
FUTURE 14'H
W14x30
B650 – #2, #1

SB SIGNS

6'Hx13'W
FUTURE 16'H
W14x30
B650 – #2, #2

28

FREEPORT / MILLERSTOWN
EXIT 16

D:\2015_ADES\105076-01\WA\PSE\AS-BUILT DRAWINGS\PENNDOT DISTRICT 11\ALLEGHENY - 00\10-XX_SVTXX 28_EXIT 16 PLAN
September/6/2018 11:38 AM