DISTRICT	COUNTY	ROUTE	PROJECT	SHEET
10-0	BUTLER	S.R. 28		
BUFFALO TOWNSHIP				
REVISIONS				

TABULATION OF QUANTITIES		
ITEM	UNIT	QUANTITY
POST MOUNTED SIGNS, TYPE A, LOGO	SQ.FT.	
POST MOUNTED SIGNS, TYPE B, LOGO	SQ.FT.	
POST MOUNTED SIGNS, TYPE C, LOGO	SQ.FT.	
BREAKAWAY SYSTEMS	EACH	
* STEEL S OR W BEAM POSTS	LBS.	
LOGO SIGN MOUNTING	EACH	
REMOVAL OF POST MOUNTED MOTORIST SERVICE SIGNS, TYPES A & E	EACH	
REMOVAL OF POST MOUNTED MOTORIST SERVICE SIGNS, TYPES B, C & F	L.S.	

* APPROXIMATE QUANTITY FOR INFORMATION ONLY

SYMBOLS

- *Existing Sign to Remain*
- *Existing Sign to be Removed*
- *Existing Sign Reset as Shown*
- NEW SIGN
- FUTURE SIGN
- *Existing Utility Pole*

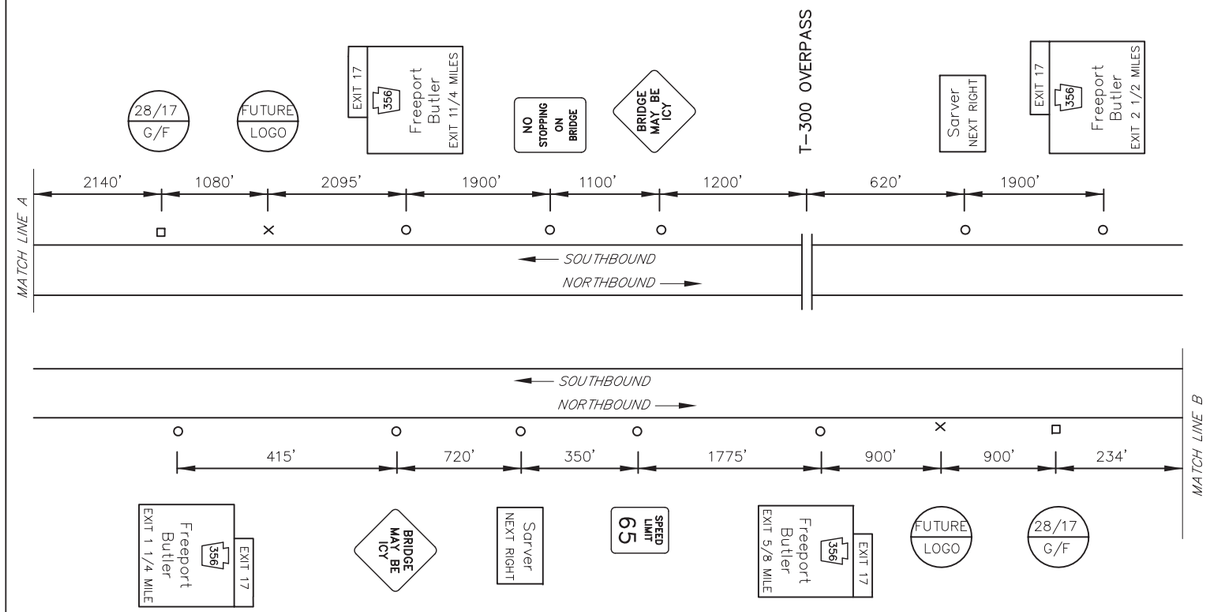

MAINLINE SCHEMATIC
NOT TO SCALE

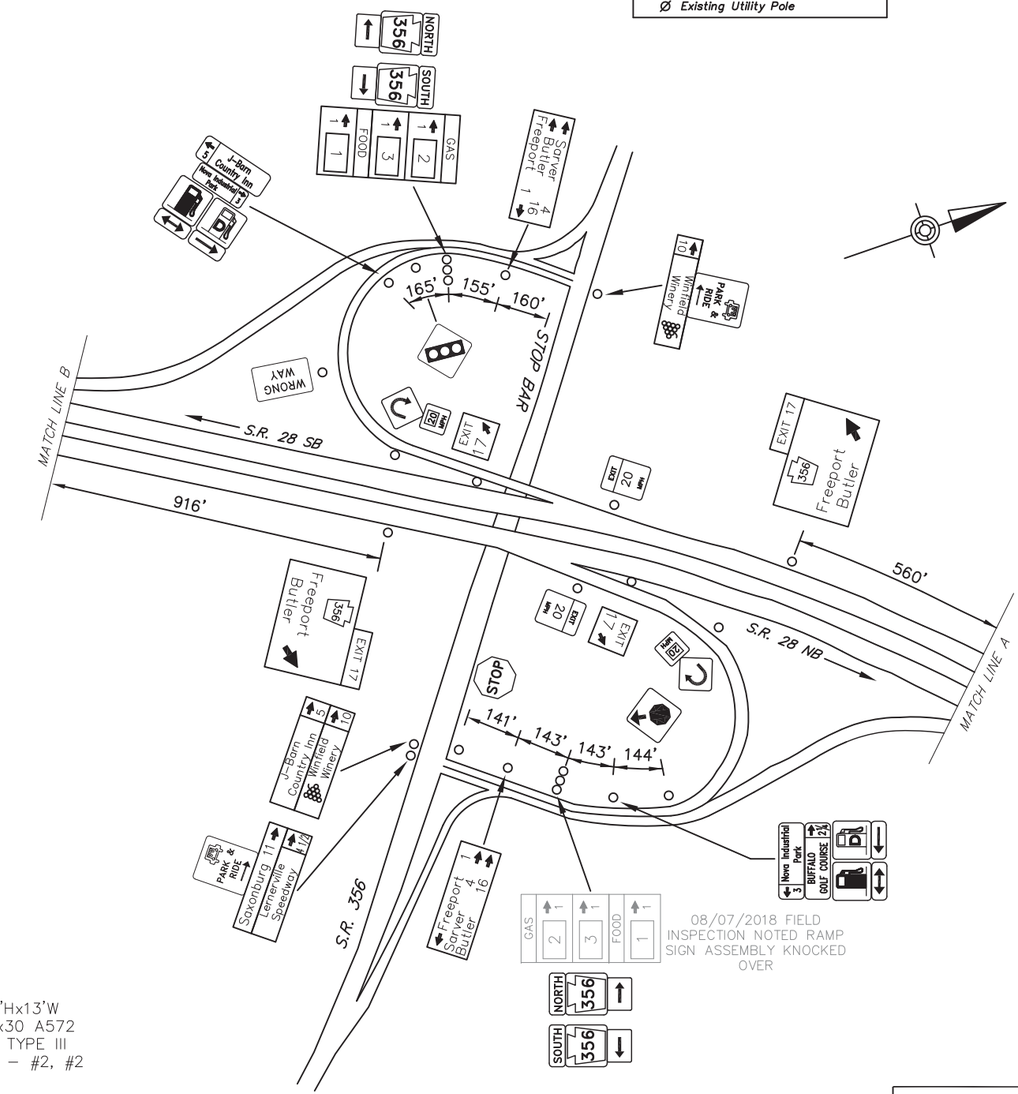

SCHEMATIC PLAN
NOT TO SCALE

EXIT 17 SPECIFIC INFORMATION PANEL			
SIGN NUMBER	LEGEND	BUSINESS	LOGO. NO.
28/17 F NB 28/17 F SB	FOOD	KING'S	1
		SHEETZ	4
		BURGER KING	5
28/17 G NB 28/17 G SB	GAS	GETGO (24 hrs / Diesel)	2
		SHEETZ (DIESEL)	3

NB SIGNS

12'Hx13'W
W14x30 A572
3M TYPE III
B650 – #2, #2

GAS – EXIT 17	
2	3
FOOD – EXIT 17	
1	4

SB SIGNS

GAS – EXIT 17	
2	3
FOOD – EXIT 17	
1	4

12'Hx13'W
W14x30 A572
3M TYPE III
B650 – #2, #2

28

FREEPORT (S.R. 356)
EXIT 17

D:\2015_ADES\215076-10\HWY\PSE\AS-BUILT DRAWINGS\PENNDOT DISTRICT 10\BUTLER - 10\10-XX SHTXX-IRB_EXIT 17 PLAN
September/6/2018 11:51 AM