DISTRICT	COUNTY	ROUTE	PROJECT	SHEET
6-0	CHESTER	US-30		
CALN & VALLEY TWPS. & COATESVILLE CITY				
REVISIONS				

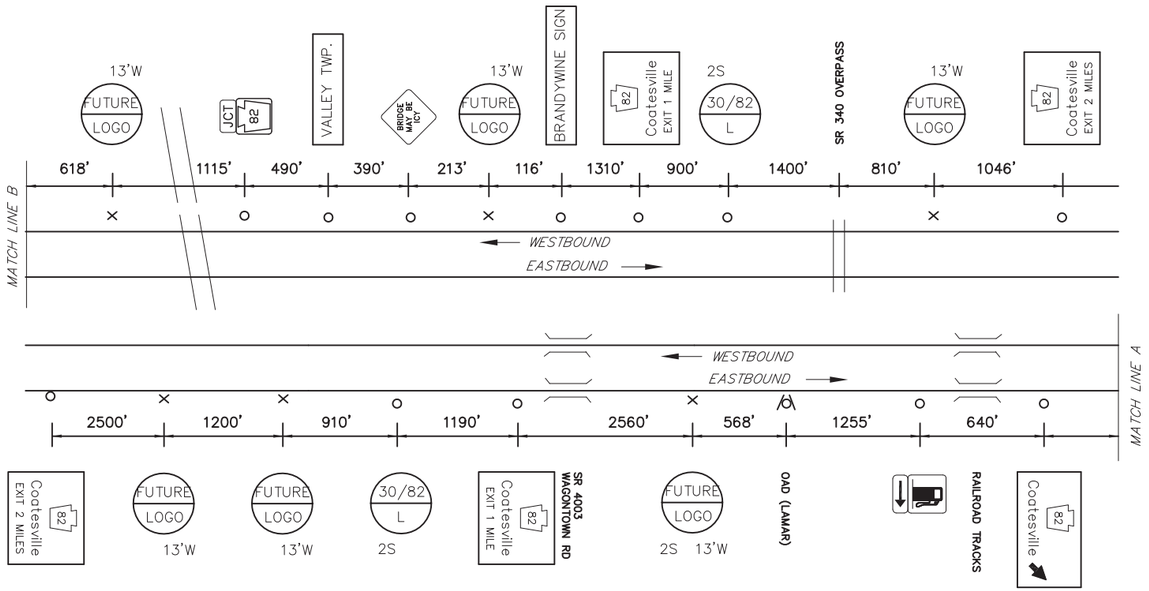

MAINLINE SCHEMATIC
NOT TO SCALE

TABULATION OF QUANTITIES		
ITEM	UNIT	QUANTITY
POST MOUNTED SIGNS, TYPE A, LOGO	SQ.FT.	
POST MOUNTED SIGNS, TYPE B, LOGO	SQ.FT.	
POST MOUNTED SIGNS, TYPE C, LOGO	SQ.FT.	
BREAKAWAY SYSTEMS	EACH	
* STEEL S OR W BEAM POSTS	LBS.	
LOGO SIGN MOUNTING	EACH	
REMOVAL OF POST MOUNTED MOTORIST SERVICE SIGNS, TYPES A, B, C, E & F	L.S.	

* APPROXIMATE QUANTITY FOR INFORMATION ONLY

SYMBOLS

- ○ *Existing Sign to Remain*
- △ *Existing Sign to be Removed*
- □ *Existing Sign Reset as Shown*
- ● NEW SIGN
- × FUTURE SIGN
- Ø *Existing Utility Pole*

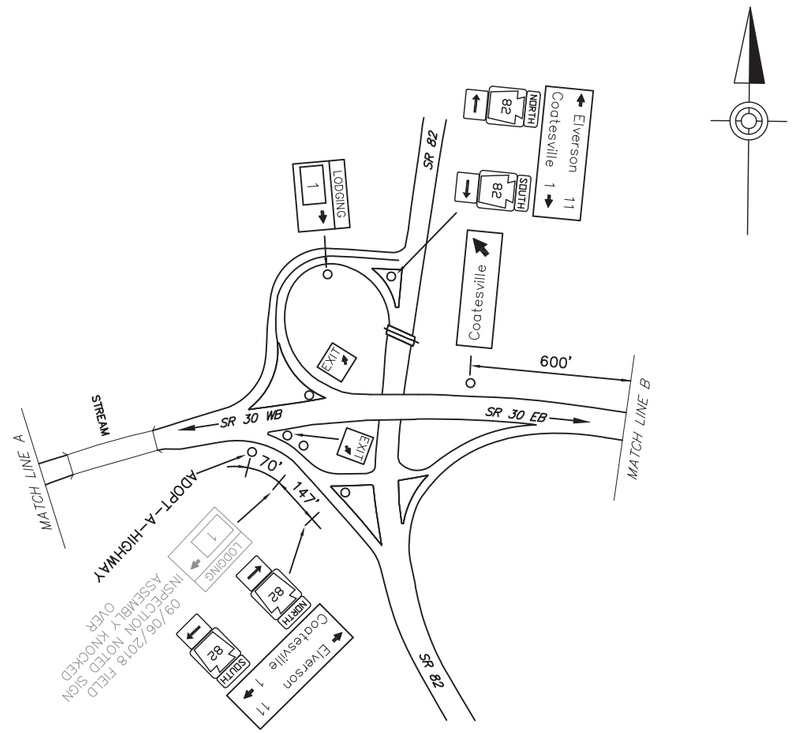

SCHEMATIC PLAN
NOT TO SCALE

WORK ALONG FREEWAY PERMITTED BETWEEN 9:00 AM AND 2:30 PM, UNLESS OTHERWISE APPROVED BY ENGINEERING DISTRICT. DO NOT WORK DURING HOLIDAY. PERIODS IF APPLICABLE, REINSTALL GUIDERAIL AT END OF EACH DAY.

MANOR ROAD SPECIFIC INFORMATION PANEL			
SIGN NUMBER	LEGEND	BUSINESS	LOGO. NO.
30/SR82 L EB 30/SR82 L WB	LODGING	COURTYARD – MARRIOTT	1

EB SIGNS

6'Hx13'W
FUTURE 16'H
W14x30 A572
TYPE IX LEGEND
TYPE III BACKGROUND
B650 – #2, #1

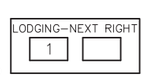

WB SIGNS

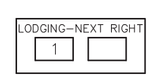

6'Hx13'W
FUTURE 16'H
W14x30 A572
TYPE IX LEGEND
TYPE III BACKGROUND
B650 – #2, #1

30

S.R. 82 MANOR ROAD
COATESVILLE

D:\2015JOBS\2150576-01\HW\PSE\AS-BUILT DRAWINGS\PENNDOT DISTRICT 06\CHESTER - 15\10-XX SHTXX_US30 COATESVILLE EXIT PLAN
September/6/2018 1:33 PM