DISTRICT	COUNTY	ROUTE	PROJECT	SHEET
6-0	CHESTER	US-30		
WEST WHITELAND TOWNSHIP				
REVISIONS				

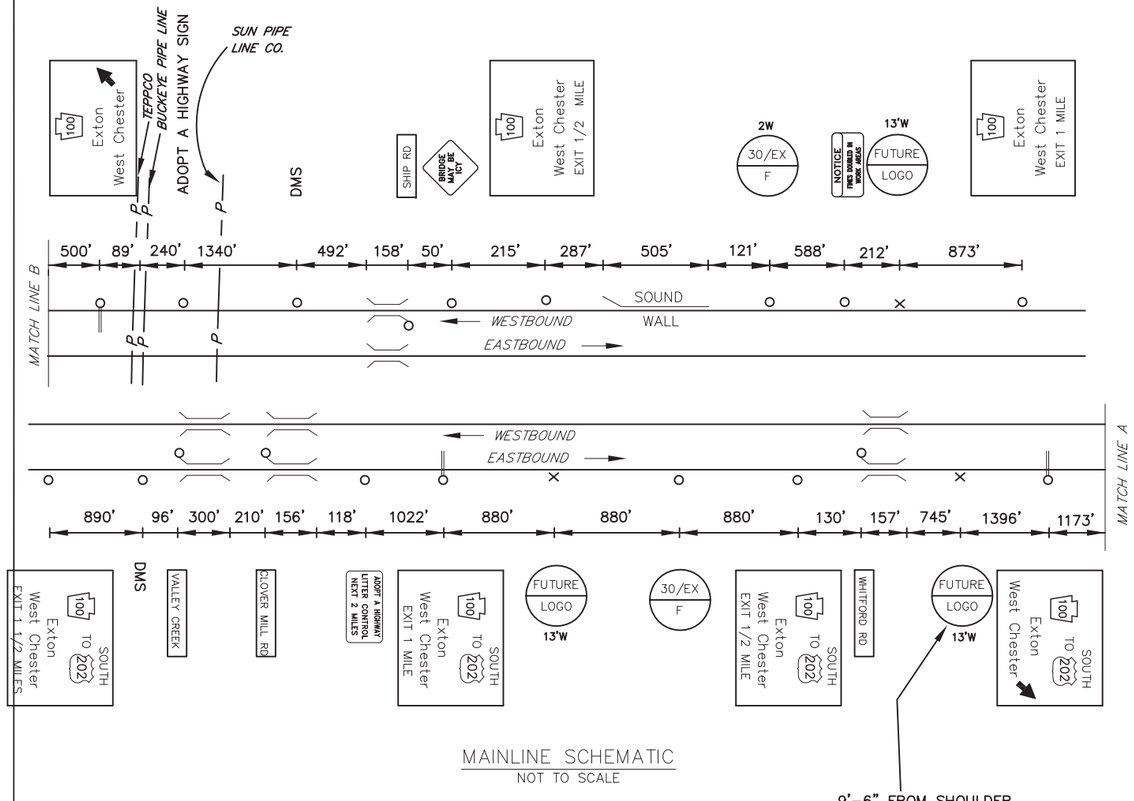

MAINLINE SCHEMATIC
NOT TO SCALE

9'-6" FROM SHOULDER LINE TO CURB. 4'-6" FROM CURB TO EDGE OF GRAVEL. 21'-9" FROM EDGE OF GRAVEL TO ROW FENCE INCLUDING SWALE.

TABULATION OF QUANTITIES		
ITEM	UNIT	QUANTITY
POST MOUNTED SIGNS, TYPE A, LOGO	SQ.FT.	
POST MOUNTED SIGNS, TYPE B, LOGO	SQ.FT.	
POST MOUNTED SIGNS, TYPE C, LOGO	SQ.FT.	
BREAKAWAY SYSTEMS	EACH	
* STEEL S OR W BEAM POSTS	LBS.	
LOGO SIGN MOUNTING	EACH	
REMOVAL OF POST MOUNTED MOTORIST SERVICE SIGNS, TYPES B, C & F	L.S.	

* APPROXIMATE QUANTITY FOR INFORMATION ONLY

SYMBOLS

- ○ *Existing Sign to Remain*
- △ *Existing Sign to be Removed*
- □ *Existing Sign Reset as Shown*
- ● NEW SIGN
- × FUTURE SIGN
- Ø *Existing Utility Pole*

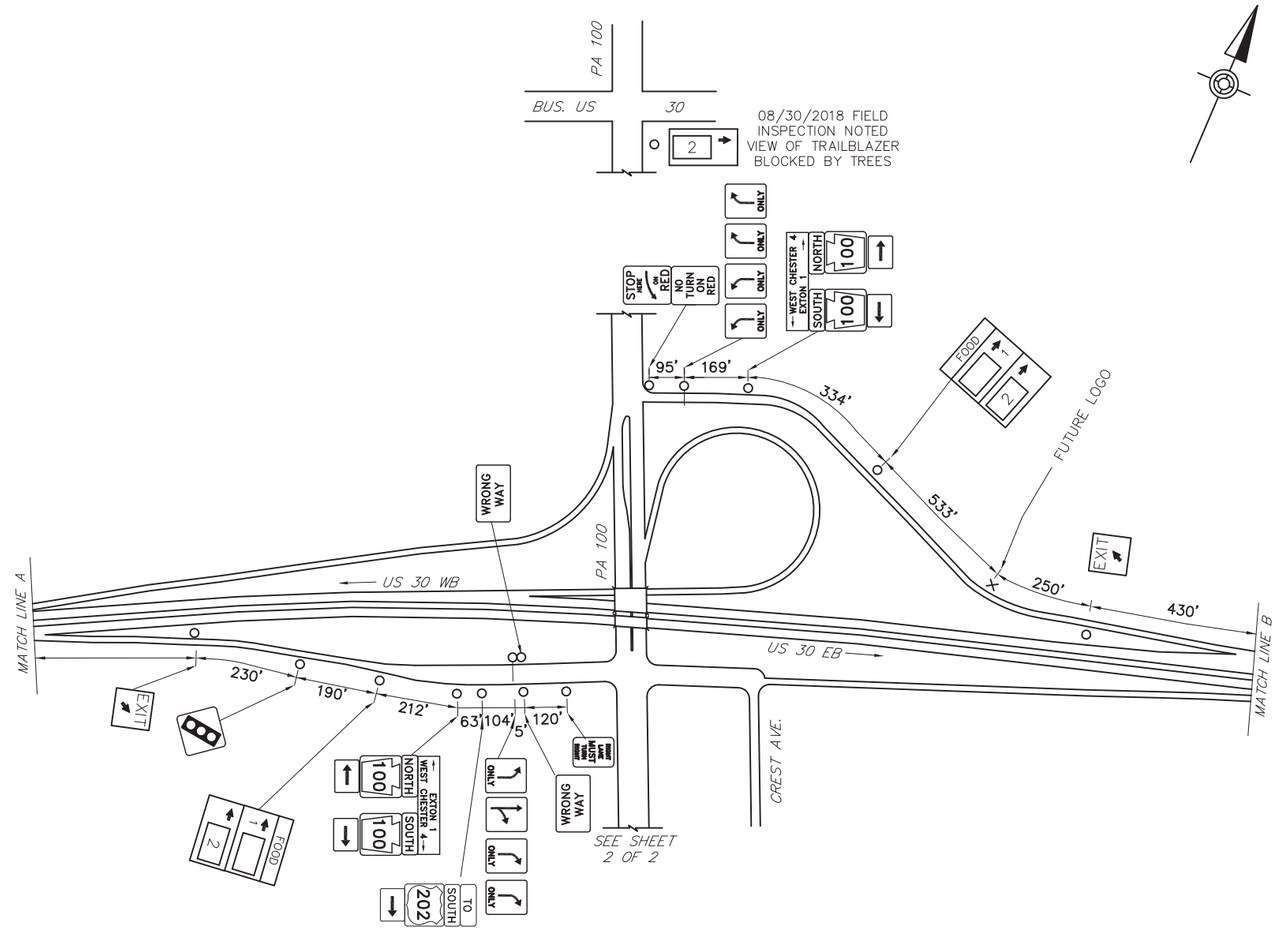

SCHEMATIC PLAN
NOT TO SCALE

EXTON EXIT SPECIFIC INFORMATION PANEL			
SIGN NUMBER	LEGEND	BUSINESS	LOGO. NO.
30/EX F EB	FOOD	STARBUCKS	2
30/EX F WB			

EB SIGNS

6'Hx13'W
FUTURE 16'H
W14x30 A572
B650 – #2, #2

FOOD–NEXT RIGHT
x 2

08/30/2018 FIELD INSPECTION NOTED VIEW OF SIGN BLOCKED BY TREES

WB SIGNS

FOOD–NEXT RIGHT
x 2

6'Hx13'W
FUTURE 16'H
W14x30 A572
B650 – #2, #2

30

PA 100

EXTON

SHEET 1 OF 2

D:\2015_EBS\25076-01\HW\PSE\AS-BUILT DRAWINGS\PENNDOT DISTRICT 06\CHESTER - 15\10-XX SHTXX_US30 EXTON EXIT 1DF2 PLAN
September/6/2018 3:13 PM

DISTRICT	COUNTY	ROUTE	PROJECT	SHEET
6-0	CHESTER	US-30		
WEST WHITELAND TOWNSHIP				
REVISIONS				

TABULATION OF QUANTITIES		
ITEM	UNIT	QUANTITY
POST MOUNTED SIGNS, TYPE A, LOGO	SQ.FT.	
POST MOUNTED SIGNS, TYPE B, LOGO	SQ.FT.	
POST MOUNTED SIGNS, TYPE C, LOGO	SQ.FT.	
BREAKAWAY SYSTEMS	EACH	
* STEEL S OR W BEAM POSTS	LBS.	
LOGO SIGN MOUNTING	EACH	
REMOVAL OF POST MOUNTED MOTORIST SERVICE SIGNS, TYPES B, C & F	L.S.	

* APPROXIMATE QUANTITY FOR INFORMATION ONLY

SYMBOLS

- ○ *Existing Sign to Remain*
- △ *Existing Sign to be Removed*
- □ *Existing Sign Reset as Shown*
- ● NEW SIGN
- × FUTURE SIGN
- Ø *Existing Utility Pole*

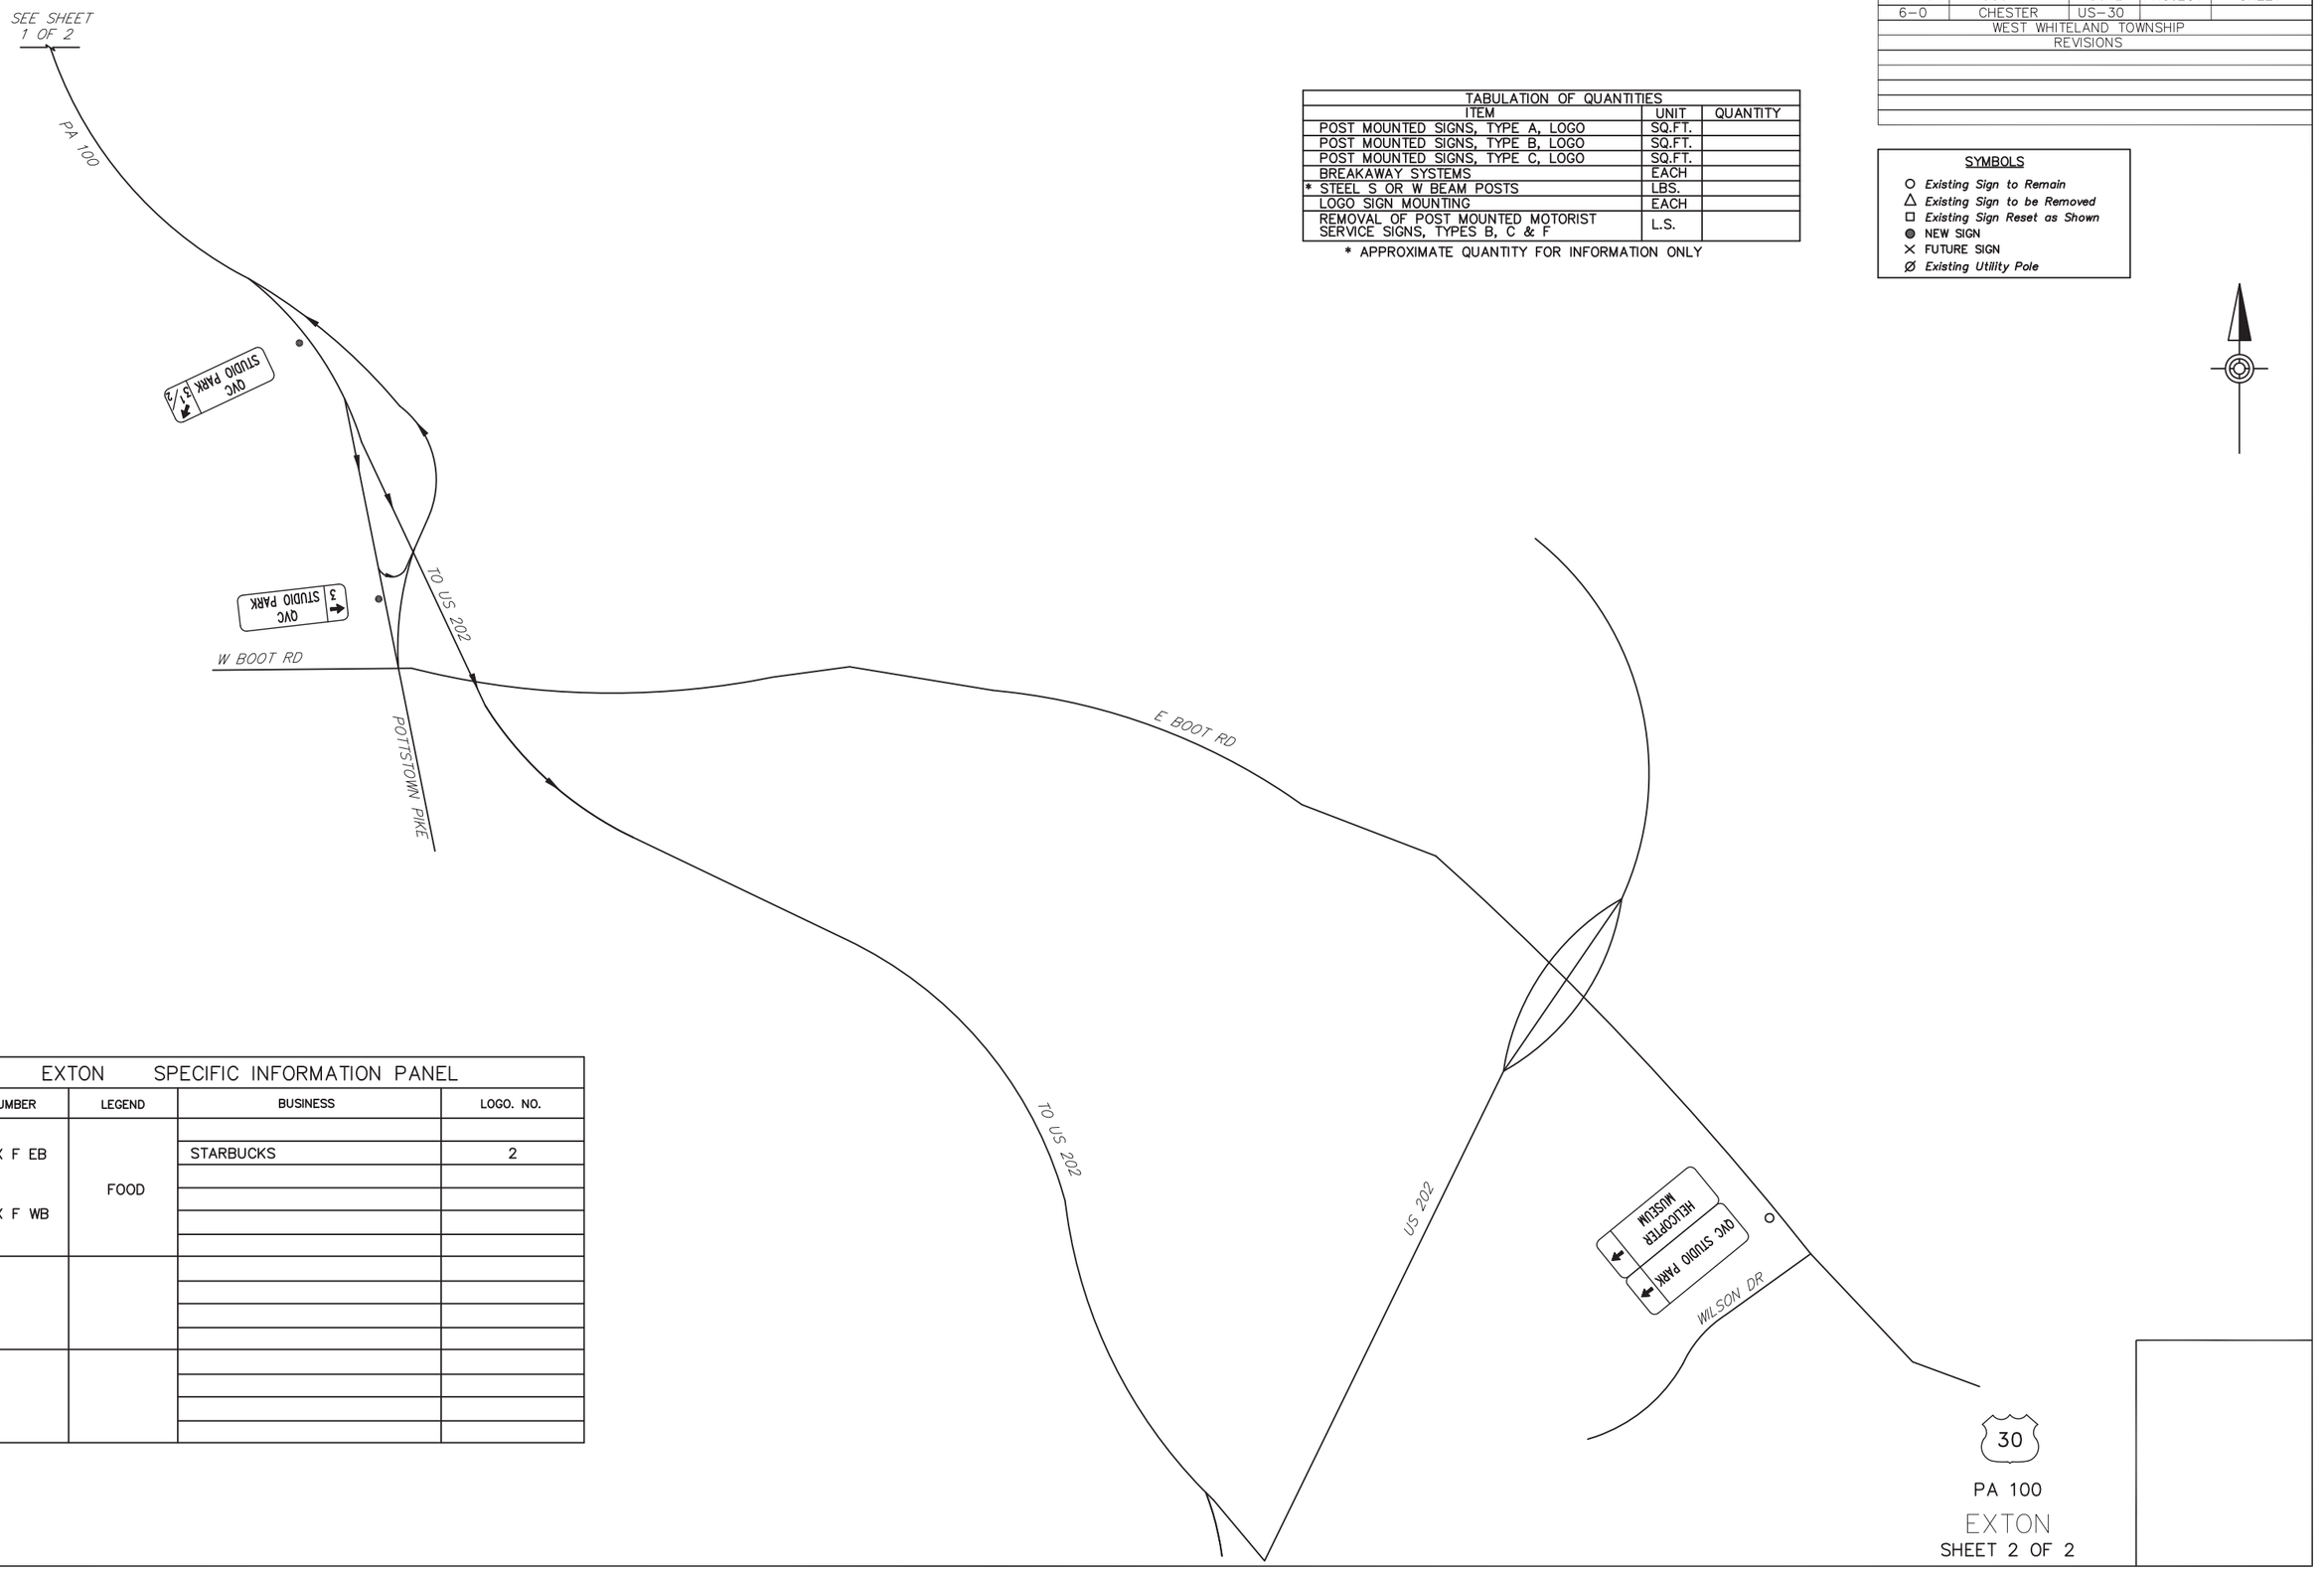

EXTON SPECIFIC INFORMATION PANEL			
SIGN NUMBER	LEGEND	BUSINESS	LOGO. NO.
30/EX F EB 30/EX F WB	FOOD	STARBUCKS	2

SHEET 2 OF 2

D:\2015_JOBS\215076-01\WA\PSE\AS-BUILT DRAWINGS\PENNDOT DISTRICT 06\CHESTER - 15\10-XX SHTXX_US30 EXTON EXIT 1DF8 PLAN
September/6/2018 3:14 PM