DISTRICT	COUNTY	ROUTE	PROJECT	SHEET
6-0	BUCKS	PA-309		
HILLTOWN TOWNSHIP				
REVISIONS				

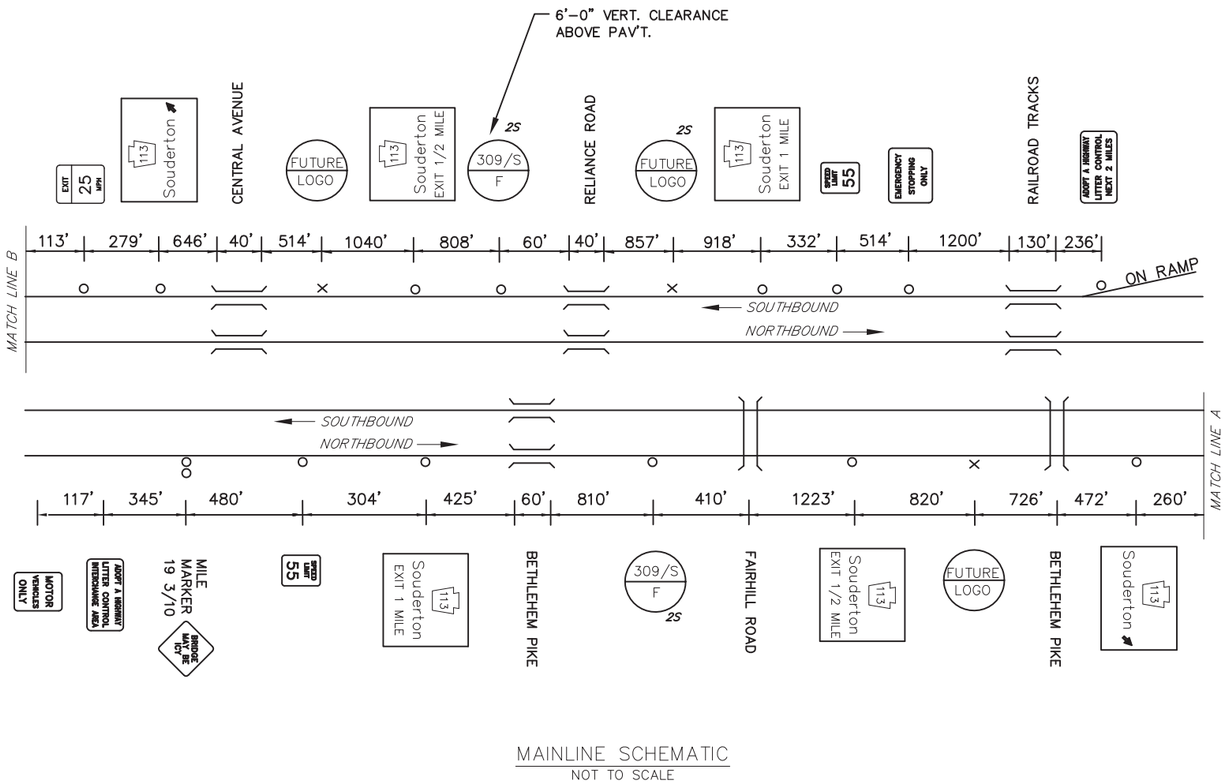

MAINLINE SCHEMATIC
NOT TO SCALE

TABULATION OF QUANTITIES		
ITEM	UNIT	
POST MOUNTED SIGNS, TYPE A, LOGO	SQ.FT.	
POST MOUNTED SIGNS, TYPE B, LOGO	SQ.FT.	
POST MOUNTED SIGNS, TYPE C, LOGO	SQ.FT.	
BREAKAWAY SYSTEMS	EACH	
* STEEL S OR W BEAM POSTS	LBS.	
LOGO SIGN MOUNTING	EACH	
REMOVAL OF POST MOUNTED MOTORIST SERVICE SIGNS, TYPES B, C & F	L.S.	

* APPROXIMATE QUANTITY FOR INFORMATION ONLY

SYMBOLS

- ○ *Existing Sign to Remain*
- △ *Existing Sign to be Removed*
- □ *Existing Sign Reset as Shown*
- ● NEW SIGN
- × FUTURE SIGN
- Ø *Existing Utility Pole*

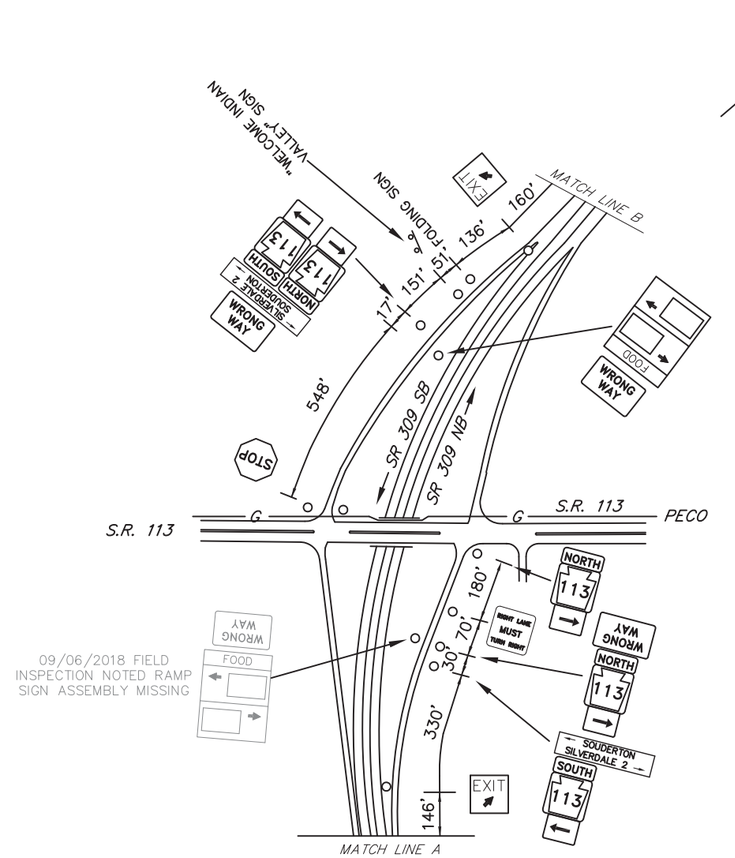

SCHEMATIC PLAN
NOT TO SCALE

LANE RESTRICTIONS:

LANE MAY BE RESTRICTED WEEKDAYS ONLY 9:00 AM TO 3:00 PM.

SOUDERTON SPECIFIC INFORMATION PANEL			
SIGN NUMBER	LEGEND	BUSINESS	LOGO. NO.
309/S F NB 309/S F SB	FOOD		

NB SIGNS

10'Hx13'W
FUTURE 15'H
W14X30
B650 – #2, #1

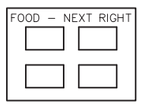

SB SIGNS

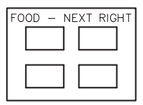

10'Hx13'W
FUTURE 14'H
W14X30
B650 – #2, #2

309
S.R. 113
SOUDERTON

D:\2015.JOBS\215076-01\MX\PSE\AS-BUILT DRAWINGS\PENNDOT DISTRICT 06\BUCKS - 09\10-XX SHTXX-PA-309_SOUDERTON PLAN
September/6/2018 1:20 PM