DISTRICT	COUNTY	ROUTE	PROJECT	SHEET
5-0	NORTHAMPTON	PA-33		

BETHLEHEM TOWNSHIP

REVISIONS

TABULATION OF QUANTITIES		
ITEM	UNIT	
POST MOUNTED SIGNS, TYPE A, LOGO	SQ.FT.	
POST MOUNTED SIGNS, TYPE B, LOGO	SQ.FT.	
POST MOUNTED SIGNS, TYPE C, LOGO	SQ.FT.	
BREAKAWAY SYSTEMS	EACH	
* STEEL S OR W BEAM POSTS	LBS.	
LOGO SIGN MOUNTING	EACH	
REMOVAL OF POST MOUNTED MOTORIST SERVICE SIGNS, TYPES B, C & F	L.S.	–

* APPROXIMATE QUANTITY FOR INFORMATION ONLY

SYMBOLS

- ○ *Existing Sign to Remain*
- △ *Existing Sign to be Removed*
- □ *Existing Sign Reset as Shown*
- ● NEW SIGN
- × FUTURE SIGN
- Ø *Existing Utility Pole*

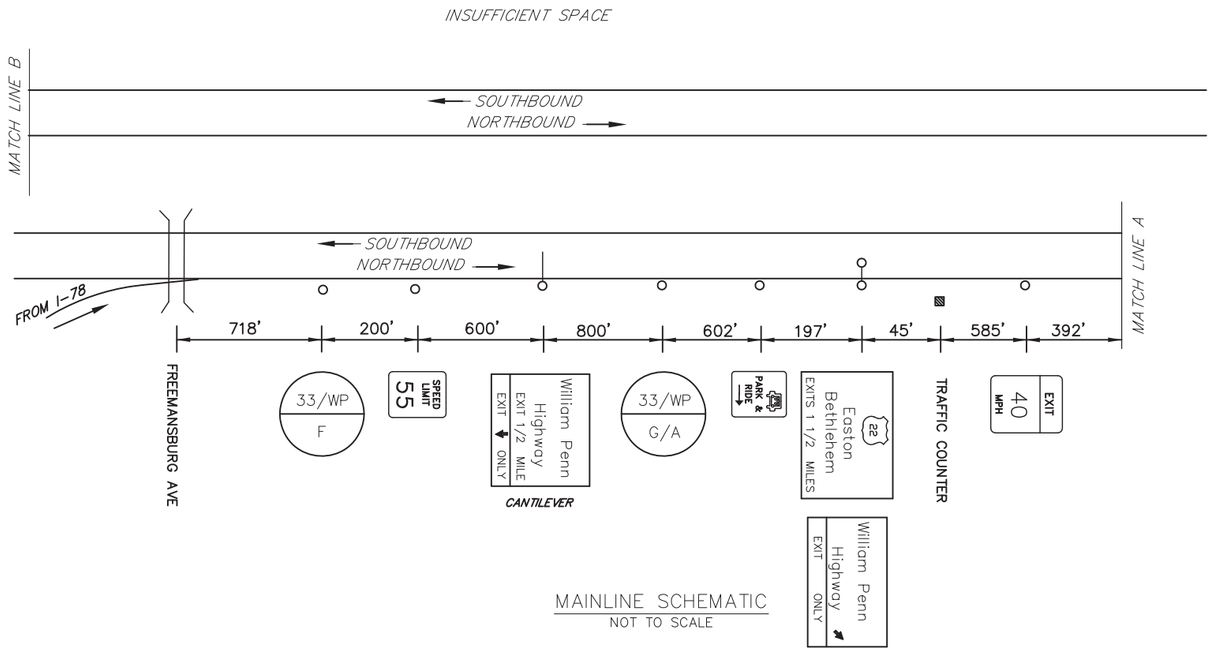

MAINLINE SCHEMATIC
NOT TO SCALE

NO LANE CLOSURES BETWEEN
6:00 AM & 9:00 AM AND
3:00 PM & 6:00 PM.
NO WORK PERMITTED DURING
HOLIDAY PERIODS.

WILLIAM PENN HWY. SPECIFIC INFORMATION PANEL			
SIGN NUMBER	LEGEND	BUSINESS	LOGO. NO.
33/WP A NB	ATTRACTION	NORTHAMPTON COMMUNITY COLLLEGE	1
		GREEN POND GOLF COURSE	3
33/WP G NB	GAS	SUNOCO (Diesel/24 Hours)	2
33/WP F NB	FOOD	MARBLEHEAD CHOWDER HOUSE	4

NB SIGNS

12'Hx19'W
FUTURE 16'H
W12x26 A572
3M TYPE III
B650 – #2, #3

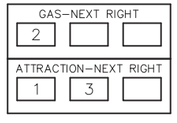

6'Hx19'W
FUTURE 12'H
W10x26 A572
3M TYPE III
B650 – #4 #4

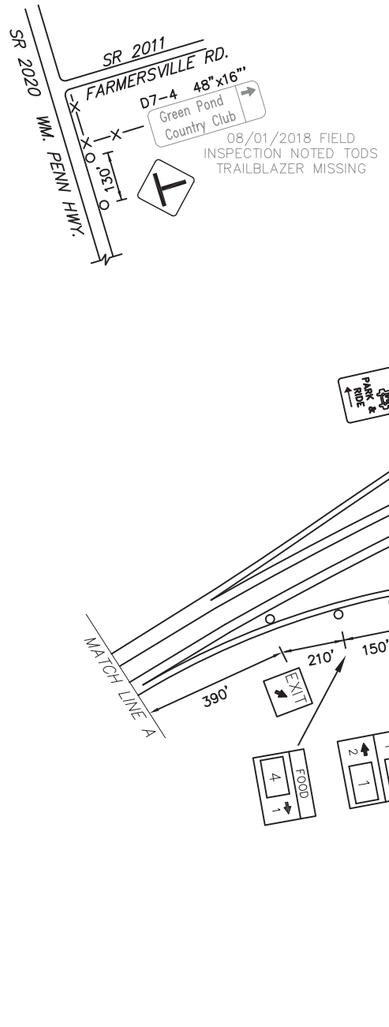

SCHEMATIC PLAN
NOT TO SCALE

33

SR 2020

WILLIAM PENN HWY.

D:\2015_JOBS\215076-01\HW\PSE\AS-BUILT DRAWINGS\PENNDOT DISTRICT 05\NORTHAMPTON - 4R\0-XX SHTXX-33_EXIT WILLIAM PENN HWY
August/13/2018 10:25 AM