DISTRICT	COUNTY	ROUTE	PROJECT	SHEET
12-0	WESTMORELAND	I-70		

SEWICKLEY TOWNSHIP
REVISIONS

TABULATION OF QUANTITIES		
ITEM	UNIT	QUANTITY
POST MOUNTED SIGNS, TYPE A, LOGO	SQ.FT.	
POST MOUNTED SIGNS, TYPE B, LOGO	SQ.FT.	
POST MOUNTED SIGNS, TYPE C, LOGO	SQ.FT.	
BREAKAWAY SYSTEMS	EACH	
* STEEL S OR W BEAM POSTS	LBS.	
LOGO SIGN MOUNTING	EACH	
REMOVAL OF POST MOUNTED MOTORIST SERVICE SIGNS, TYPES B, C & F	L.S.	1

* APPROXIMATE QUANTITY FOR INFORMATION ONLY

SYMBOLS

- ○ *Existing Sign to Remain*
- △ *Existing Sign to be Removed*
- □ *Existing Sign Reset as Shown*
- ● NEW SIGN
- × FUTURE SIGN
- Ø *Existing Utility Pole*

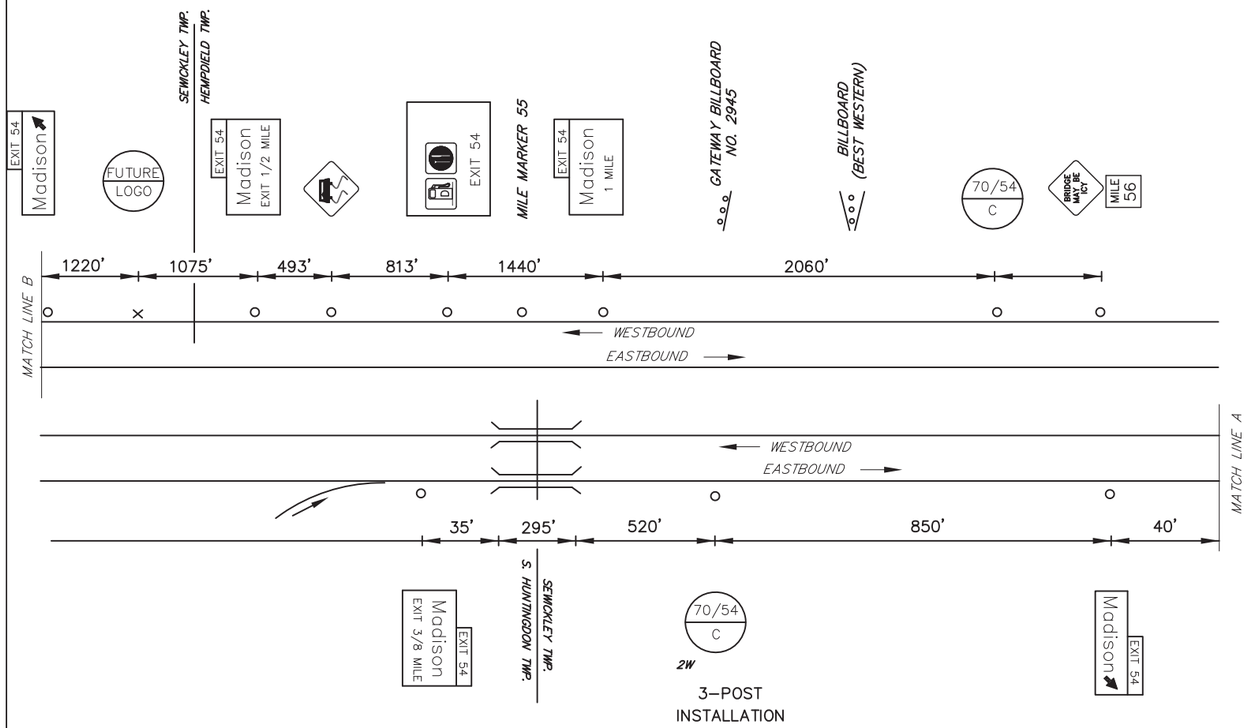

MAINLINE SCHEMATIC
NOT TO SCALE

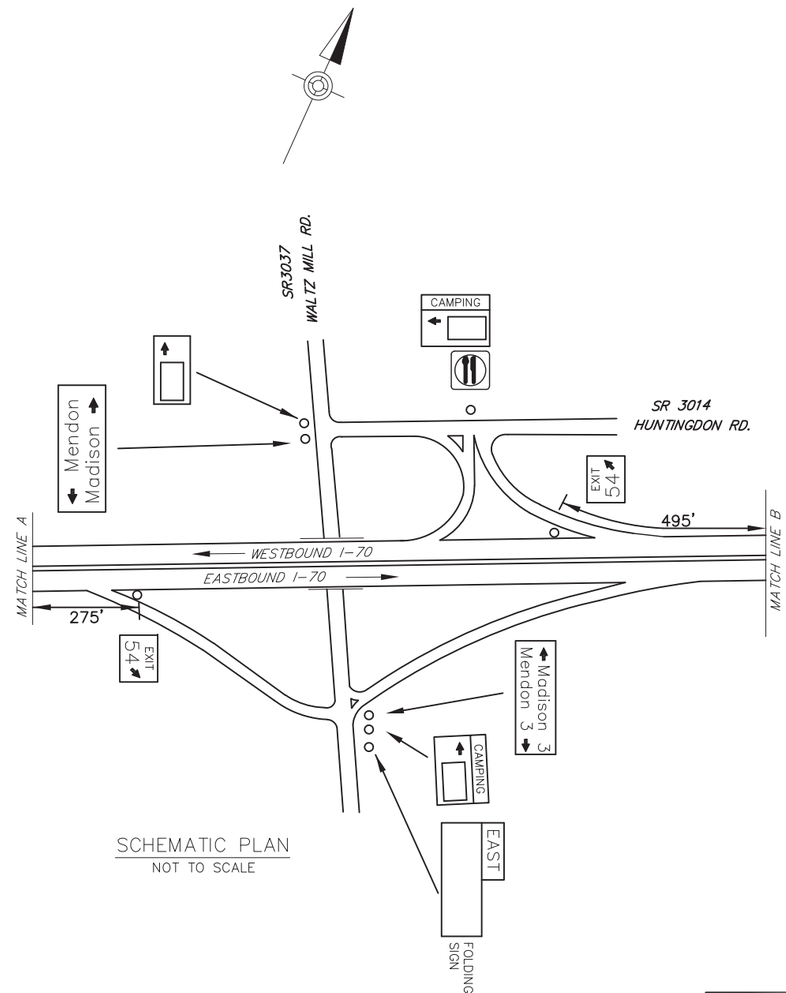

SCHEMATIC PLAN
NOT TO SCALE

EXIT 54 SPECIFIC INFORMATION PANEL			
SIGN NUMBER	LEGEND	BUSINESS	LOGO. NO.
70/54 C EB 70/54 C WB	CAMPING		

EB SIGNS

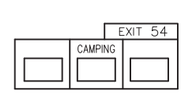

MAIN PANEL 6'H x 19'W
+ EXIT PANEL
FUTURE DESIGN HEIGHT
FOR MAIN PANEL = 8'

W12x26
B650 – #1, #1, #1
3-POST INSTALLATION

WB SIGNS

6'Hx13'W
FUTURE 16'H
W14x30 A572
3M TYPE III
B650 – #2, #2

INTERSTATE 70
MADISON
EXIT 54

\\DAVPROJ01\PROJECTS\2015_IDBS\215076-01\HW\PSE\AS-BUILT DRAWINGS\PENNDOT DISTRICT 12\WESTMORELAND - 64\10-XX SHTXX-170_EXIT 54 PLAN
July 12/2018 12:52 PM