DISTRICT	COUNTY	ROUTE	PROJECT	SHEET
5-0	NORTHAMPTON	I-78		

GLENDON BOROUGH & WILLIAMS TOWNSHIP

REVISIONS

TABULATION OF QUANTITIES		
ITEM	UNIT	QUANTITY
POST MOUNTED SIGNS, TYPE A, LOGO	SQ.FT.	–
POST MOUNTED SIGNS, TYPE B, LOGO	SQ.FT.	–
POST MOUNTED SIGNS, TYPE C, LOGO	SQ.FT.	–
BREAKAWAY SYSTEMS	EACH	–
* STEEL S OR W BEAM POSTS	LBS.	–
LOGO SIGN MOUNTING	EACH	–
FLAT SHEET PANEL REPLACEMENT	SQ. FT.	–
EXTRUDED PANEL REPLACEMENT	SQ. FT.	
REMOVAL OF POST MOUNTED MOTORIST SERVICE SIGNS, TYPES B, C & F	L.S.	–

* APPROXIMATE QUANTITY FOR INFORMATION ONLY

SYMBOLS

- ○ *Existing Sign to Remain*
- △ *Existing Sign to be Removed*
- □ *Existing Sign Reset as Shown*
- ● NEW SIGN
- × FUTURE SIGN
- Ø *Existing Utility Pole*

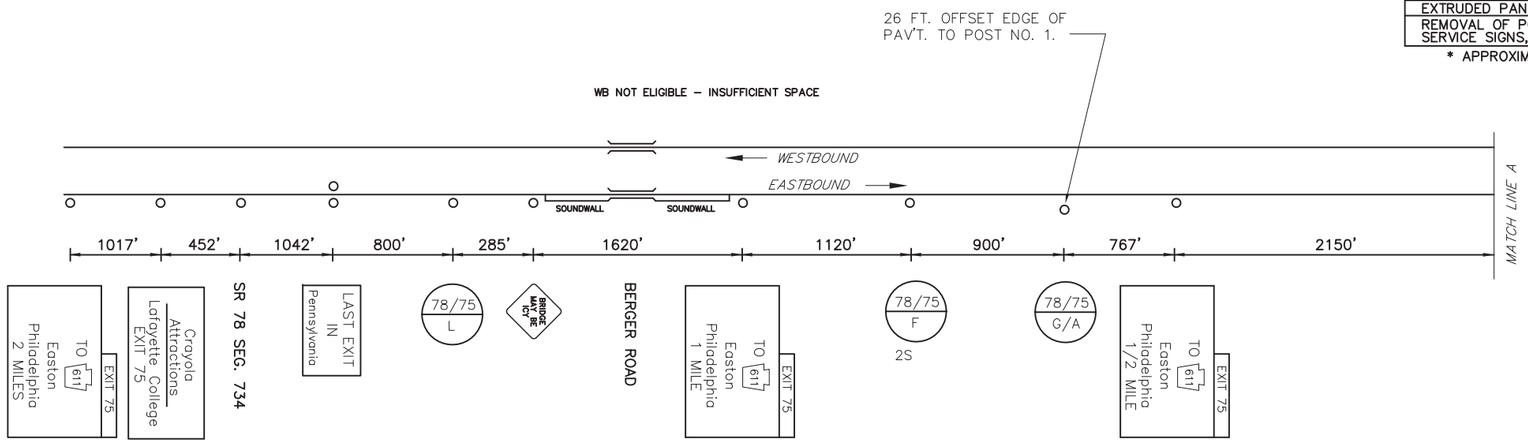

MAINLINE SCHEMATIC
NOT TO SCALE

DO NOT CLOSE OR RESTRICT TRAVEL LANES
BETWEEN 6:00 am AND 9:00 AM, AND
BETWEEN 3:00 PM AND 6:00 PM, MONDAY THRU FRIDAY.
DO NOT WORK DURING HOLIDAY PERIODS.

EXIT 75 SPECIFIC INFORMATION PANEL			
SIGN NUMBER	LEGEND	BUSINESS	LOGO. NO.
78/75 L EB	LODGING		
78/75 F EB	FOOD	McDONALD'S	2
		SUBWAY	4
		DUNKIN DONUTS	5
78/75 G EB	GAS	TURKEY HILL	3
78/75 A EB	ATTRACTION	THE CLUB AT MORGAN HILL	6

EB SIGNS

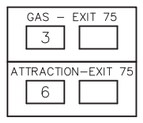

12'Hx13'W
FUTURE 16'H
W12x26 A572
3M TYPE III
B650 – #1, #1

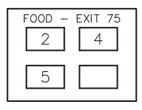

10'Hx13'W
FUTURE 14'H
W14x30 A572
3M TYPE III
B650 – #1, #1

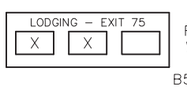

6'Hx19'W
FUTURE 10'H
W8x21 A572
3M TYPE III
B525 – #2, #2

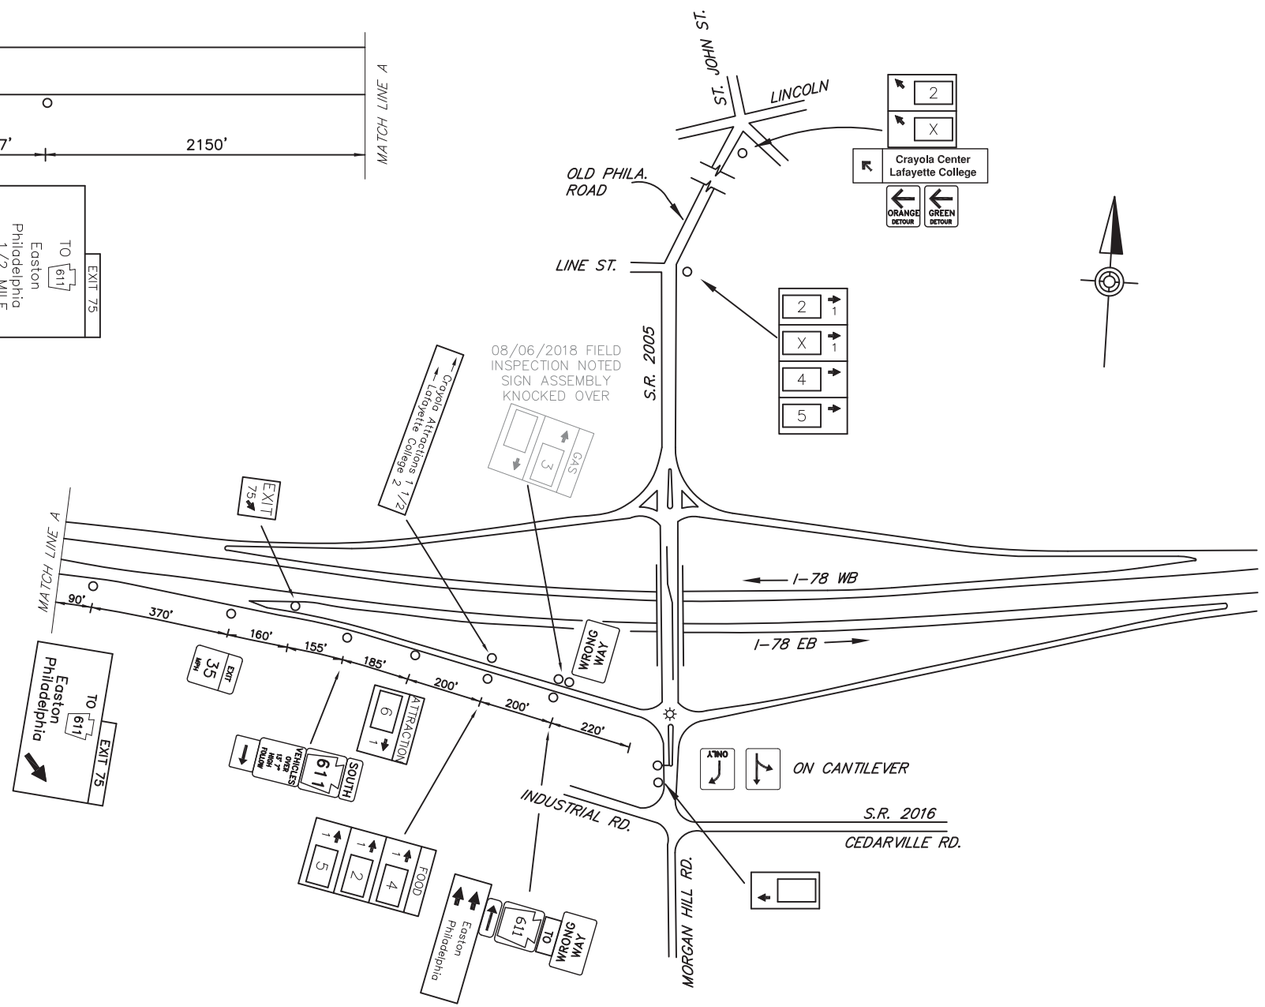

SCHEMATIC PLAN
NOT TO SCALE

INTERSTATE 78

EASTON (TO SR 611)

EXIT 75

D:\2015_ID\85\215076-01\HV\PSE\AS-BUILT DRAWINGS\PENNDOT DISTRICT 05\NORTHAMPTON - 481/0-XX SHTXX_I78_EXIT 75 PLAN
August/10/2018 4:45 PM