DISTRICT	COUNTY	ROUTE	PROJECT	SHEET
10-0	BUTLER	I-79		
11-0	LAWRENCE			
WORTH TWP. (BUTLER CO.) & PLAIN GROVE TWP. (LAWRENCE CO.)				
REVISIONS				

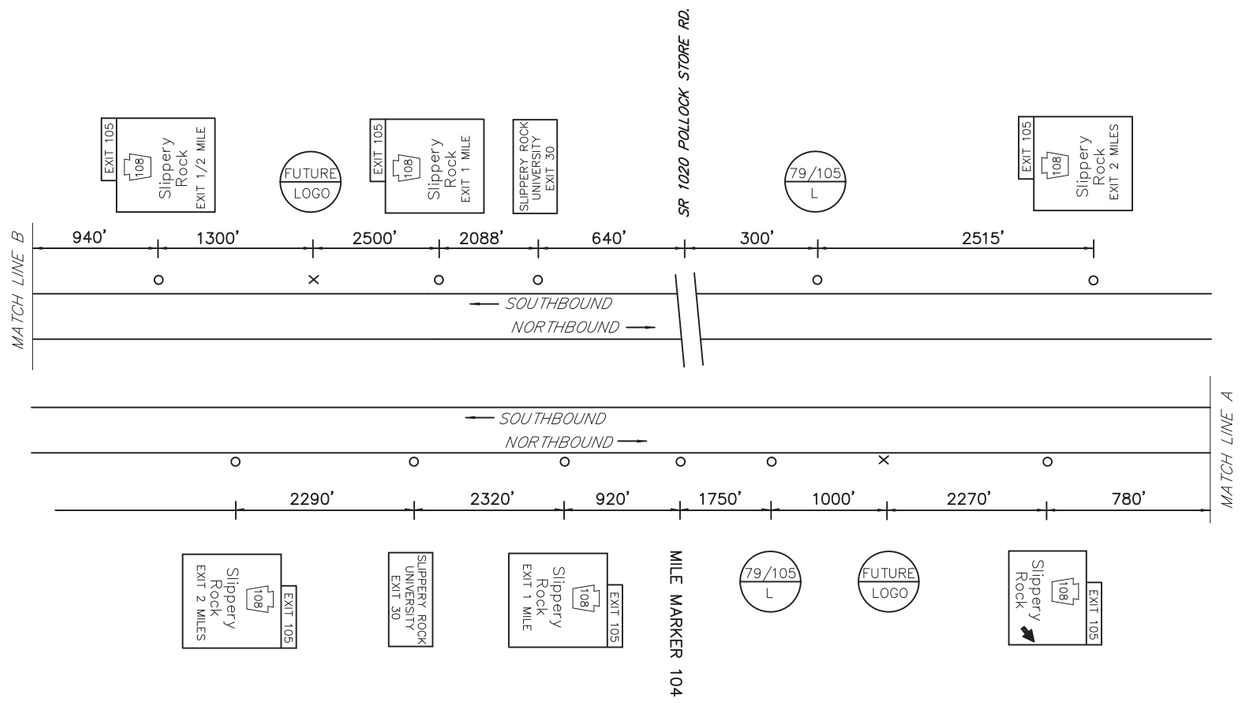

MAINLINE SCHEMATIC
NOT TO SCALE

TABULATION OF QUANTITIES		
ITEM	UNIT	QUANTITY
POST MOUNTED SIGNS, TYPE A, LOGO	SQ.FT.	-
POST MOUNTED SIGNS, TYPE B, LOGO	SQ.FT.	-
POST MOUNTED SIGNS, TYPE C, LOGO	SQ.FT.	-
BREAKAWAY SYSTEMS	EACH	-
* STEEL S OR W BEAM POSTS	LBS.	-
LOGO SIGN MOUNTING	EACH	-
FLAT SHEET PANEL REPLACEMENT	SQ. FT.	
EXTRUDED PANEL REPLACEMENT	SQ. FT.	
REMOVAL OF POST MOUNTED MOTORIST SERVICE SIGNS, TYPES B, C & F	L.S.	

* APPROXIMATE QUANTITY FOR INFORMATION ONLY

SYMBOLS
- Existing Sign to Remain
- Existing Sign to be Removed
- Existing Sign Reset as Shown
- NEW SIGN
- FUTURE SIGN
- Existing Utility Pole

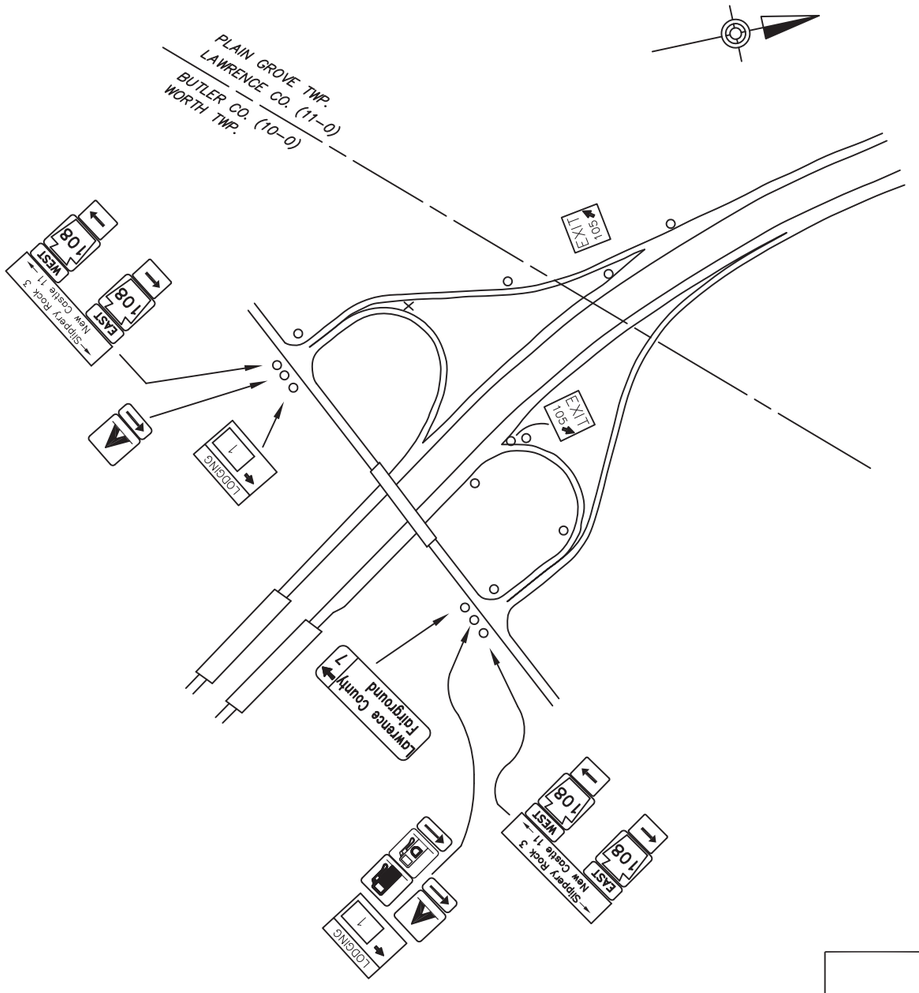

SCHEMATIC PLAN
NOT TO SCALE

EXIT 105 SPECIFIC INFORMATION PANEL			
SIGN NUMBER	LEGEND	BUSINESS	LOGO. NO.
79/105 L NB 79/105 L SB	LODGING	EVENING STAR MOTEL	1

NB SIGNS

6'Hx13'W
FUTURE 12'H
W8x21
3M TYPE III
B525 - #1, #1
POST 1 NEEDS REPLACED

LODGING-EXIT 105
1

SB SIGNS

LODGING-EXIT 105
1

6'Hx13'W
W6x12
3M TYPE III
B525 - #2, #2

INTERSTATE 79

SLIPPERY ROCK
EXIT 105

D:\2015_JOBS\215076-01\Viz\PSE\AS-BUILT DRAWINGS\PENNDOT DISTRICT 10\BUTLER - 10\10-XX SHTXX-179_EXIT 105 PLAN
September/4/2018 4:08 PM