DISTRICT	COUNTY	ROUTE	PROJECT	SHEET
1-0	MERCER	I-79		
JACKSON TOWNSHIP				
REVISIONS				

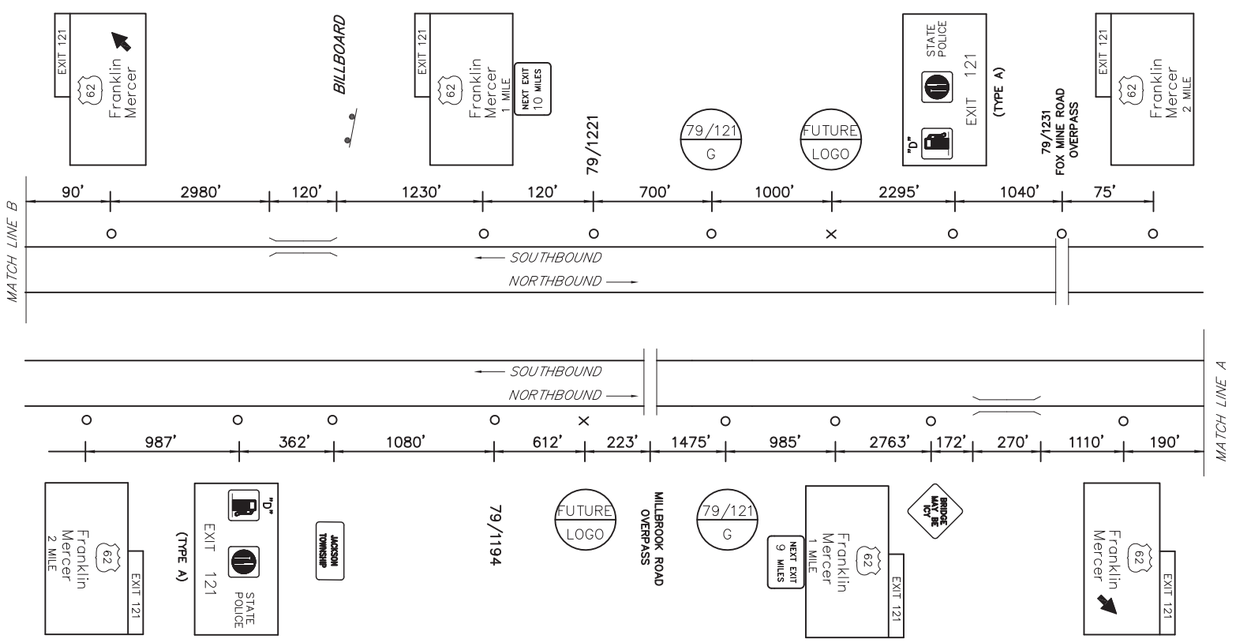

MAINLINE SCHEMATIC
NOT TO SCALE

TABULATION OF QUANTITIES		
ITEM	UNIT	QUANTITY
POST MOUNTED SIGNS, TYPE A, LOGO	SQ.FT.	–
POST MOUNTED SIGNS, TYPE B, LOGO	SQ.FT.	–
BREAKAWAY SYSTEMS	EACH	–
* STEEL S OR W BEAM POSTS	LBS.	–
LOGO SIGN MOUNTING	EACH	–
FLAT SHEET PANEL REPLACEMENT	SQ. FT.	–
EXTRUDED PANEL REPLACEMENT	SQ. FT.	–
REMOVAL OF POST MOUNTED MOTORIST SERVICE SIGNS, TYPES B, C & F	L.S.	

* APPROXIMATE QUANTITY FOR INFORMATION ONLY

SYMBOLS

- ○ *Existing Sign to Remain*
- △ *Existing Sign to be Removed*
- □ *Existing Sign Reset as Shown*
- ● NEW SIGN
- × FUTURE SIGN
- Ø *Existing Utility Pole*

NB SIGNS

6'Hx19'W
FUTURE 12'H
W12x26 A572
B650 – #2, #1

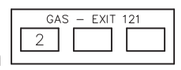

SB SIGNS

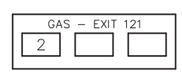

6'Hx19'W
FUTURE 12'H
W12x26 A572
TYPE III
B650 – #2, #2

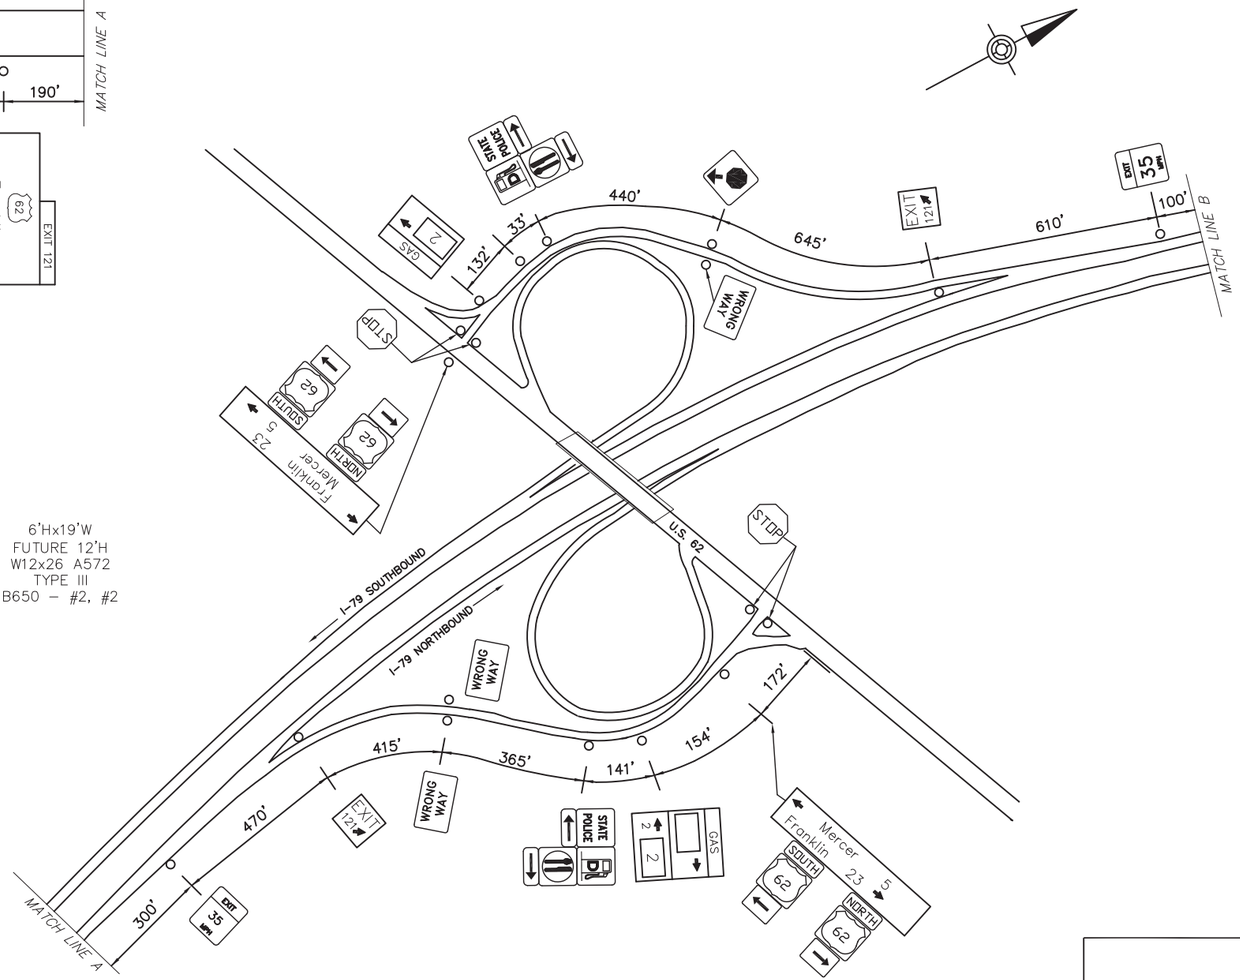

SCHEMATIC PLAN
NOT TO SCALE

EXIT 121 SPECIFIC INFORMATION PANEL			
SIGN NUMBER	LEGEND	BUSINESS	LOGO. NO.
79/121 G NB 79/121 G SB	GAS	SUNOCO (DIESEL)	2

INTERSTATE 79

MERCER/FRANKLIN

EXIT 121

D:\2015JOBS\215076-01\HW\PSE\AS-BUILT DRAWINGS\PENNDOT DISTRICT 01\MERCER - 43\10-XX SHT XX I-79_EXIT 121 PLAN
September/4/2018 4:59 PM