DISTRICT	COUNTY	ROUTE	PROJECT	SHEET
2-0	CLEARFIELD	I-80		1 OF 3
BRADFORD & LAWRENCE TOWNSHIPS AND BORO OF CURWENSVILLE				
REVISIONS				

TABULATION OF QUANTITIES		
ITEM	UNIT	QUANTITY
POST MOUNTED SIGNS, TYPE A, LOGO	SQ.FT.	-
POST MOUNTED SIGNS, TYPE B, LOGO	SQ.FT.	-
POST MOUNTED SIGNS, TYPE C, LOGO	SQ.FT.	-
BREAKAWAY SYSTEMS	EACH	-
* STEEL S OR W BEAM POSTS	LBS.	-
LOGO SIGN MOUNTING	EACH	-
FLAT SHEET PANEL REPLACEMENT	SQ.FT.	
EXTRUDED PANEL REPLACEMENT	SQ.FT.	
REMOVAL OF POST MOUNTED MOTORIST SERVICE SIGNS, TYPES B, C & F	L.S.	

* APPROXIMATE QUANTITY FOR INFORMATION ONLY

SYMBOLS

- ○ *Existing Sign to Remain*
- △ *Existing Sign to be Removed*
- □ *Existing Sign Reset as Shown*
- ○ NEW SIGN
- × FUTURE SIGN
- Ø *Existing Utility Pole*

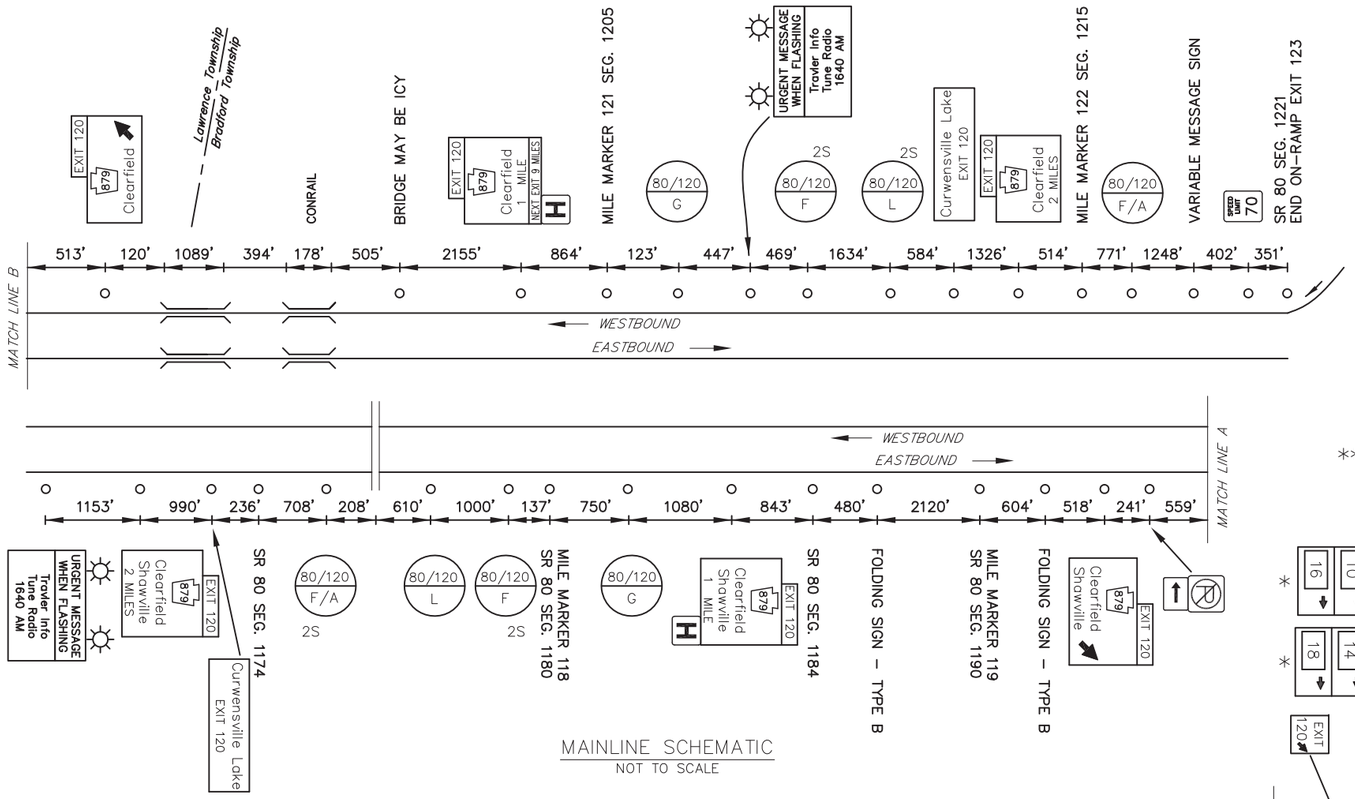

MAINLINE SCHEMATIC
NOT TO SCALE

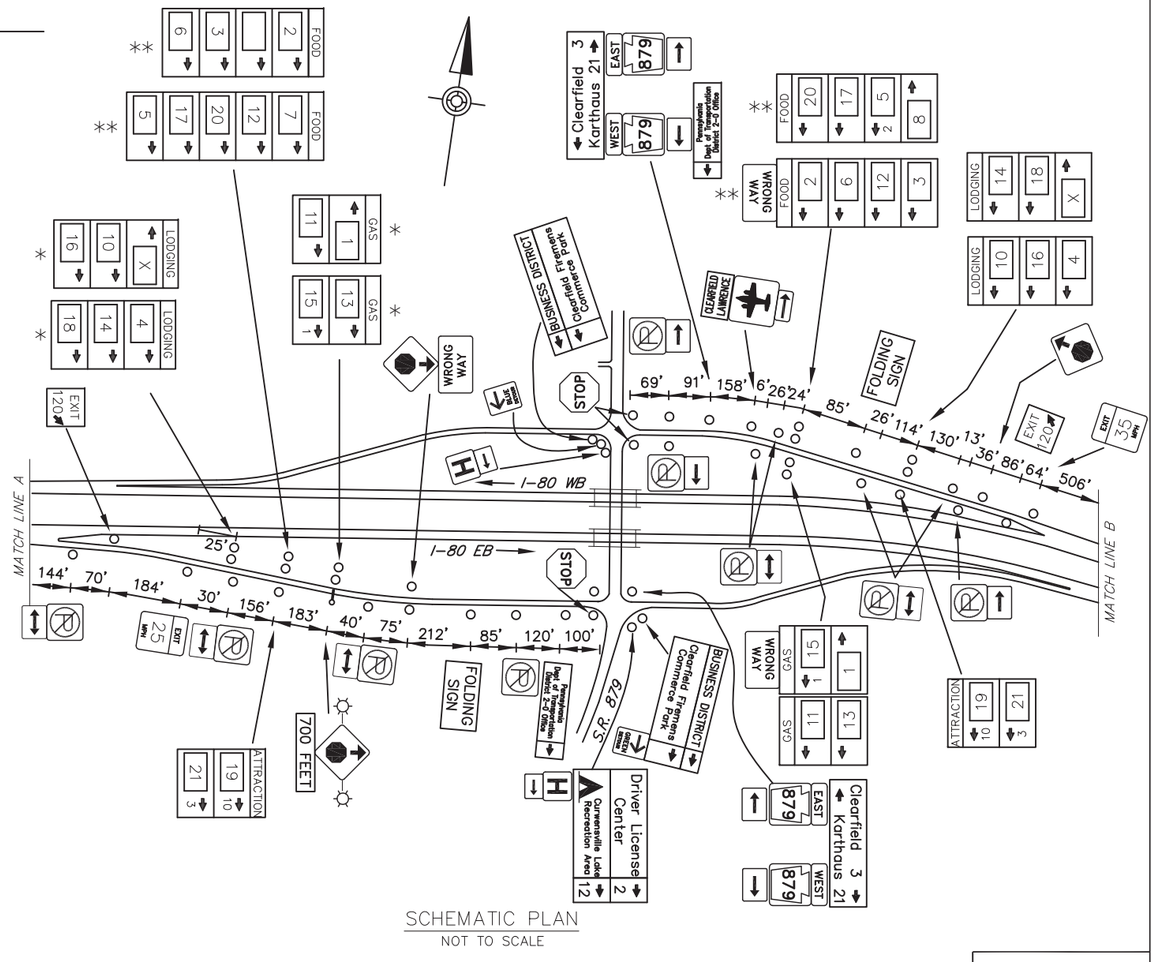

SCHEMATIC PLAN
NOT TO SCALE

* SQUARE POSTS IN USE PER PENNDOT RESET

** MOD. TYPE C 6"x6" WOOD POST

EXIT 120 SPECIFIC INFORMATION PANEL			
SIGN NUMBER	LEGEND	BUSINESS	LOGO. NO.
80/120 G EB 80/120 G WB	GAS	SAPP BROS. (OPEN 24 HOURS)	1
		BP	11
		SNAPPYS	13
		SHEETZ	15
80/120 F EB 80/120 F WB	FOOD	McDONALD'S (24 HOURS)	2
		KFC	3
		LONG JOHN SILVER'S	5
		DUTCH PANTRY NO. 78	6
		BURGER KING	7
		AUNT LU'S CAFE	8
		ARBY'S NO. 6229	12
		THE MEADOWS	17
		DUNKIN' DONUTS	20
80/120 L EB 80/120 L WB	LODGING	BEST WESTERN - PLUS	4
		SUPER 8	10
		COMFORT INN	14
		HOLIDAY INN EXPRESS & SUITES	16
		HAMPTON INN	18
80/120 A EB 80/120 A WB	ATTRACTION	STARR HILL WINERY	19
		LOCK HAVEN UNIVERSITY-CLEARFIELD CAMPUS	21

EB SIGNS
PROPOSED

10'Hx13'W FUTURE 14'H W8x18 A572 3M TYPE III B525 - BURIED, #1
GAS-EXIT 120: 1 11 / 13 15

10'Hx19'W W12x26 A572 3M TYPE III B650 - #2, #1
FOOD - EXIT 120: 2 6 12 / 3 X 7

14'Hx13'W W14x30 A572 3M TYPE III B650 - #2, #2
LODGING - EXIT 120: X 4 / 10 14 / 16 18

16'Hx13'W W10x22 A572 TYPE IX LEGEND TYPE III BACKGROUND B650 - #2, #2
FOOD - EXIT 120: 20 5 / 17
ATTRACTION-EXIT 120: 19 21

WB SIGNS
PROPOSED

GAS-EXIT 120: 1 11 / 13 15

10'Hx13'W FUTURE 12'H W6x15 A572 3M TYPE III BRACKETS - SBBK5M2, SBBK53

FOOD - EXIT 120: 8 2 6 / 12 3 5

10'Hx19'W W10x22 A572 3M TYPE III B650 - #2, #1

LODGING - EXIT 120: X 10 / 14 16 / 4 18

14'Hx13'W W10x22 A572 3M TYPE III B650 - #2, #1

FOOD - EXIT 120: 20 17
ATTRACTION-EXIT 120: 19 21

12'Hx13'W FUTURE 18'H W18x40 A572 TYPE IX LEGEND TYPE III BACKGROUND B650 - #2, #2

INTERSTATE 80

CLEARFIELD
EXIT 120
SHEET 1 OF 3

D:\2015\2DB\215076-01\MVPSE\AS-BUILT DRAWINGS\PENNDOT DISTRICT 2\0\CLEARFIELD - 17\10-XX SHTXX-I80_EXIT 120 PLAN
August 16, 2018 4:21 PM

DISTRICT	COUNTY	ROUTE	PROJECT	SHEET
2-0	CLEARFIELD	I-80		2 OF 3
BRADFORD & LAWRENCE TOWNSHIPS AND BORO OF CURWENSVILLE				
REVISIONS				

TABULATION OF QUANTITIES		
ITEM	UNIT	QUANTITY
POST MOUNTED SIGNS, TYPE A, LOGO	SQ.FT.	–
POST MOUNTED SIGNS, TYPE B, LOGO	SQ.FT.	–
POST MOUNTED SIGNS, TYPE C, LOGO	SQ.FT.	–
BREAKAWAY SYSTEMS	EACH	–
* STEEL S OR W BEAM POSTS	LBS.	–
LOGO SIGN MOUNTING	EACH	–
FLAT SHEET PANEL REPLACEMENT	SQ.FT.	
EXTRUDED PANEL REPLACEMENT	SQ.FT.	
REMOVAL OF POST MOUNTED MOTORIST SERVICE SIGNS, TYPES B, C & F	L.S.	1

* APPROXIMATE QUANTITY FOR INFORMATION ONLY

SYMBOLS

- ○ *Existing Sign to Remain*
- △ *Existing Sign to be Removed*
- □ *Existing Sign Reset as Shown*
- ● NEW SIGN
- × FUTURE SIGN
- Ø *Existing Utility Pole*

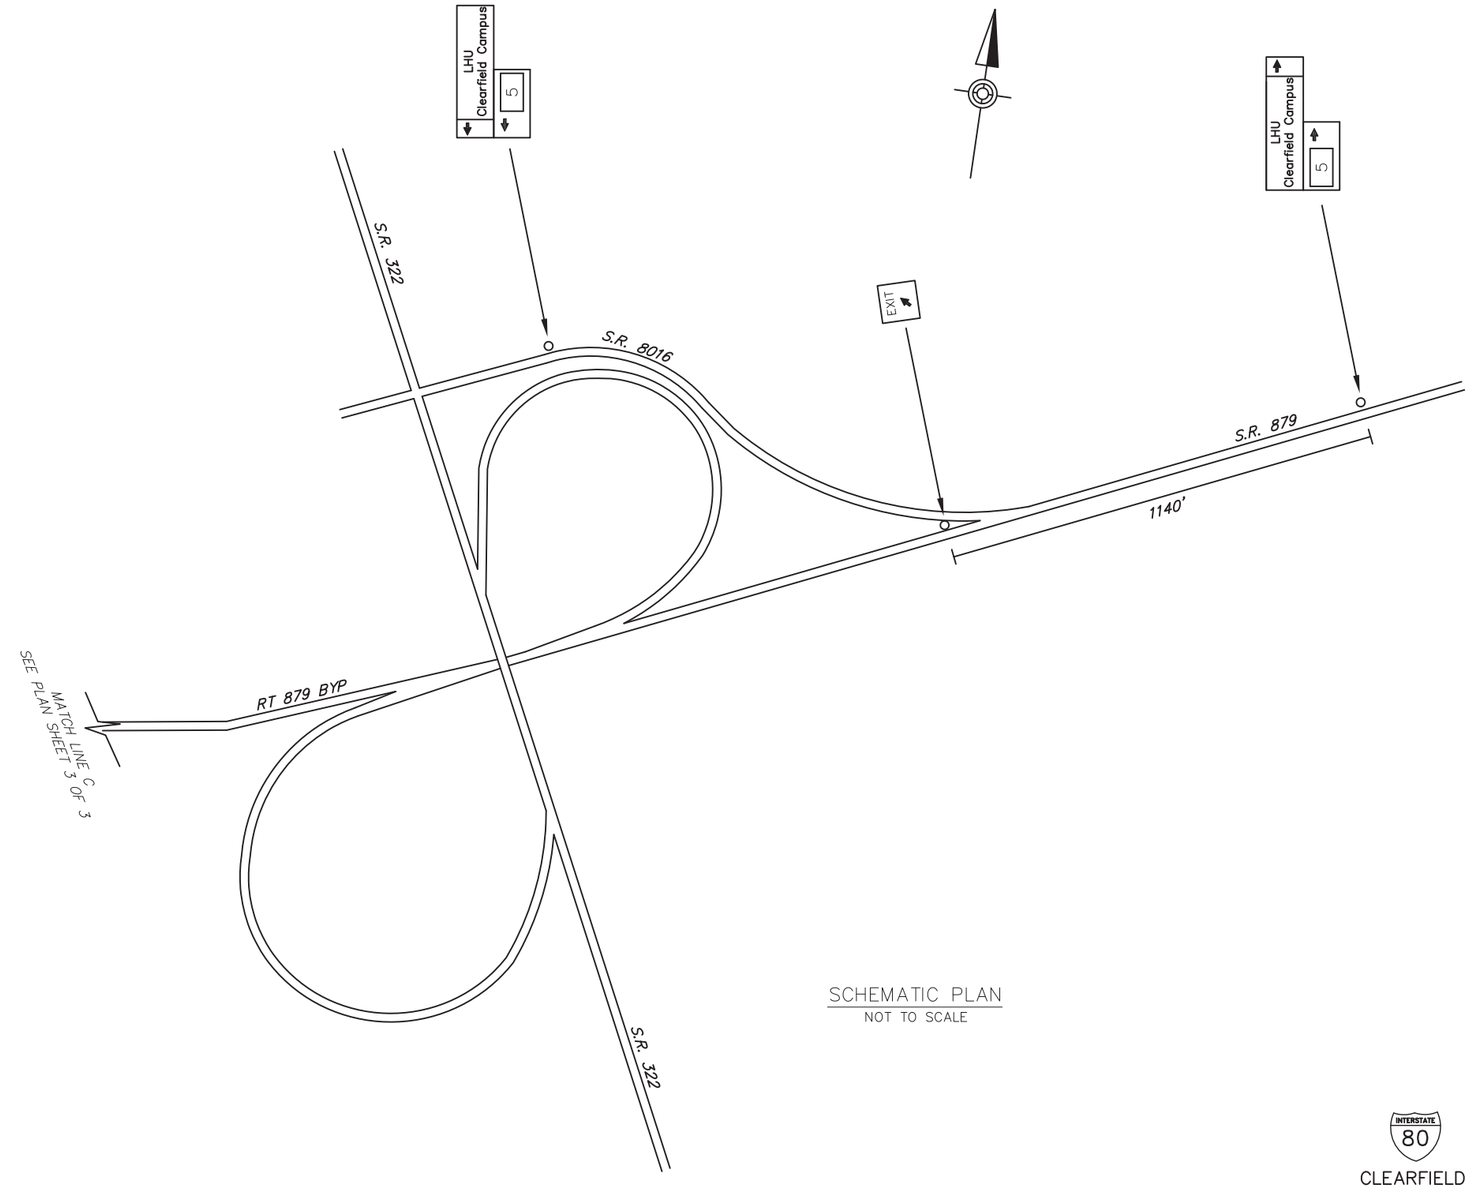

SCHEMATIC PLAN
NOT TO SCALE

EXIT 120 SPECIFIC INFORMATION PANEL			
SIGN NUMBER	LEGEND	BUSINESS	LOGO. NO.
80/120 G EB 80/120 G WB	GAS	SAPP BROS. (OPEN 24 HOURS)	1
		BP	11
		SNAPPYS	13
		SHEETZ	15
80/120 F EB 80/120 F WB	FOOD	McDONALD'S (24 HOURS)	2
		KFC	3
		LONG JOHN SILVER'S	5
		DUTCH PANTRY NO. 78	6
		BURGER KING	7
		AUNT LU'S CAFE	8
		ARBY'S NO. 6229	12
		THE MEADOWS	17
		DUNKIN' DONUTS	20
		JUMBO BUFFET	22
80/120 L EB 80/120 L WB	LODGING	BEST WESTERN – PLUS	4
		SUPER 8	10
		COMFORT INN	14
		HOLIDAY INN EXPRESS & SUITES	16
		HAMPTON INN	18
80/120 A EB 80/120 A WB	ATTRACTION	STARR HILL WINERY	19
		LOCK HAVEN UNIVERSITY-CLEARFIELD CAMPUS	21

INTERSTATE 80

CLEARFIELD
EXIT 120
SHEET 2 OF 3

D:\2015_ECMS\215076-01\MW\PSE\AS-BUILT DRAWINGS\PENNDOT DISTRICT 02\CLEARFIELD - 17\10-XX SHTXX-I80_EXIT 120 PLAN
July/24/2018 8:45 AM

DISTRICT	COUNTY	ROUTE	PROJECT	SHEET
2-0	CLEARFIELD	I-80		3 OF 3

BRADFORD & LAWRENCE TOWNSHIPS
AND BORO OF CURWENSVILLE

REVISIONS

SYMBOLS

- ○ *Existing Sign to Remain*
- △ *Existing Sign to be Removed*
- □ *Existing Sign Reset as Shown*
- ● NEW SIGN
- × FUTURE SIGN
- Ø *Existing Utility Pole*

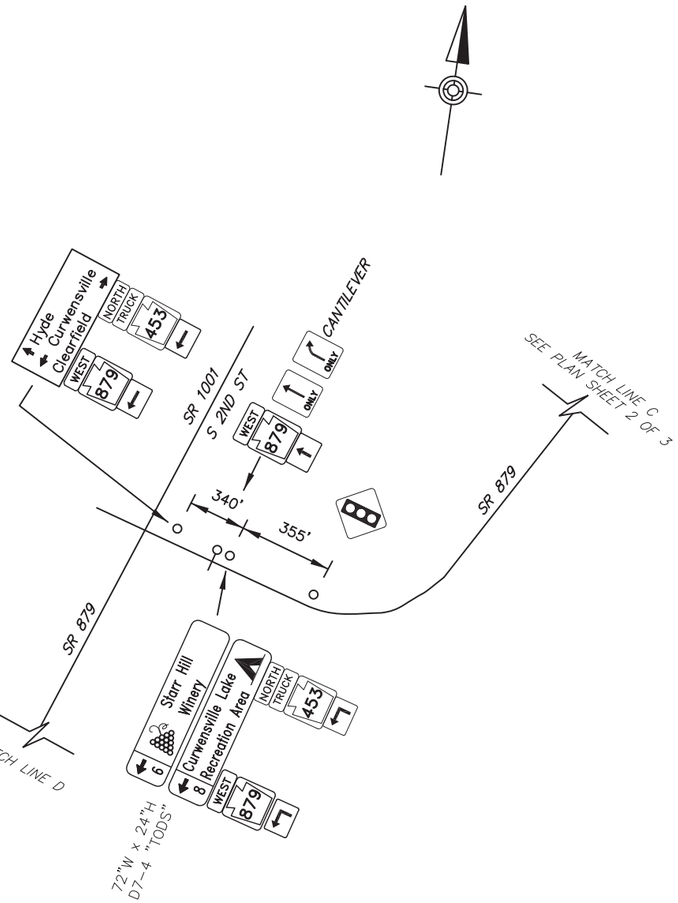

LAWRENCE TOWNSHIP

SCHEMATIC PLAN
NOT TO SCALE

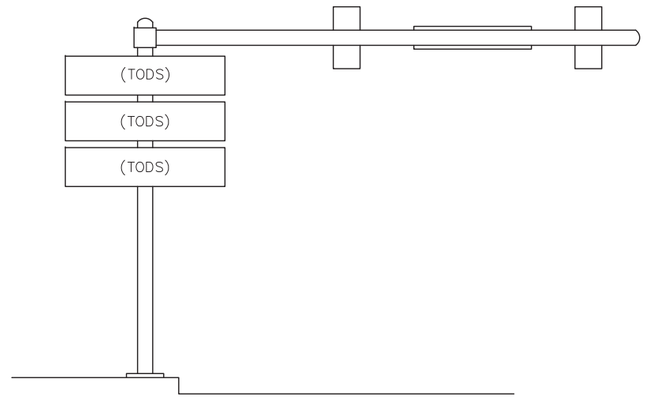

ELEVATION DETAIL
NOT TO SCALE

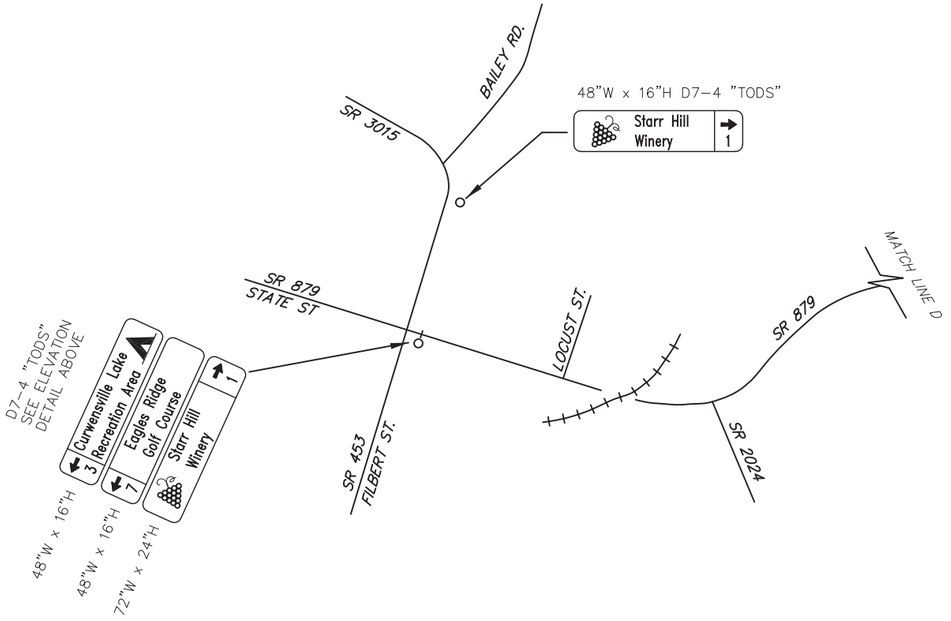

BORO OF CURWENSVILLE

SCHEMATIC PLAN
NOT TO SCALE

INTERSTATE 80

CLEARFIELD
EXIT 120
SHEET 3 OF 3

\\DAVPROJ01\PROJECTS\2015.JOBS\215076-01\HV\PSE\AS-BUILT DRAWINGS\PENNDOT DISTRICT 02\CLEARFIELD - 17\10-XX SHTXX-I80_EXIT 120 PLAN
July/12/2018 2:49 PM