DISTRICT	COUNTY	ROUTE	PROJECT	SHEET
1-0	VENANGO	I-80		
IRWIN TOWNSHIP AND BARKEYVILLE BOROUGH				
REVISIONS				

TABULATION OF QUANTITIES		
ITEM	UNIT	QUANTITY
POST MOUNTED SIGNS, TYPE A, LOGO	SQ.FT.	—
POST MOUNTED SIGNS, TYPE B, LOGO	SQ.FT.	—
POST MOUNTED SIGNS, TYPE C, LOGO	SQ.FT.	—
BREAKAWAY SYSTEMS	EACH	—
* STEEL S OR W BEAM POSTS	LBS.	—
LOGO SIGN MOUNTING	EACH	
FLAT SHEET PANEL REPLACEMENT	SQ. FT.	
EXTRUDED PANEL REPLACEMENT	SQ. FT.	
REMOVAL OF POST MOUNTED MOTORIST SERVICE SIGNS, TYPES B, C & F	L.S.	

* APPROXIMATE QUANTITY FOR INFORMATION ONLY

SYMBOLS

- ○ *Existing Sign to Remain*
- △ *Existing Sign to be Removed*
- □ *Existing Sign Reset as Shown*
- ● NEW SIGN
- × FUTURE SIGN
- Ø *Existing Utility Pole*

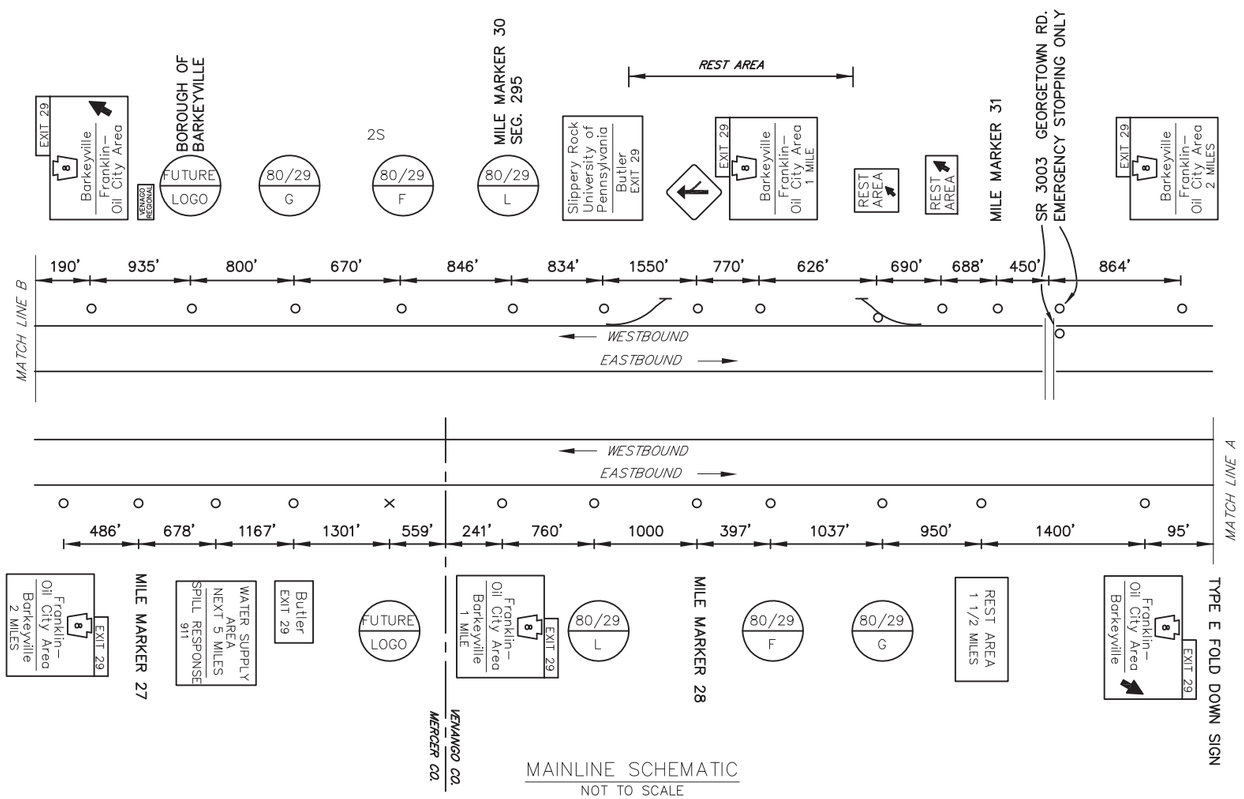

MAINLINE SCHEMATIC
NOT TO SCALE

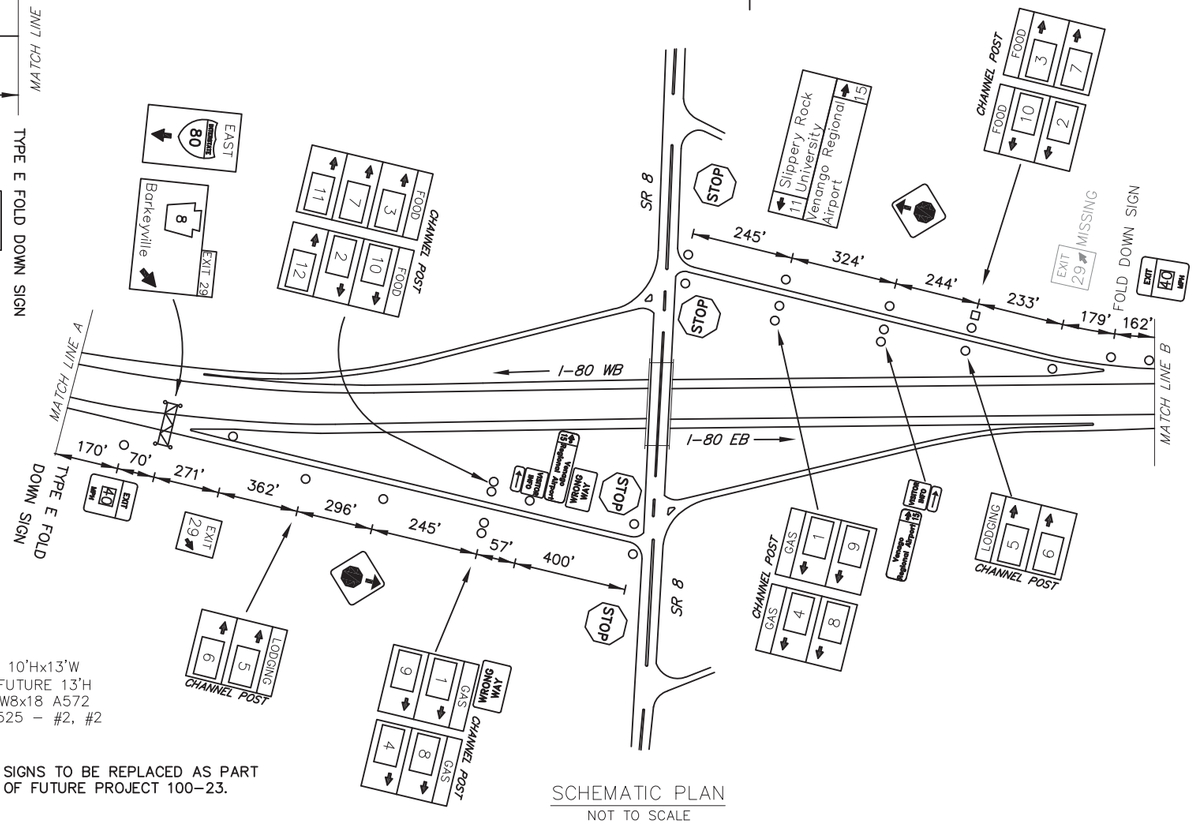

SCHEMATIC PLAN
NOT TO SCALE

EXIT 29 SPECIFIC INFORMATION PANEL			
SIGN NUMBER	LEGEND	BUSINESS	LOGO. NO.
80/29 G EB 80/29 G WB	GAS	BP (24 hours)	1
		HEATH (CNG/DIESEL)	4
		KWIK FILL (DIESEL)	8
		TA (Diesel)	9
80/29 F EB 80/29 F WB	FOOD	COUNTRY PRIDE (24 HOURS)	2
		KING'S FAMILY RESTAURANT	3
		ARBY'S	7
		KWIK FILL TRAVEL PLAZA RESTAURANT	10
		SPEEDY CAFE	11
		BURGER KING	12
80/29 L EB 80/29 L WB	LODGING	QUALITY INN	5
		MOTEL 6	6

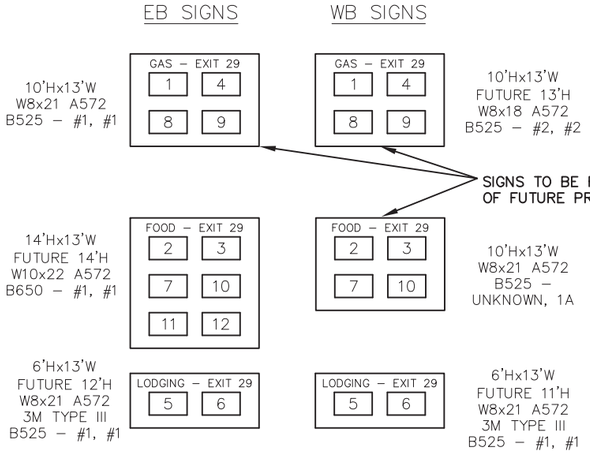

INTERSTATE 80

PA RT. 8 / BARKEYVILLE

EXIT 29

\\DFAPPDOT\PROJECTS\2015_ESPS\215076-01\MKV\PSE\AS-BUILT DRAWINGS\PENNDOT DISTRICT 01\VENANGO - 60-10-XX SHT0X-IRG_EXIT 29 PLAN
September/7/2018 1:13 PM