DISTRICT	COUNTY	ROUTE	PROJECT	SHEET
10-0	CLARION	I-80		
MONROE AND PAINT TOWNSHIPS				
REVISIONS				

TABULATION OF QUANTITIES		
ITEM	UNIT	QUANTITY
POST MOUNTED SIGNS, TYPE A, LOGO	SQ.FT.	–
POST MOUNTED SIGNS, TYPE B, LOGO	SQ.FT.	–
POST MOUNTED SIGNS, TYPE C, LOGO	SQ.FT.	–
BREAKAWAY SYSTEMS	EACH	–
* STEEL S OR W BEAM POSTS	LBS.	–
LOGO SIGN MOUNTING	EACH	–
FLAT SHEET REPLACEMENT PANELS	SQ. FT.	–
EXTRUDED PANEL REPLACEMENT	SQ. FT.	–
REMOVAL OF POST MOUNTED MOTORIST SERVICE SIGNS, TYPES B, C & F	L.S.	–

* APPROXIMATE QUANTITY FOR INFORMATION ONLY

SYMBOLS

- ○ *Existing Sign to Remain*
- △ *Existing Sign to be Removed*
- □ *Existing Sign Reset as Shown*
- ● NEW SIGN
- × FUTURE SIGN
- Ø *Existing Utility Pole*

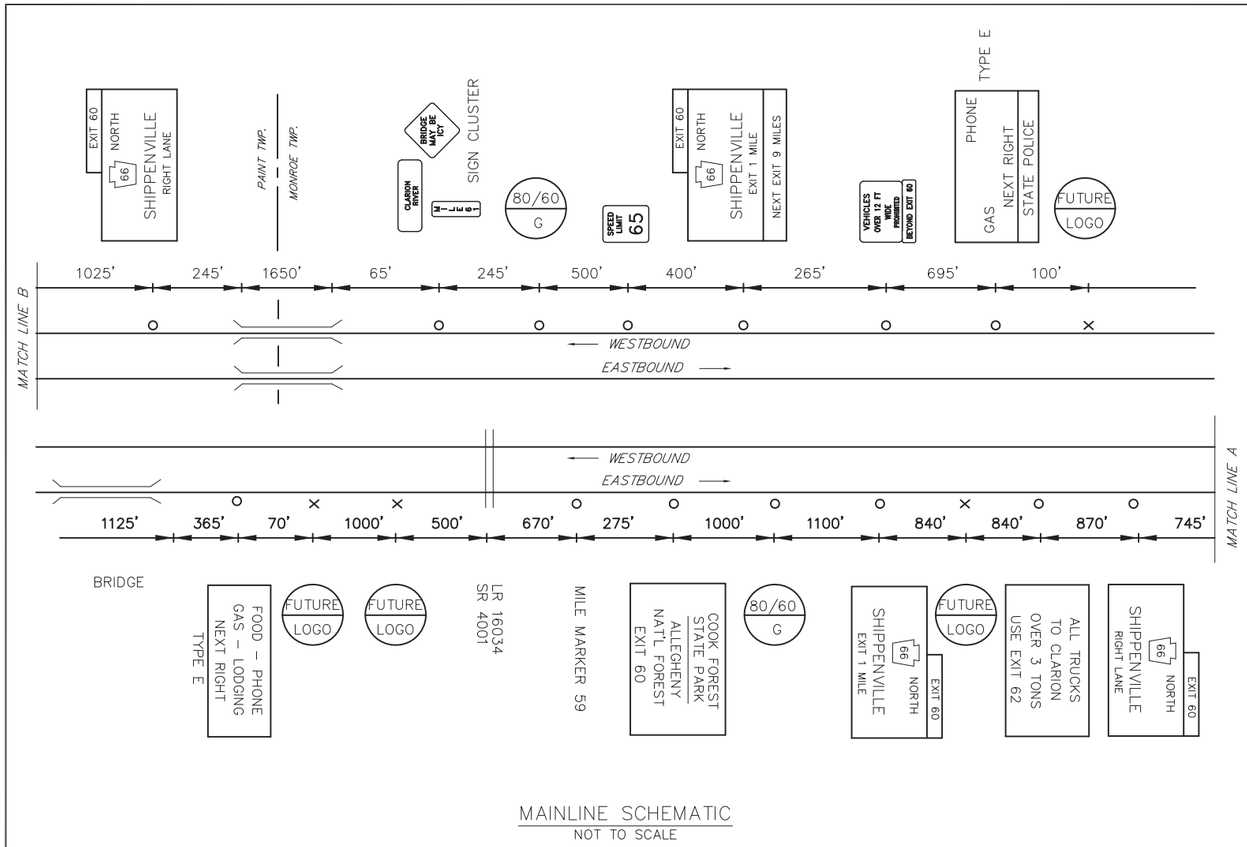

MAINLINE SCHEMATIC
NOT TO SCALE

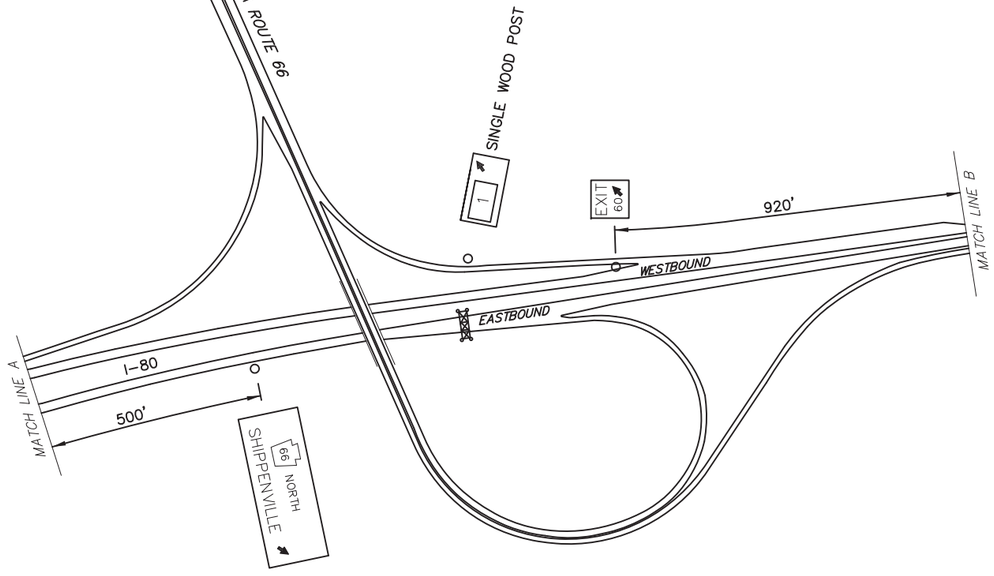

SCHEMATIC PLAN
NOT TO SCALE

EXIT 60 SPECIFIC INFORMATION PANEL			
SIGN NUMBER	LEGEND	BUSINESS	LOGO. NO.
80/60 G EB 80/60 G WB	GAS	JIFFY (DIESEL)	1

EB SIGNS

6'Hx13'W FUTURE 12' W8x18 B525–#2, #2

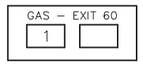

WB SIGNS

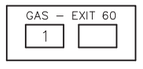

6'Hx13'W FUTURE 14' W8x21 B525 – #1, #2

INTERSTATE 80

SHIPPENVILLE

EXIT 60

D:\2015_BDP\315076-01\Hwy-PSE\As-Built Drawings\Penndot District 10\Clarion - 16\10-XX SHT\10-180_EXIT 60 PLAN
August/17/2018 1:25 PM