DISTRICT	COUNTY	ROUTE	PROJECT	SHEET
10-0	CLARION	I-80		

CLARION AND MONROE TOWNSHIPS

REVISIONS

SYMBOLS

- ○ *Existing Sign to Remain*
- △ *Existing Sign to be Removed*
- □ *Existing Sign Reset as Shown*
- ● NEW SIGN
- × FUTURE SIGN
- Ø *Existing Utility Pole*

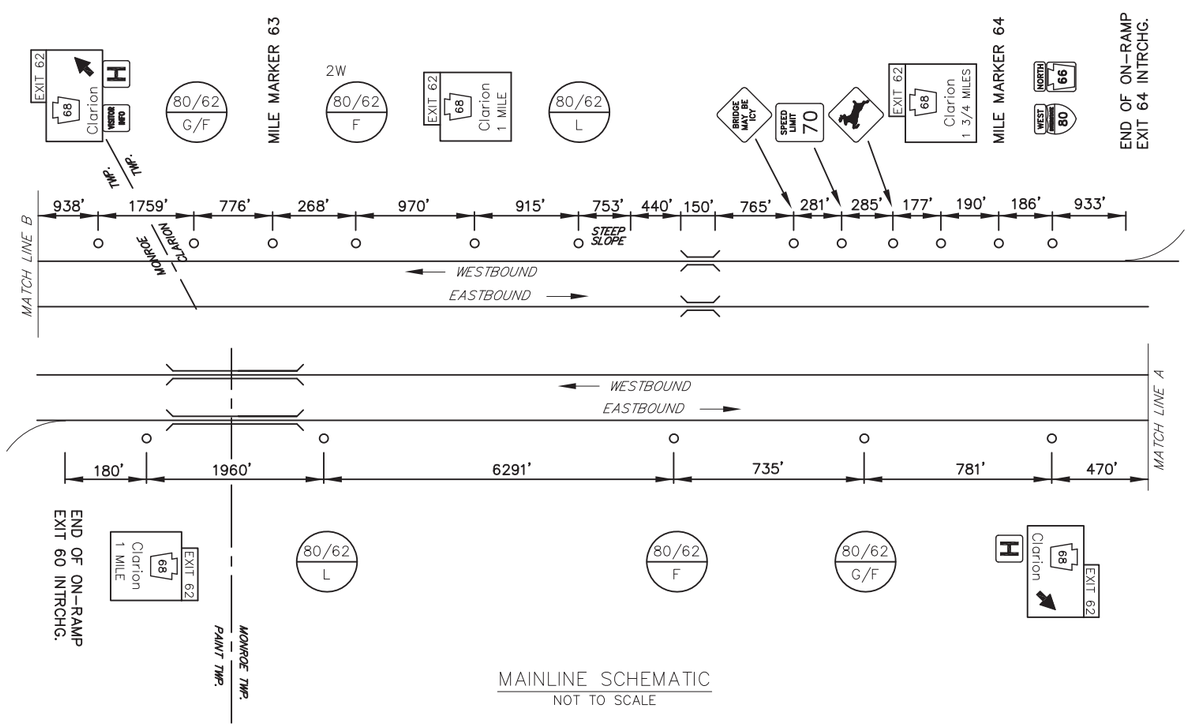

MAINLINE SCHEMATIC

NOT TO SCALE

TABULATION OF QUANTITIES		
ITEM	UNIT	QUANTITY
POST MOUNTED SIGNS, TYPE A, LOGO	SQ.FT.	—
POST MOUNTED SIGNS, TYPE B, LOGO	SQ.FT.	—
POST MOUNTED SIGNS, TYPE C, LOGO	SQ.FT.	—
BREAKAWAY SYSTEMS	EACH	—
* STEEL S OR W BEAM POSTS	LBS.	—
LOGO SIGN MOUNTING	EACH	—
FLAT SHEET REPLACEMENT PANELS	SQ. FT.	
EXTRUDED PANEL REPLACEMENT	SQ. FT.	
REMOVAL OF POST MOUNTED MOTORIST SERVICE SIGNS, TYPES B, C & F	L.S.	--

* APPROXIMATE QUANTITY FOR INFORMATION ONLY

EXIT 62 SPECIFIC INFORMATION PANEL			
SIGN NUMBER	LEGEND	BUSINESS	LOGO. NO.
80/62 F EB 80/62 F WB	FOOD	ARBY'S	1
		EAT'N PARK	2
		PERKIN'S FAMILY RESTAURANT	5
		McDONALD'S (24 HOURS)	6
		BURGER KING	9
		APPLEBEES	14
		SUBWAY	15
		TACO BELL	3
80/62 G EB 80/62 G WB	GAS	KWIK FILL (DIESEL)	13
80/62 L EB 80/62 L WB	LODGING		
		PARK INN	7
		MOTEL 6	8
		QUALITY INN	12
		HAMPTON INN	4
		HOLIDAY INN EXPRESS	16
		MICROTEL INN & SUITES	17

EB SIGNS

12'Hx13'W
W6x12
B525 – #2, #2

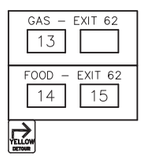

14'Hx13'W
W8x18
3M TYPE III
B525 – #2, #2

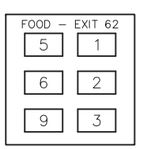

14'Hx13'W
FUTURE 16'H
W10x26
B650 – #2, #2

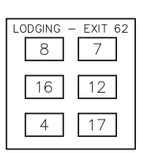

WB SIGNS

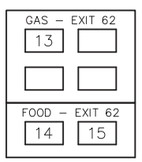

16'Hx13'W
FUTURE 18'H
W10x26
B650 – #2, #2

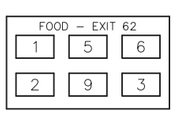

10'Hx19'W
W12x26
B650 – #2, #1

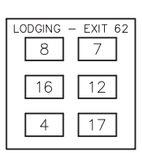

14'Hx13'W
W10x22
B650 – #2, #2

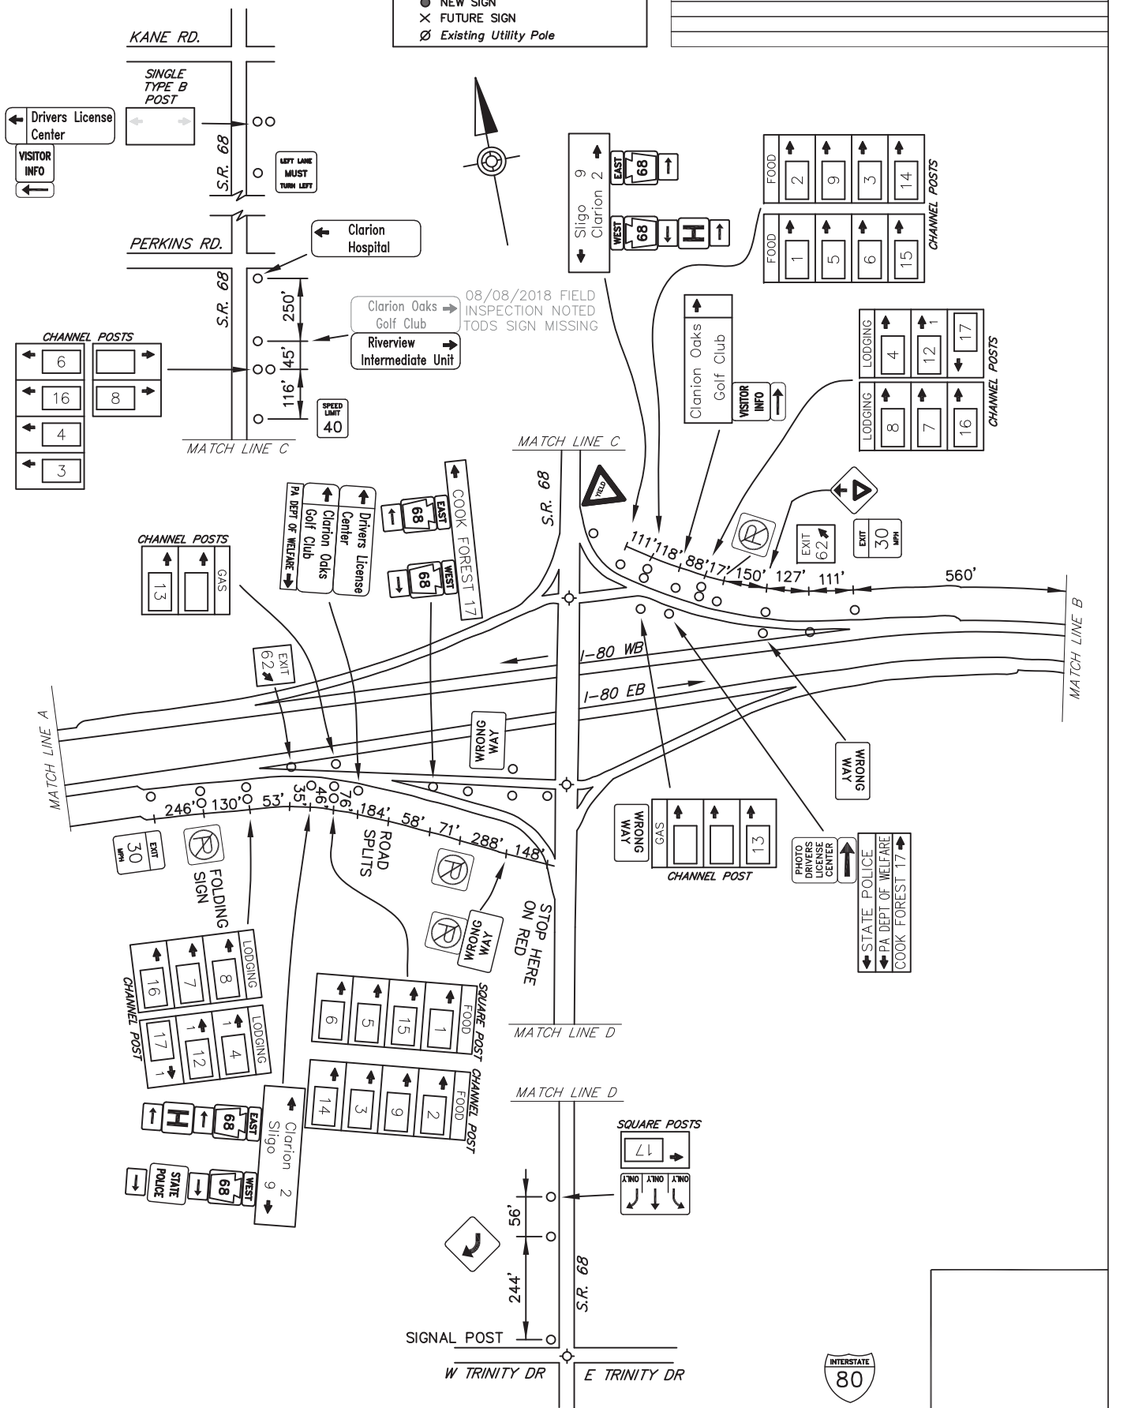

SCHEMATIC PLAN

NOT TO SCALE

INTERSTATE 80

CLARION

EXIT 62

\\DAVAPROJ01\PROJECTS\2015_ADB\215076-01\WV\PSE\AS-BUILT DRAWINGS\PENNDOT DISTRICT 10\CLARION - 16\10-XX SHT0X-I80_EXIT 62 PLAN
September/7/2018 1:41 PM