DISTRICT	COUNTY	ROUTE	PROJECT	SHEET
10-0	CLARION	I-80		

CLARION TOWNSHIP

REVISIONS

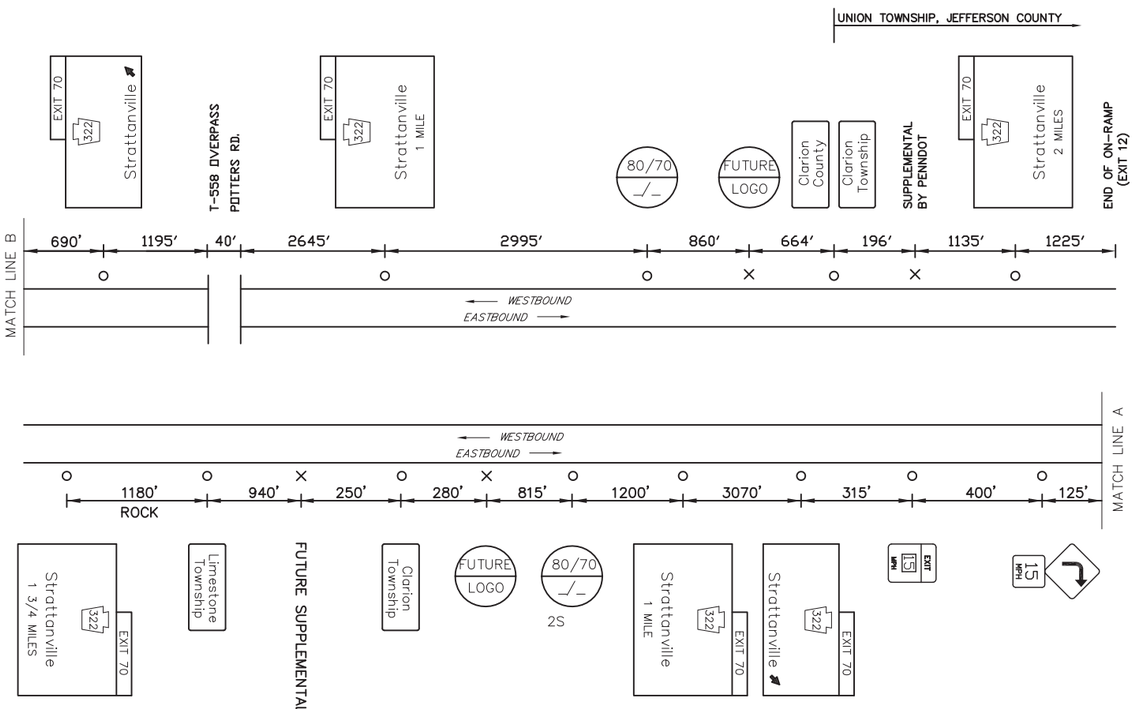

MAINLINE SCHEMATIC

NOT TO SCALE

TABULATION OF QUANTITIES		
ITEM	UNIT	QUANTITY
POST MOUNTED SIGNS, TYPE A, LOGO	SQ. FT.	
POST MOUNTED SIGNS, TYPE B, LOGO	SQ. FT.	
BREAKAWAY SYSTEMS	EACH	
* STEEL S OR W BEAM POSTS	LBS.	
LOGO SIGN MOUNTING	EACH	
FLAT SHEET PANEL REPLACEMENT	SQ. FT.	
EXTRUDED PANEL REPLACEMENT	SQ. FT.	
REMOVAL OF POST MOUNTED MOTORIST SERVICE SIGNS, TYPES B, C & F	L.S.	

* APPROXIMATE QUANTITY FOR INFORMATION ONLY

SYMBOLS

- ○ *Existing Sign to Remain*
- △ *Existing Sign to be Removed*
- □ *Existing Sign Reset as Shown*
- ● NEW SIGN
- × FUTURE SIGN
- Ø *Existing Utility Pole*

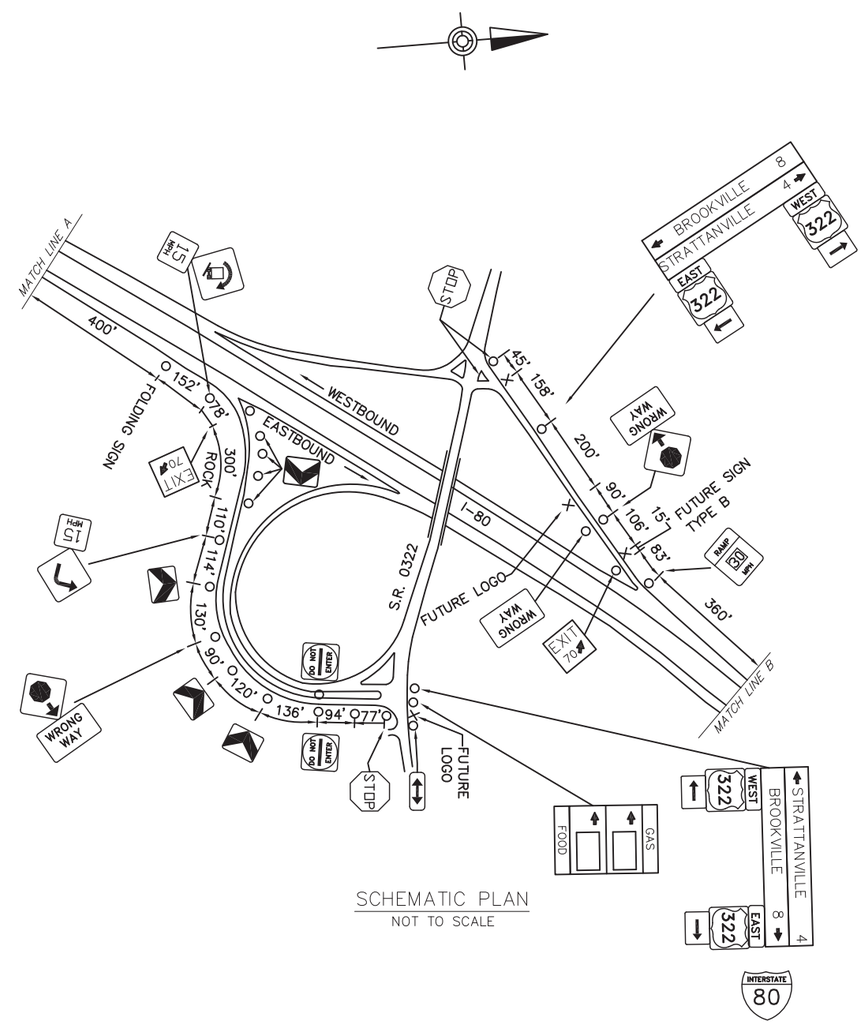

SCHEMATIC PLAN

NOT TO SCALE

EXIT 70 SPECIFIC INFORMATION PANEL			
SIGN NUMBER	LEGEND	BUSINESS	LOGO. NO.

EB SIGNS

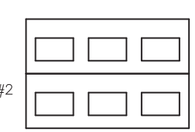

12'Hx19'W
W8x18
B525 – #2, #2

WB SIGNS

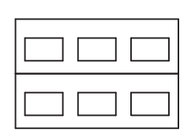

12'Hx19'W
W8x18
B525 – #2, #2

D:\2015_JOBS\215076-01\HW\PSE\AS-BUILT DRAWINGS\PENNDOT DISTRICT 10\CLARION - 16\10-XX SHT0X-I80_EXIT 70 PLAN
August/16/2018 4:59 PM