DISTRICT	COUNTY	ROUTE	PROJECT	SHEET
2-0	CLEARFIELD	I-80		
	SANDY TOWNSHIP			
10-0	JEFFERSON			
	WASHINGTON TOWNSHIP			
	REVISIONS			

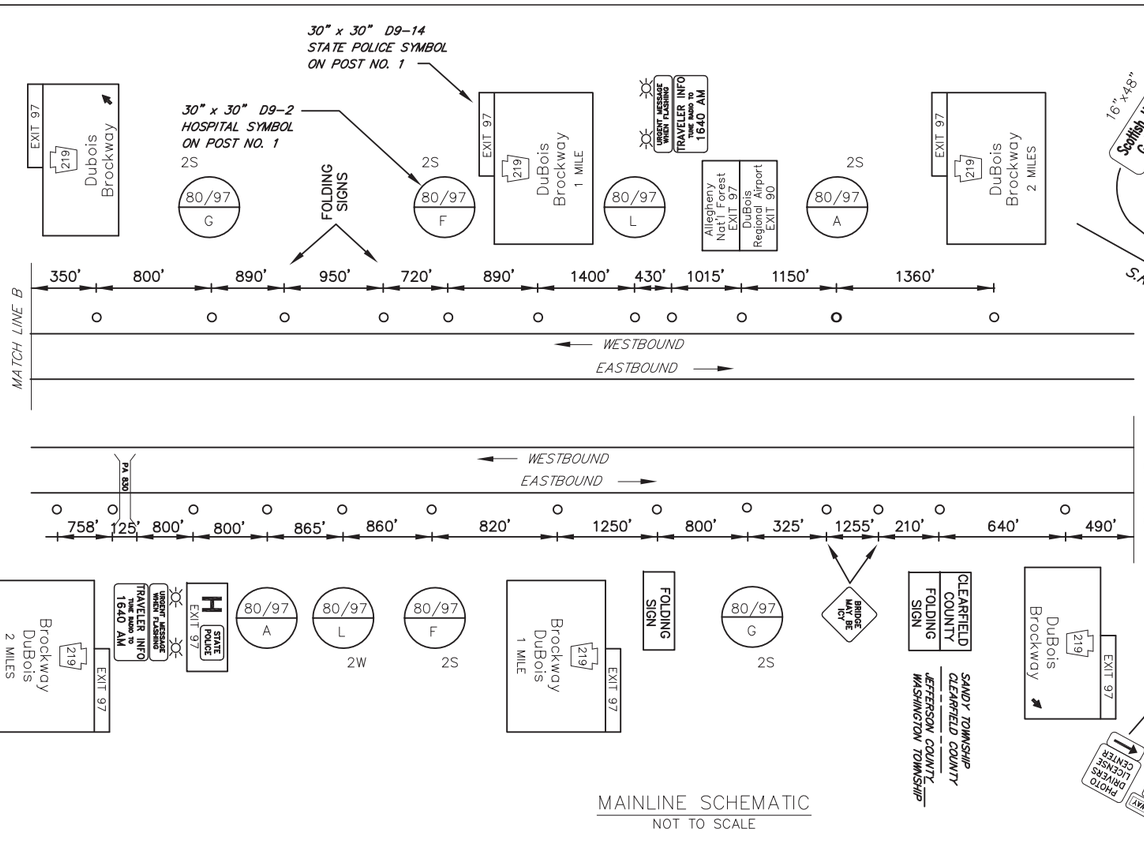

MAINLINE SCHEMATIC
NOT TO SCALE

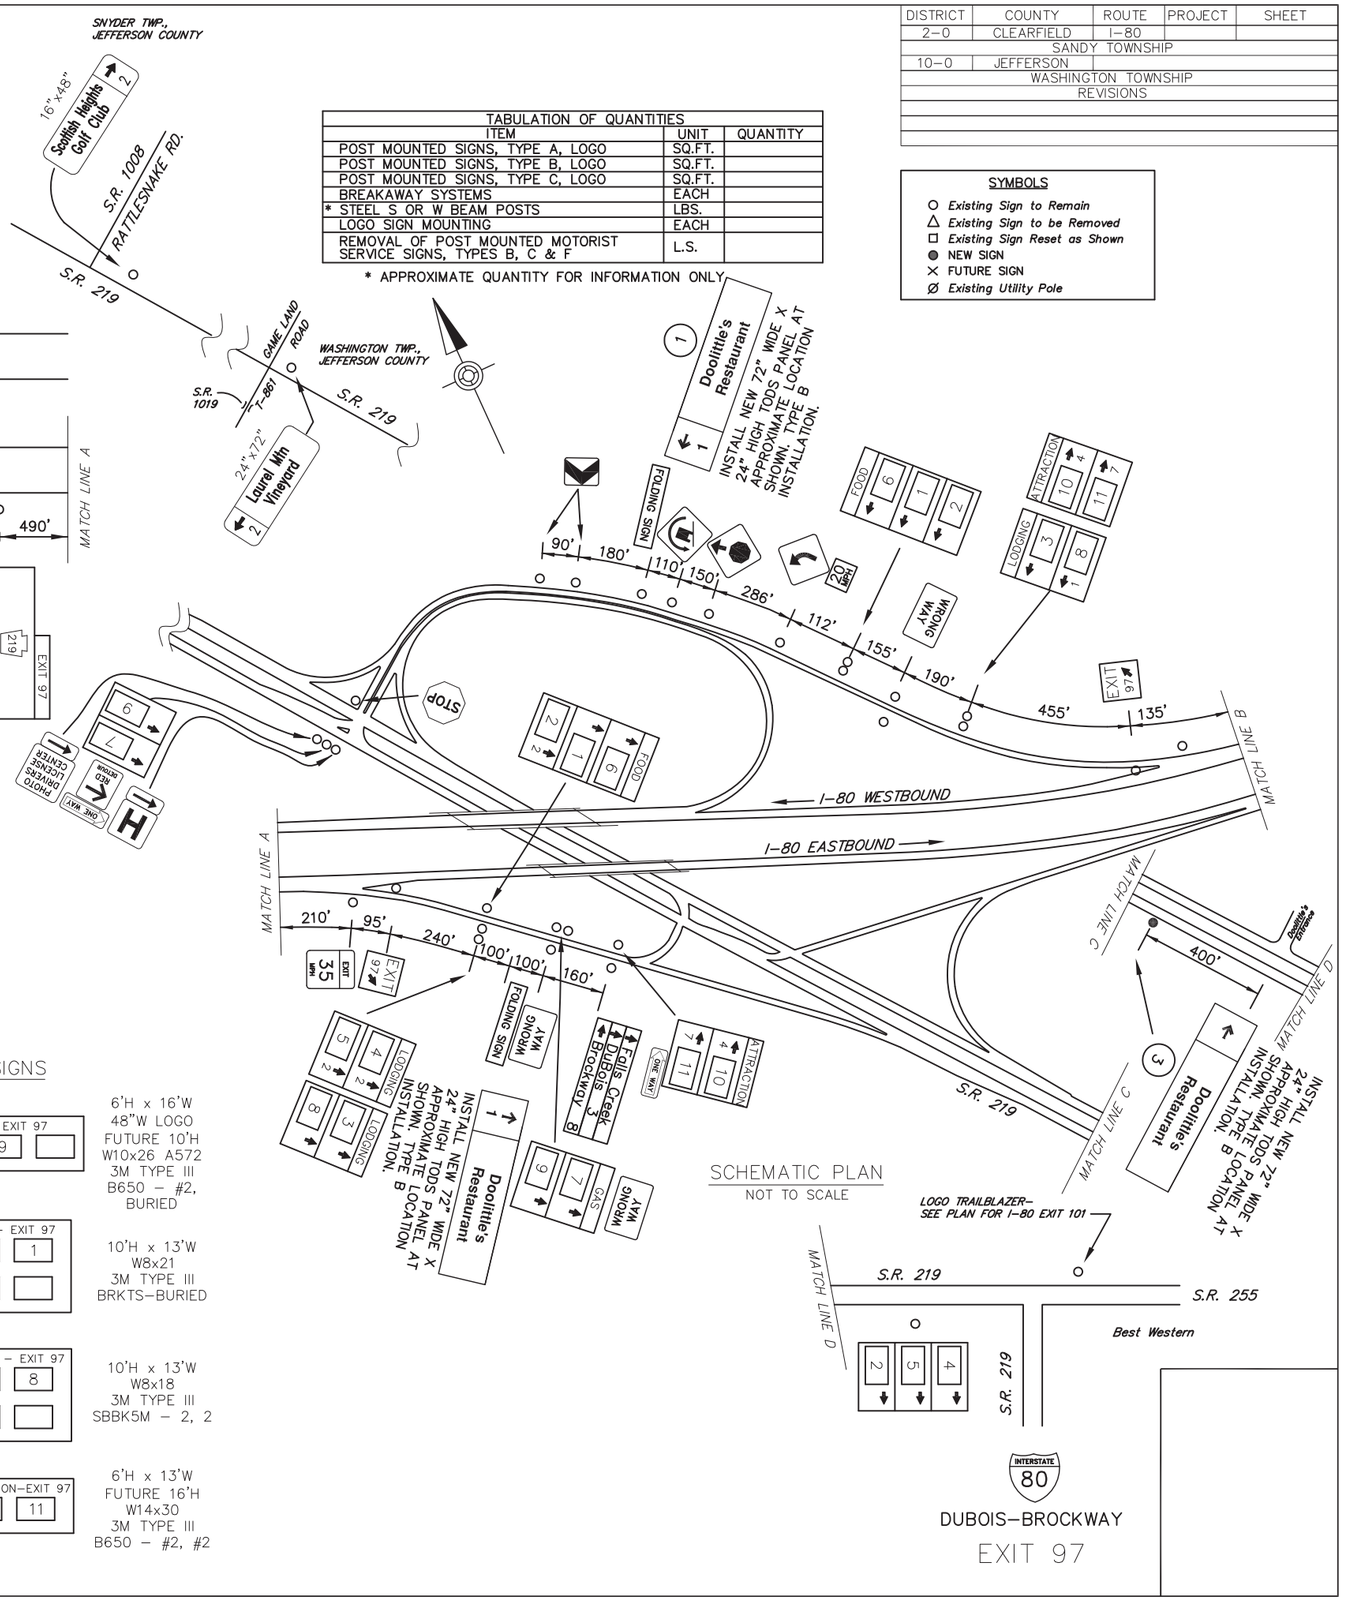

SCHEMATIC PLAN
NOT TO SCALE

TABULATION OF QUANTITIES		
ITEM	UNIT	QUANTITY
POST MOUNTED SIGNS, TYPE A, LOGO	SQ.FT.	
POST MOUNTED SIGNS, TYPE B, LOGO	SQ.FT.	
POST MOUNTED SIGNS, TYPE C, LOGO	SQ.FT.	
BREAKAWAY SYSTEMS	EACH	
* STEEL S OR W BEAM POSTS	LBS.	
LOGO SIGN MOUNTING	EACH	
REMOVAL OF POST MOUNTED MOTORIST SERVICE SIGNS, TYPES B, C & F	L.S.	

* APPROXIMATE QUANTITY FOR INFORMATION ONLY

SYMBOLS

- ○ Existing Sign to Remain
- △ Existing Sign to be Removed
- □ Existing Sign Reset as Shown
- ● NEW SIGN
- × FUTURE SIGN
- Ø Existing Utility Pole

EXIT 97 SPECIFIC INFORMATION PANEL			
SIGN NUMBER	LEGEND	BUSINESS	LOGO. NO.
80/97 F EB 80/97 F WB	FOOD	ARBY'S	1
		HOSS'S	2
		DUTCH PANTRY	6
80/97 G EB 80/97 G WB	GAS	SHEETZ (DIESEL)	7
		PILOT (24 HOURS)	9
80/97 L EB 80/97 L WB	LODGING	CLARION HOTEL	3
		BEST WESTERN	4
		DUBOIS MANOR MOTEL	5
		HOLIDAY INN EXPRESS & SUITES	8
80/97 A EB 80/97 A WB	ATTRACTION	LAUREL MOUNTAIN WINERY	10
		SCOTTISH HEIGHTS GOLF CLUB	11

	EB SIGNS	WB SIGNS	
6'H x 16'W 48"W LOGO' FUTURE 10'H W10x26 A572 3M TYPE III B650 – #2, #1	GAS – EXIT 97: 7 9	GAS – EXIT 97: 7 9	6'H x 16'W 48"W LOGO FUTURE 10'H W10x26 A572 3M TYPE III B650 – #2, BURIED
10'H x 13'W W8x21 3M TYPE III B525 – #1, #1	FOOD – EXIT 97: 6 1 / 2	FOOD – EXIT 97: 6 1 / 2	10'H x 13'W W8x21 3M TYPE III BRKTS–BURIED
10'H x 13'W W8x21 3M TYPE III BURIED, B525 – #1	LODGING – EXIT 97: 3 4 / 5 8	LODGING – EXIT 97: 3 8	10'H x 13'W W8x18 3M TYPE III SBBK5M – 2, 2
6'H x 13'W FUTURE 16'H W14x30 3M TYPE III B650 – #1, #1	ATTRACTION–EXIT 97: 10 11	ATTRACTION–EXIT 97: 10 11	6'H x 13'W FUTURE 16'H W14x30 3M TYPE III B650 – #2, #2

DUBOIS–BROCKWAY
EXIT 97

D:\2015_ADB\215076-01\WW\PSE\AS-BUILT DRAWINGS\PENNDOT DISTRICT 02\CLEARFIELD - 17\10-XX SHT0X-I80_EXIT 97 PLAN
August 13, 2018 9:46 AM