DISTRICT	COUNTY	ROUTE	PROJECT	SHEET
4-0	LUZERNE	I-81		

CITY OF WILKES-BARRE & HANOVER TOWNSHIP

REVISIONS

TABULATION OF QUANTITIES		
ITEM	UNIT	QUANTITY
POST MOUNTED SIGNS, TYPE A, LOGO	SQ.FT.	
POST MOUNTED SIGNS, TYPE B, LOGO	SQ.FT.	
POST MOUNTED SIGNS, TYPE C, LOGO	SQ.FT.	
BREAKAWAY SYSTEMS	EACH	
* STEEL S OR W BEAM POSTS	LBS.	
LOGO SIGN MOUNTING	EACH	
REMOVAL OF POST MOUNTED MOTORIST SERVICE SIGNS, TYPES A & E	EACH	
REMOVAL OF POST MOUNTED MOTORIST SERVICE SIGNS, TYPES B, C & F	L.S.	

* APPROXIMATE QUANTITY FOR INFORMATION ONLY

SYMBOLS

- ○ *Existing Sign to Remain*
- △ *Existing Sign to be Removed*
- □ *Existing Sign Reset as Shown*
- ● NEW SIGN
- × FUTURE SIGN
- Ø *Existing Utility Pole*

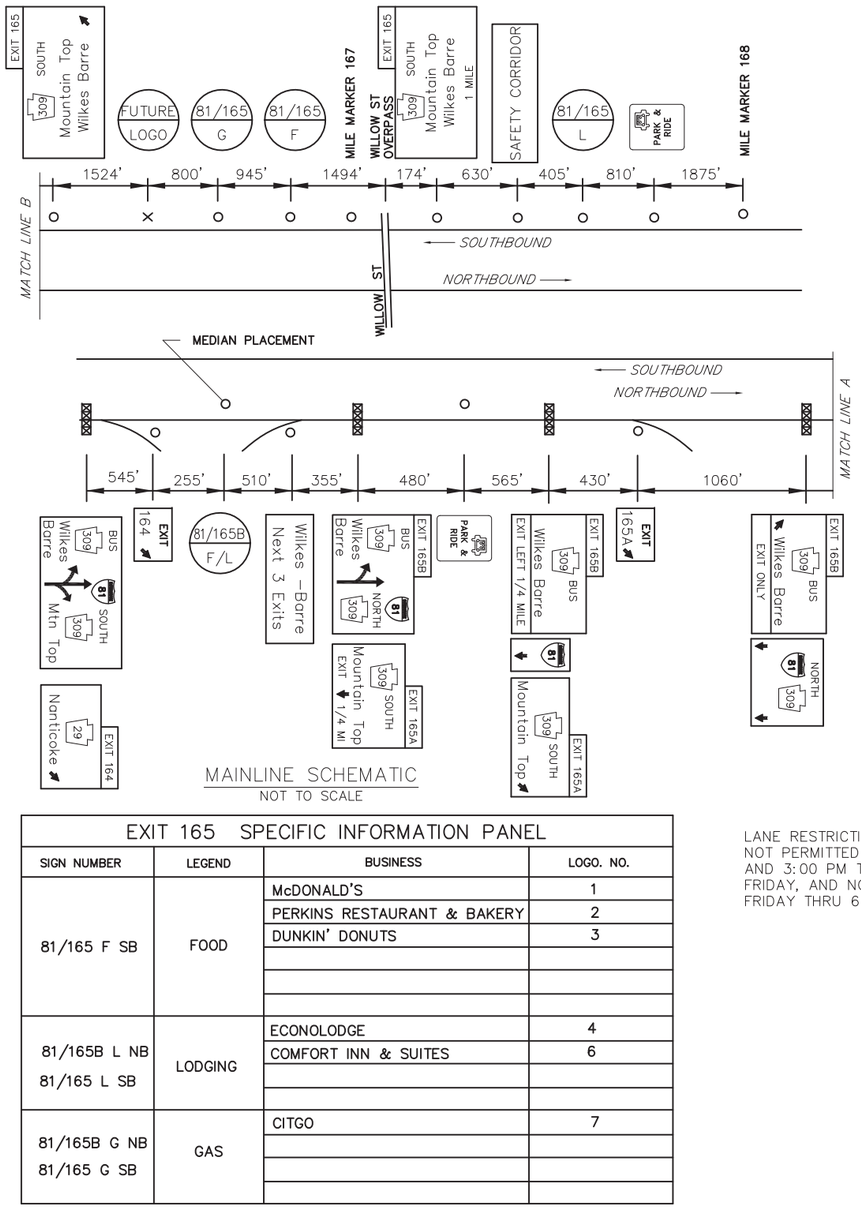

MAINLINE SCHEMATIC

NOT TO SCALE

NB SIGNS

12'Hx19'W
W14x30 A572
3M TYPE III
B650 - #2, #2

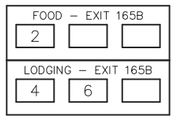

SB SIGNS

6'Hx13'W
FUTURE 12'H
W6x15
3M TYPE III
B525 - #1, #2

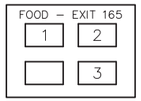

10'Hx13'W
FUTURE 16'H
W14x30 A572
3M TYPE III
B650 - #2, #2

10'Hx13'W
FUTURE 12'H or 14'H
W8x18
3M TYPE III
B525 - #2, #2

EXIT 165 SPECIFIC INFORMATION PANEL			
SIGN NUMBER	LEGEND	BUSINESS	LOGO. NO.
81/165 F SB	FOOD	McDONALD'S	1
		PERKINS RESTAURANT & BAKERY	2
		DUNKIN' DONUTS	3
81/165B L NB 81/165 L SB	LODGING	ECONOLODGE	4
		COMFORT INN & SUITES	6
81/165B G NB 81/165 G SB	GAS	CITGO	7

LANE RESTRICTIONS AND LANE CLOSURES
NOT PERMITTED 6:00 AM TO 9:00 AM
AND 3:00 PM TO 6:00 PM MONDAY THRU
FRIDAY, AND NOT PERMITTED 6:00 PM
FRIDAY THRU 6:00 AM MONDAY.

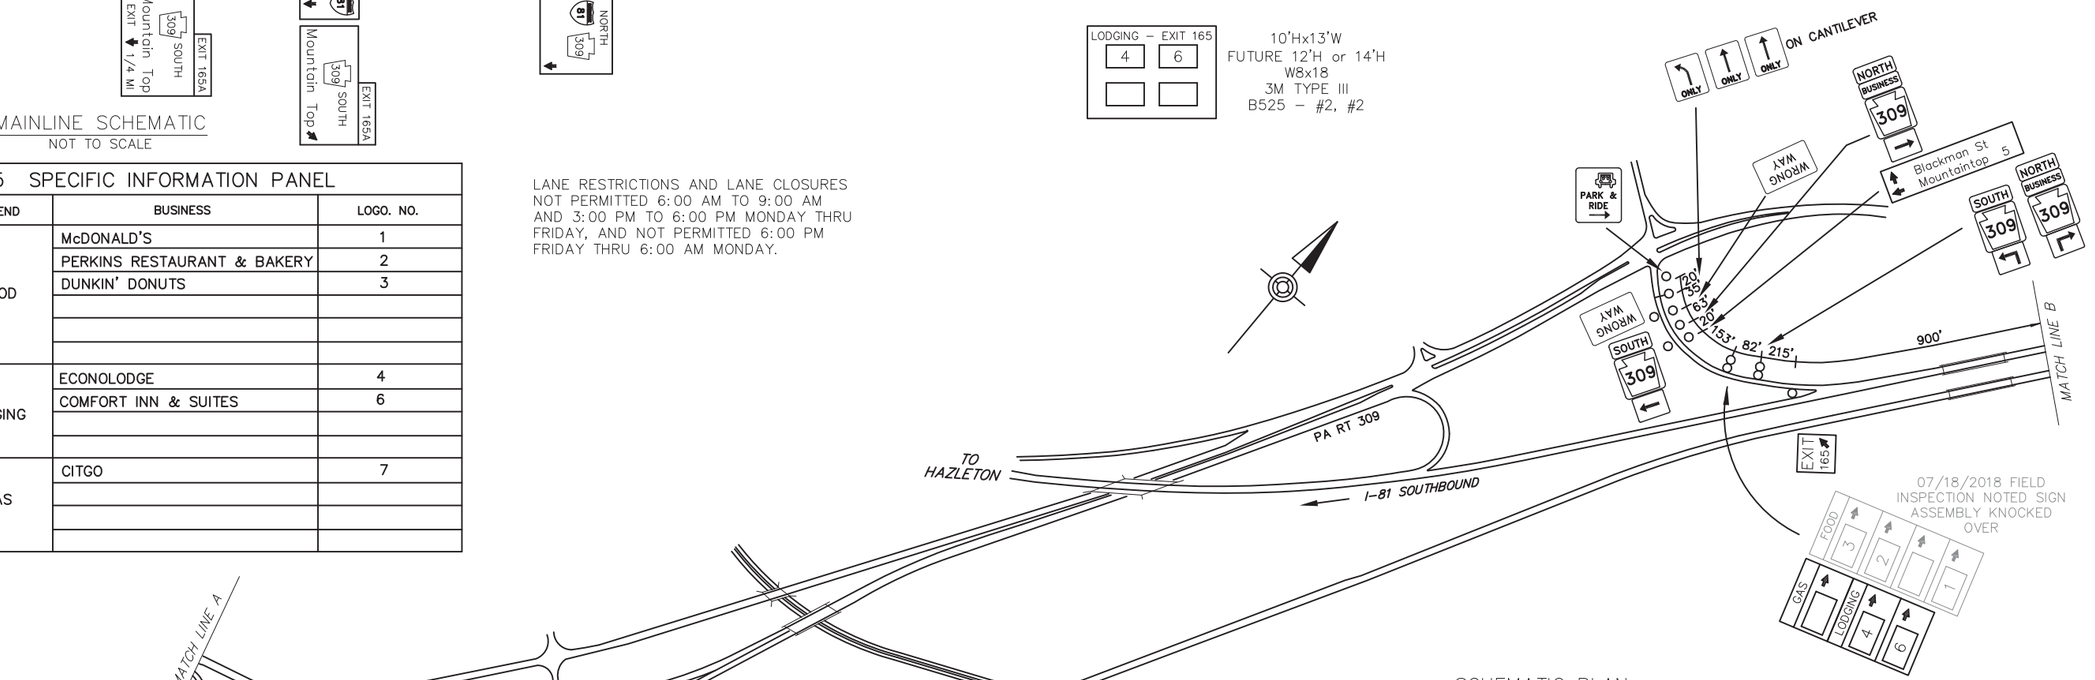

SCHEMATIC PLAN

NOT TO SCALE

INTERSTATE
81

WILKES-BARRE

EXIT 165

D:\2015_ECMS\215076-01\WV\PSE\AS-BUILT DRAWINGS\PENNDOT DISTRICT 04\LUZERNE - 4D\1D-XX SHTXX-IBL_EXIT 165 PLAN
August/14/2018 2:05 PM