DISTRICT	COUNTY	ROUTE	PROJECT	SHEET
4–0	LACKAWANNA	I–81		
CITY OF SCRANTON AND BORO OF DUNMORE				
REVISIONS				

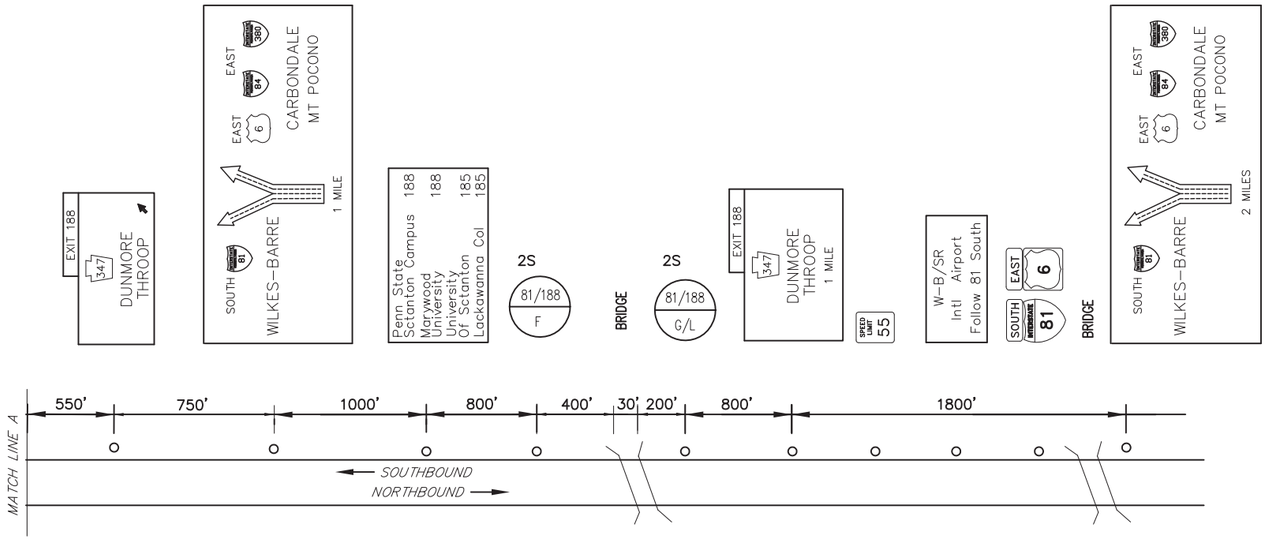

NB NOT ELIGIBLE – INSUFFICIENT SPACE

MAINLINE SCHEMATIC
NOT TO SCALE

TABULATION OF QUANTITIES		
ITEM	UNIT	QUANTITY
POST MOUNTED SIGNS, TYPE A, LOGO	SQ.FT.	
POST MOUNTED SIGNS, TYPE B, LOGO	SQ.FT.	
POST MOUNTED SIGNS, TYPE C, LOGO	SQ.FT.	
BREAKAWAY SYSTEMS	EACH	
* STEEL S OR W BEAM POSTS	LBS.	
LOGO SIGN MOUNTING	EACH	
RESET POST MOUNTED SIGN, TYPE A	EACH	
EXTRUDED PANEL REPLACEMENT	SQ. FT.	
REMOVAL OF POST MOUNTED MOTORIST SERVICE SIGNS, TYPES B, C & F	L.S.	–

* APPROXIMATE QUANTITY FOR INFORMATION ONLY

SYMBOLS

- ○ *Existing Sign to Remain*
- △ *Existing Sign to be Removed*
- □ *Existing Sign Reset as Shown*
- ● NEW SIGN
- × FUTURE SIGN
- Ø *Existing Utility Pole*

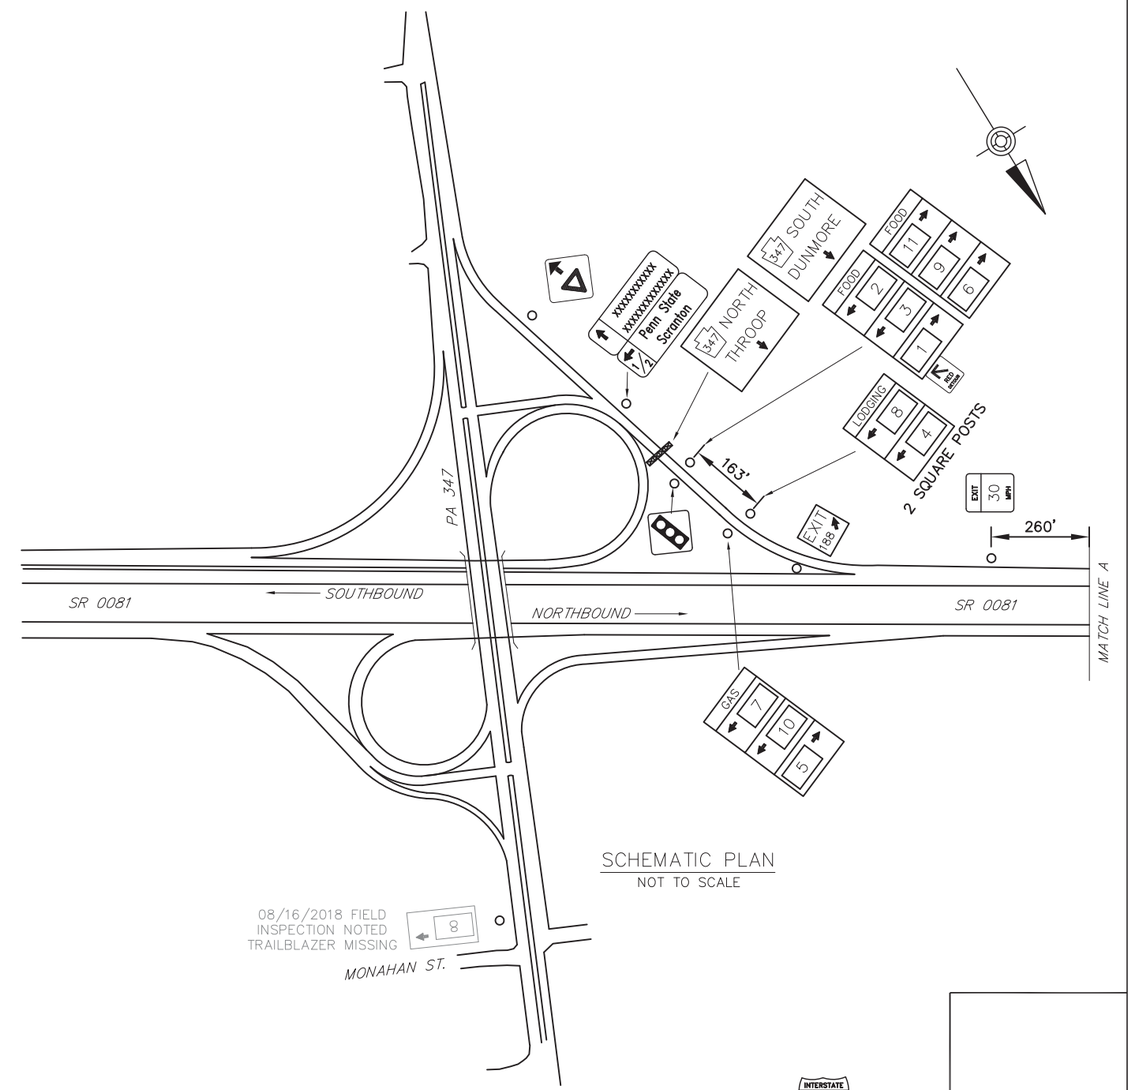

SCHEMATIC PLAN
NOT TO SCALE

NOTE:

LANE CLOSURES & LANE RESTRICTIONS
NOT PERMITTED 6:00AM THRU 9:00AM
AND 3:00PM THRU 6:00PM,
MONDAY THRU FRIDAY.

NO LANE CLOSURES & LANE RESTRICTIONS
DURING HOLIDAY PERIODS AS DEFINED BY DISTRICT 4–0.

EXIT 188 SPECIFIC INFORMATION PANEL			
SIGN NUMBER	LEGEND	BUSINESS	LOGO. NO.
81/188 F SB	FOOD	BURGER KING	1
		McDONALD'S	2
		WENDY'S	3
		FRIENDLY'S	6
		DUNKIN DONUTS	9
		SUBWAY	11
81/188 L SB	LODGING	QUALITY INN	4
		SLEEP INN (INN & SUITES)	8
81/188 G SB	GAS	EXXON (DIESEL/24 HRS)	5
		SUNOCO	7
		SHEETZ	10

SB SIGNS

16'Hx13'W
W14x30 A572
B650 – #2, #2

GAS – EXIT 188	
5	7
10	
LODGING – EXIT 188	
8	4

10'Hx19'W
FUTURE 14'H
W12x26 A572
3M TYPE III
B650 – #1, #1

FOOD – EXIT 188		
6	1	9
2	3	11

BREAKAWAY BOLTS LOOSE

INTERSTATE 81

DUNMORE / THROOP

EXIT 188

D:\2015\GE85\215076-01\MV\PSE\AS-BUILT DRAWINGS\PENNDOT DISTRICT 04\LACKAWANNA - 35\10-XX SHT8V-IBL_EXIT 188 PLAN
September/4/2018 10:19 AM