DISTRICT	COUNTY	ROUTE	PROJECT	SHEET
4-0	SUSQUEHANNA	I-81		
LENOX TOWNSHIP				
4-0	LACKAWANNA	I-81		
BENTON TOWNSHIP				
REVISIONS				

MEASUREMENTS SHOULD BE VERIFIED IN FIELD BEFORE ANY FURTHER LOGOS ARE CONSTRUCTED

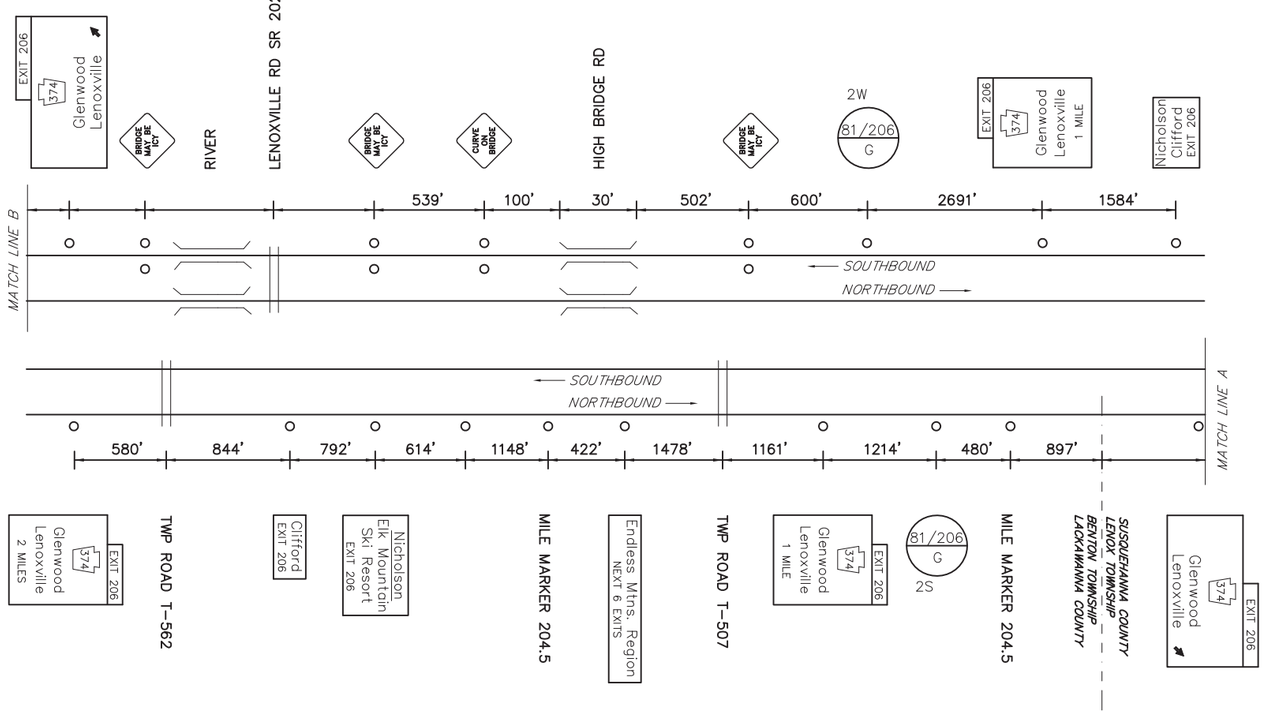

MAINLINE SCHEMATIC
NOT TO SCALE

TABULATION OF QUANTITIES		
ITEM	UNIT	QUANTITY
POST MOUNTED SIGNS, TYPE A, LOGO	SQ.FT.	–
POST MOUNTED SIGNS, TYPE B, LOGO	SQ.FT.	–
POST MOUNTED SIGNS, TYPE C, LOGO	SQ.FT.	–
BREAKAWAY SYSTEMS	EACH	–
* STEEL S OR W BEAM POSTS	LBS.	–
LOGO SIGN MOUNTING	EACH	–
REMOVAL OF POST MOUNTED MOTORIST SERVICE SIGNS, TYPES A & E	EACH	
REMOVAL OF POST MOUNTED MOTORIST SERVICE SIGNS, TYPES B, C & F	L.S.	

* APPROXIMATE QUANTITY FOR INFORMATION ONLY

SYMBOLS

- ○ *Existing Sign to Remain*
- △ *Existing Sign to be Removed*
- □ *Existing Sign Reset as Shown*
- ● NEW SIGN
- × FUTURE SIGN
- Ø *Existing Utility Pole*

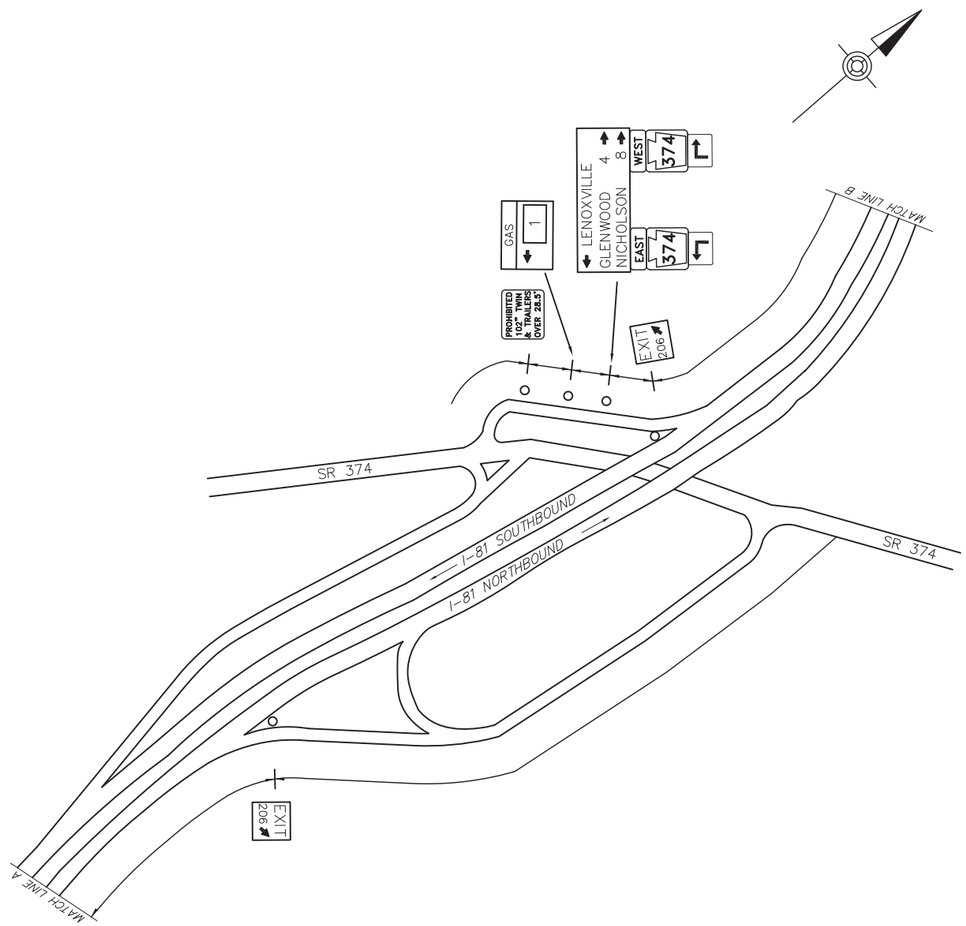

SCHEMATIC PLAN
NOT TO SCALE

EXIT 206 SPECIFIC INFORMATION PANEL			
SIGN NUMBER	LEGEND	BUSINESS	LOGO. NO.
81/206 G NB 81/206 G SB	GAS	SUNOCO (DIESEL-24 HR)	1

NB SIGNS

6'Hx13'W
FUTURE 14'H
W10x26
B650 – #1, #1

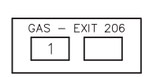

SB SIGNS

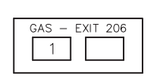

6'Hx13'W
W6x15
B525 – #1, #1

INTERSTATE 81

GLENWOOD / LENOXVILLE

EXIT 206

D:\2015_EBS\215076-01\HW\PSE\AS-BUILT DRAWINGS\PENNDOT DISTRICT 04\SUSQUEHANNA - 57\10-XX SHTXX-181_EXIT206 PLAN
September/4/2018 12:56 PM