DISTRICT	COUNTY	ROUTE	PROJECT	SHEET
6-0	CHESTER	US-1		
PENN TOWNSHIP				
REVISIONS				

TABULATION OF QUANTITIES		
ITEM	UNIT	QUANTITY
POST MOUNTED SIGNS, TYPE A, LOGO	SQ.FT.	
POST MOUNTED SIGNS, TYPE B, LOGO	SQ.FT.	
POST MOUNTED SIGNS, TYPE C, LOGO	SQ.FT.	
BREAKAWAY SYSTEMS	EACH	
* STEEL S OR W BEAM POSTS	LBS.	
LOGO SIGN MOUNTING	EACH	
REMOVAL OF POST MOUNTED MOTORIST SERVICE SIGNS, TYPES B, C & F	L.S.	

* APPROXIMATE QUANTITY FOR INFORMATION ONLY

SYMBOLS

- ○ *Existing Sign to Remain*
- △ *Existing Sign to be Removed*
- □ *Existing Sign Reset as Shown*
- ● NEW SIGN
- × FUTURE SIGN
- Ø *Existing Utility Pole*

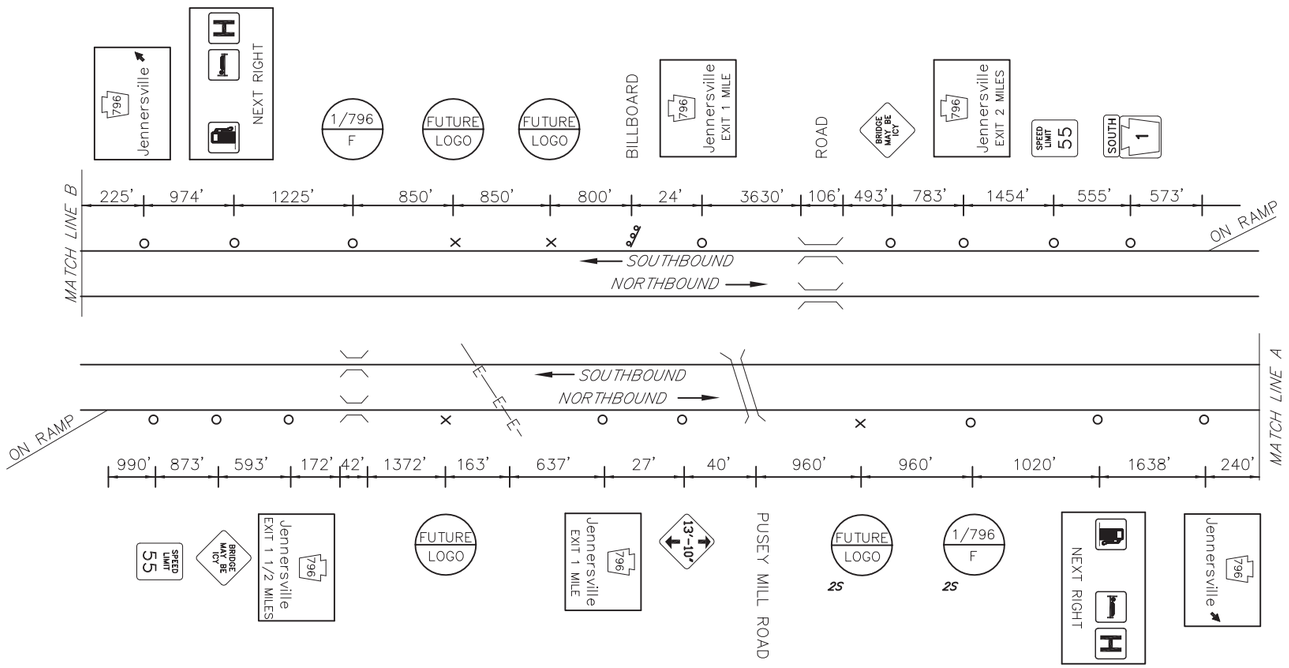

MAINLINE SCHEMATIC
NOT TO SCALE

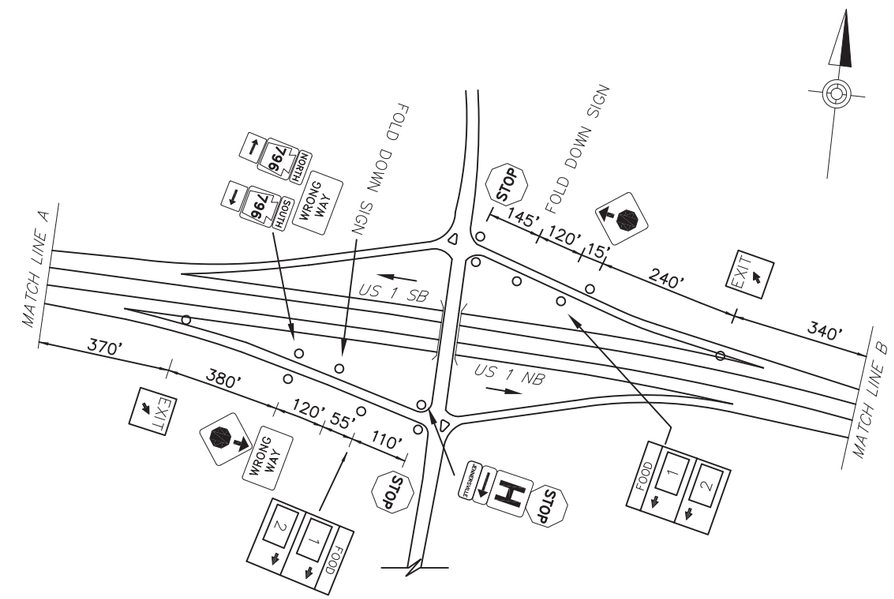

SCHEMATIC PLAN
NOT TO SCALE

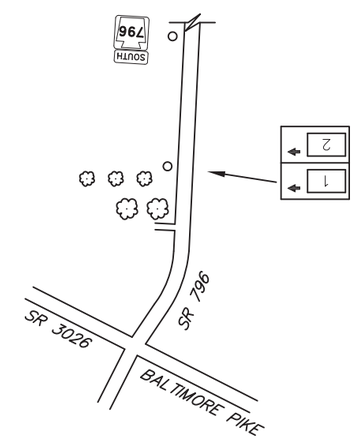

PA 796 SPECIFIC INFORMATION PANEL			
SIGN NUMBER	LEGEND	BUSINESS	LOGO. NO.
1/796 F NB	FOOD	McDONALD'S	1
1/796 F SB		STARBUCKS	2

NB SIGNS

* 6'Hx13'W
FUTURE 14'H
W12x26 A572
B650- #1, #1

FOOD – NEXT RIGHT
1 2

SB SIGNS

FOOD – NEXT RIGHT
1 2

6'Hx13'W
FUTURE 16'H
W14x30 A572
B650- #2, #2

* VERTICAL CLEARANCE 6' ABOVE PAVEMENT APPROVED BY PENNDOT.

1
PA 796
JENNERSVILLE

D:\2015.JEBS\215076-01\WV\PSEC\AS-BUILT DRAWINGS\PENN\DIST DISTRICT 06\CHESTER - 15\10-XX SHTXX_US1_JENNERSVILLE EXIT PLAN
September/14/2018 10:54 AM