DISTRICT	COUNTY	ROUTE	PROJECT	SHEET
6-0	CHESTER	US-1		

EAST NOTTINGHAM & WEST NOTTINGHAM TWP'S.

REVISIONS

TABULATION OF QUANTITIES		
ITEM	UNIT	QUANTITY
POST MOUNTED SIGNS, TYPE A, LOGO	SQ.FT.	
POST MOUNTED SIGNS, TYPE B, LOGO	SQ.FT.	
POST MOUNTED SIGNS, TYPE C, LOGO	SQ.FT.	
BREAKAWAY SYSTEMS	EACH	
* STEEL S OR W BEAM POSTS	LBS.	
LOGO SIGN MOUNTING	EACH	
REMOVAL OF POST MOUNTED MOTORIST SERVICE SIGNS, TYPES A & E	EACH	
REMOVAL OF POST MOUNTED MOTORIST SERVICE SIGNS, TYPES B, C & F	L.S.	

* APPROXIMATE QUANTITY FOR INFORMATION ONLY

SYMBOLS

- ○ *Existing Sign to Remain*
- △ *Existing Sign to be Removed*
- □ *Existing Sign Reset as Shown*
- ● NEW SIGN
- × FUTURE SIGN
- Ø *Existing Utility Pole*

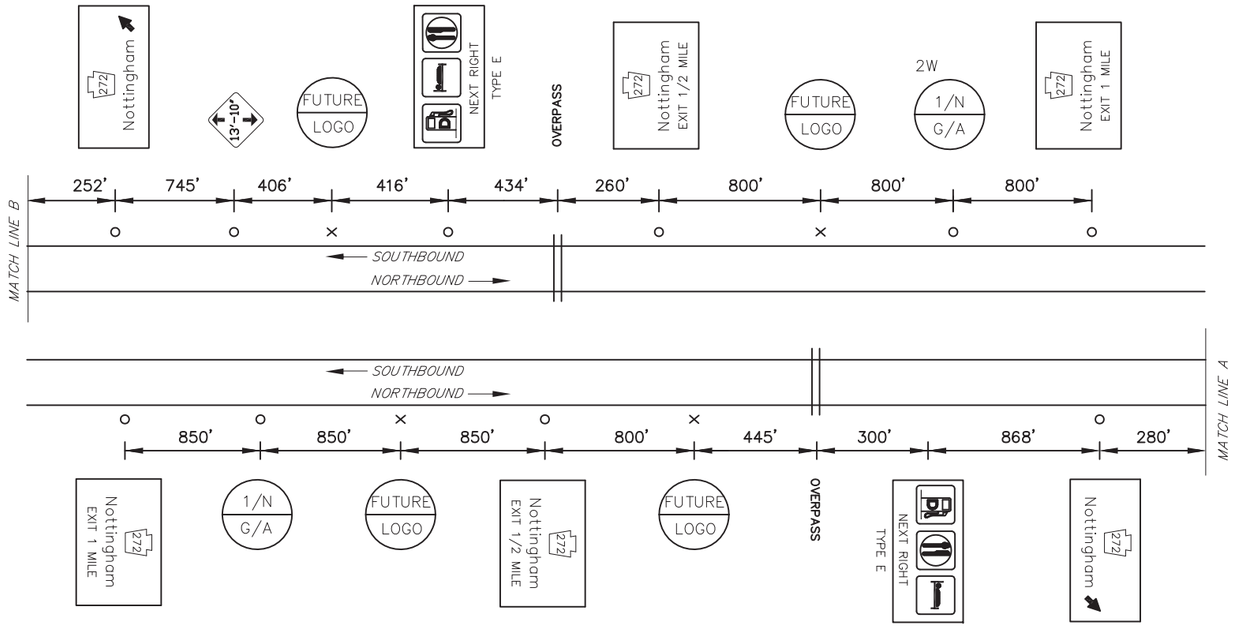

MAINLINE SCHEMATIC

NOT TO SCALE

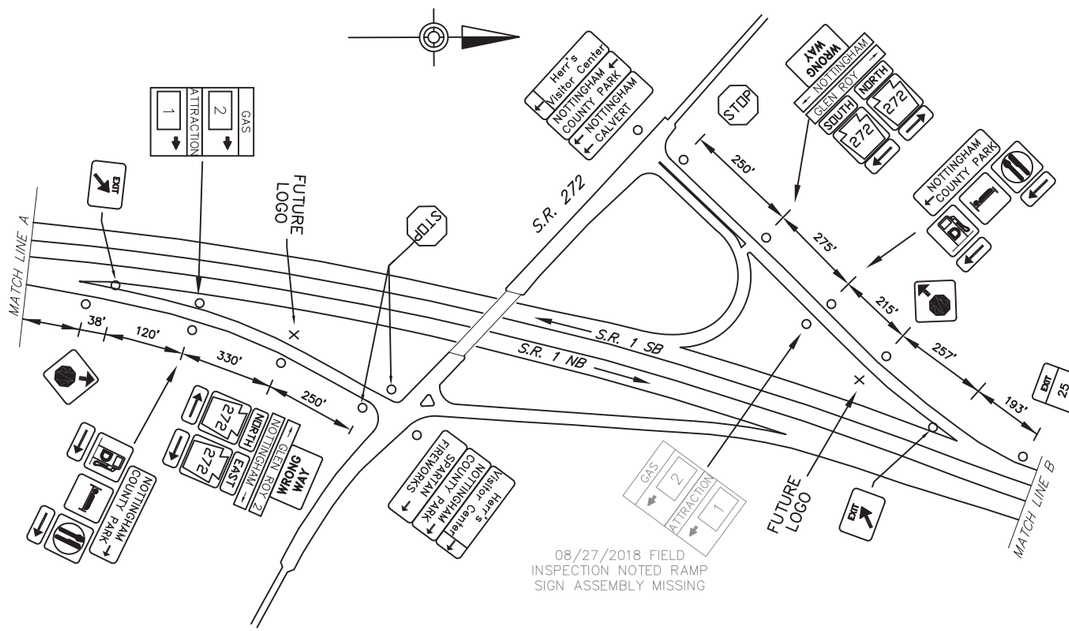

SCHEMATIC PLAN

NOT TO SCALE

NOTTINGHAM EXIT SPECIFIC INFORMATION PANEL			
SIGN NUMBER	LEGEND	BUSINESS	LOGO. NO.
1/N A NB	ATTRACTION	HERR'S SNACK FACTORY TOUR	1
1/N A SB			
1/N G NB	GAS	WAWA	2
1/N G SB			

NB SIGNS

13.5'Hx13'W
FUTURE 16'H
W12x26 A572
3M TYPE III
B650 – #1, #1

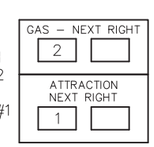

SB SIGNS

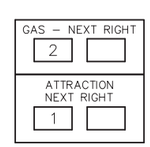

13.5'Hx13'W
FUTURE 14'H
W14x30 A572
3M TYPE III
B650 – #1, #1

ATTRACTION PANEL DIMENSIONS ARE 7.5'H x 13'W

1

S.R. 272

NOTTINGHAM

D:\2015JOBS\25076-01\HW\PSE\AS-BUILT DRAWINGS\PENNDOT DISTRICT 06\CHESTER - 15\10-XX SHTXX_US1 NOTTINGHAM EXIT PLAN
September/14/2018 11:13 AM