DISTRICT	COUNTY	ROUTE	PROJECT	SHEET
6-0	MONTGOMERY	US-422		
UPPER PROVIDENCE TOWNSHIP				
REVISIONS				

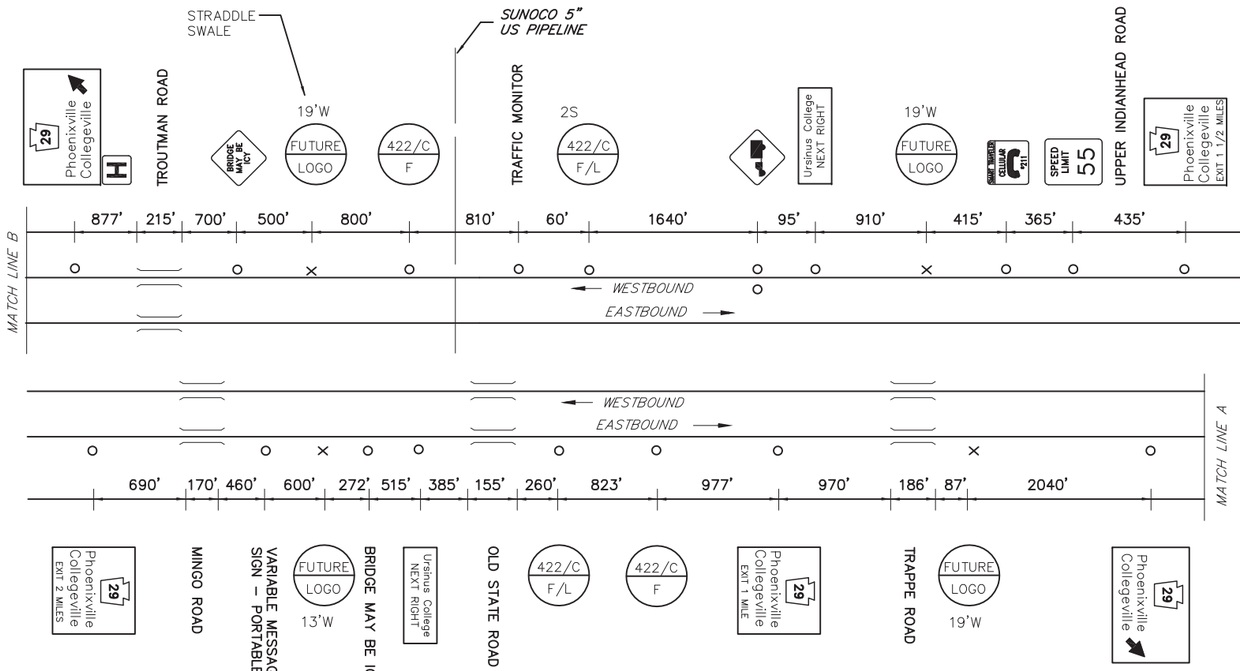

MAINLINE SCHEMATIC
NOT TO SCALE

TABULATION OF QUANTITIES		
ITEM	UNIT	QUANTITY
POST MOUNTED SIGNS, TYPE A, LOGO	SQ.FT.	
POST MOUNTED SIGNS, TYPE B, LOGO	SQ.FT.	
POST MOUNTED SIGNS, TYPE C, LOGO	SQ.FT.	
BREAKAWAY SYSTEMS	EACH	
* STEEL S OR W BEAM POSTS	LBS.	
LOGO SIGN MOUNTING	EACH	
REMOVAL OF POST MOUNTED MOTORIST SERVICE SIGNS, TYPES A, B, C, E & F	L.S.	-

* APPROXIMATE QUANTITY FOR INFORMATION ONLY

SYMBOLS

- ○ *Existing Sign to Remain*
- △ *Existing Sign to be Removed*
- □ *Existing Sign Reset as Shown*
- ● NEW SIGN
- × FUTURE SIGN
- Ø *Existing Utility Pole*

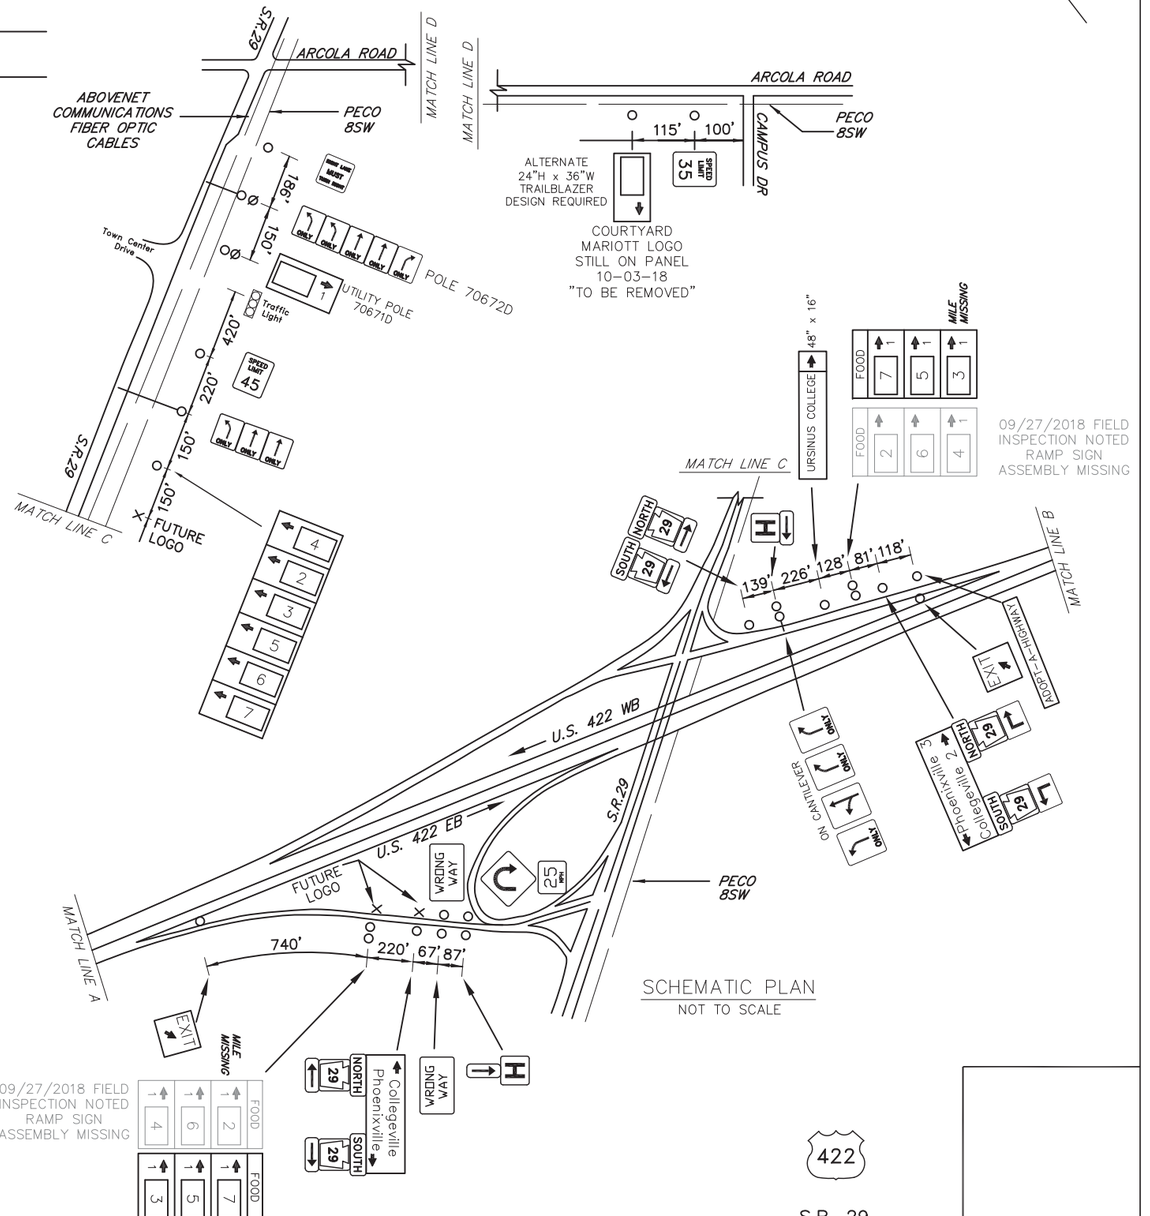

SCHEMATIC PLAN
NOT TO SCALE

LANE CLOSURES ONLY PERMITTED
ON MONDAYS THROUGH FRIDAYS
AND BETWEEN 9:00 AM AND 3:00 PM.

OBTAIN APPROVAL FROM PENNDOT DISTRICT 6-0
TRAFFIC UNIT AT LEAST TWO WEEKS PRIOR
TO ANY LANE CLOSURES.

COLLEGEVILLE SPECIFIC INFORMATION PANEL			
SIGN NUMBER	LEGEND	BUSINESS	LOGO. NO.
422/C L EB 422/C L WB	LODGING		
422/C F EB 422/C F WB	FOOD	OLIVE GARDEN	2
		WEGMAN'S MARKET CAFE	3
		ELEVATION BURGER	4
		RED ROBIN	5
		PANERA BREAD	6
		STARBUCKS	7

EB SIGNS

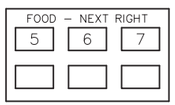

10'Hx19'W
FUTURE 12'H
W14x30 A572
TYPE IX LEGEND
TYPE III/IV BACKGROUND
B650 - #2, #2

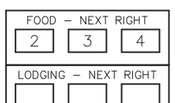

12'Hx19'W
W14x30
3M TYPE IX LEGEND
TYPE III BACKGROUND
B650 - #2, #1

WB SIGNS

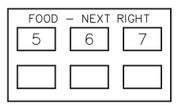

10'Hx19'W
FUTURE 12'H
W8x21 A572
TYPE IX LEGEND
TYPE III/IV BACKGROUND
B525 - #1, #2

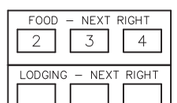

12'Hx19'W
W12x26
3M TYPE IX LEGEND
TYPE III BACKGROUND
B650 - #2, #2

422

S.R. 29

COLLEGEVILLE

D:\2015_ADB\215076-01\WX\PSE\AS-BUILT DRAWINGS\PENNDOT DISTRICT 06\MONTGOMERY - 4X10-XX_SHTXX US422_COLLEGEVILLE PLAN
October/3/2018 10:23 AM