DISTRICT	COUNTY	ROUTE	PROJECT	SHEET
1-0	ERIE	I-86		
GREENFIELD TOWNSHIP				
REVISIONS				

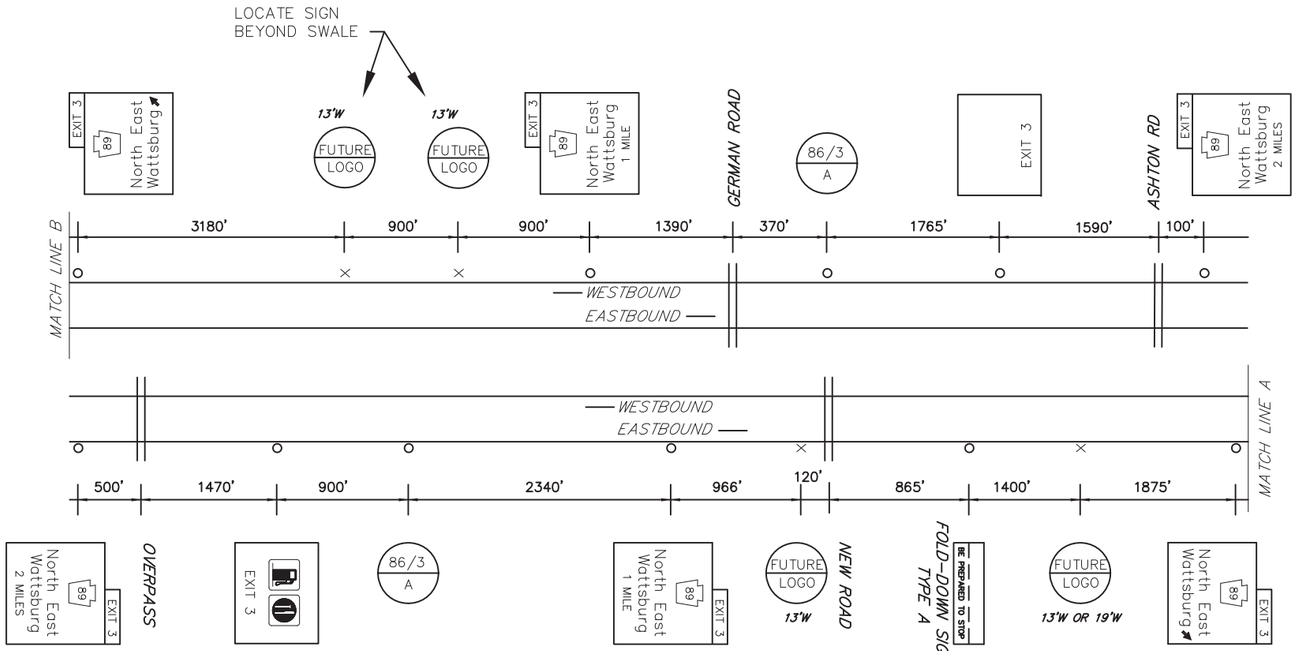

MAINLINE SCHEMATIC
NOT TO SCALE

TABULATION OF QUANTITIES		
ITEM	UNIT	QUANTITY
POST MOUNTED SIGNS, TYPE A, LOGO	SQ.FT.	
POST MOUNTED SIGNS, TYPE B, LOGO	SQ.FT.	
POST MOUNTED SIGNS, TYPE C, LOGO	SQ.FT.	
BREAKAWAY SYSTEMS	EACH	
* STEEL S OR W BEAM POSTS	LBS.	
LOGO SIGN MOUNTING	EACH	
FLAT SHEET PANEL REPLACEMENT	SQ. FT.	–
EXTRUDED PANEL REPLACEMENT	SQ. FT.	–
REMOVAL OF POST MOUNTED MOTORIST SERVICE SIGNS, TYPES B, C & F	L.S.	

* APPROXIMATE QUANTITY FOR INFORMATION ONLY

SYMBOLS

- ○ *Existing Sign to Remain*
- △ *Existing Sign to be Removed*
- □ *Existing Sign Reset as Shown*
- ● NEW SIGN
- × FUTURE SIGN
- Ø *Existing Utility Pole*

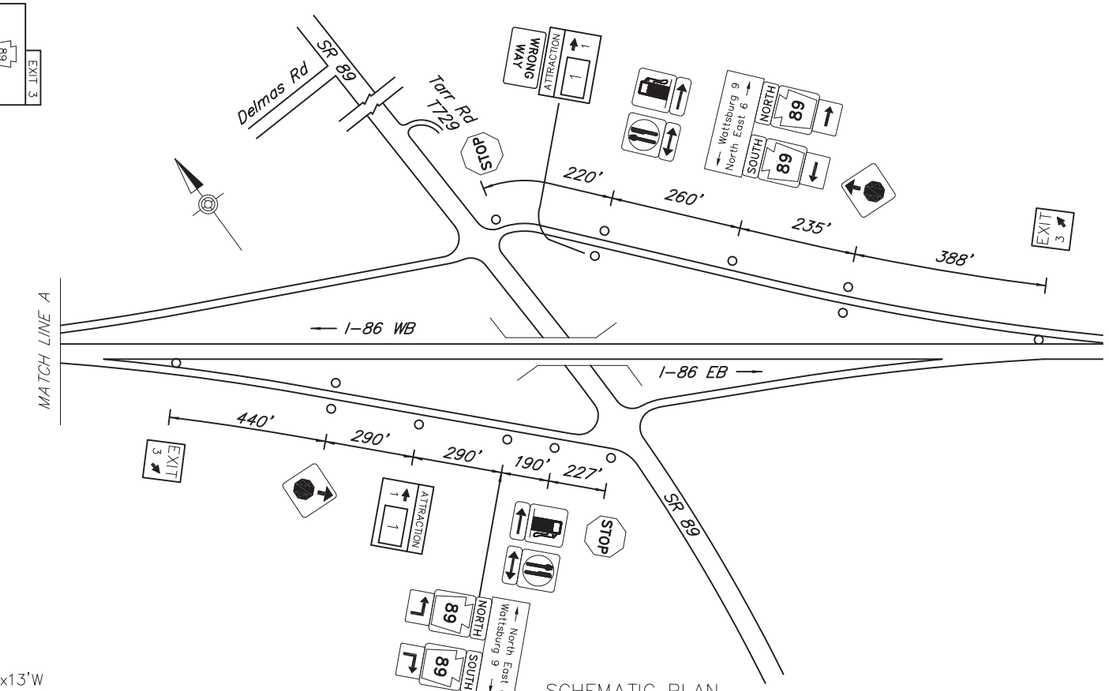

SCHEMATIC PLAN
NOT TO SCALE

EXIT 3 SPECIFIC INFORMATION PANEL			
SIGN NUMBER	LEGEND	BUSINESS	LOGO. NO.
86/3 A EB 86/3 A WB	ATTRACTION	LAKE ERIE SPEEDWAY	1

EB SIGNS

6'Hx13'W
FUTURE 16'H
W14x30
3M TYPE III
B650 – #2, #2

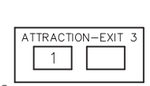

WB SIGNS

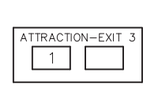

6'Hx13'W
FUTURE 16'H
W14x30
3M TYPE III
B650 – #2, #2

INTERSTATE 86

NORTH EAST, PA 89

EXIT 3

D:\2015JOBS\25076-01\WW\PSE\AS-BUILT DRAWINGS\PENNDOT DISTRICT 01\ERIE - 25\10-XX SHTOX-I86_EXIT 3
October/2/2018 1:24 PM