DISTRICT	COUNTY	ROUTE	PROJECT	SHEET
1-0	ERIE	I-90		
GREENE & SUMMIT TOWNSHIPS				
REVISIONS				

TABULATION OF QUANTITIES		
ITEM	UNIT	QUANTITY
POST MOUNTED SIGNS, TYPE A, LOGO	SQ.FT.	
POST MOUNTED SIGNS, TYPE B, LOGO	SQ.FT.	
POST MOUNTED SIGNS, TYPE C, LOGO	SQ.FT.	
BREAKAWAY SYSTEMS	EACH	
* STEEL S OR W BEAM POSTS	LBS.	
LOGO SIGN MOUNTING	EACH	
RESET EXISTING POST MOUNTED SIGNS, TYPE A	EACH	

* APPROXIMATE QUANTITY FOR INFORMATION ONLY

SYMBOLS

- ○ *Existing Sign to Remain*
- △ *Existing Sign to be Removed*
- □ *Existing Sign Reset as Shown*
- ● NEW SIGN
- × FUTURE SIGN
- Ø *Existing Utility Pole*

LESS THAN 800-FT SPACING
AS DIRECTED BY DISTRICT 1-0.

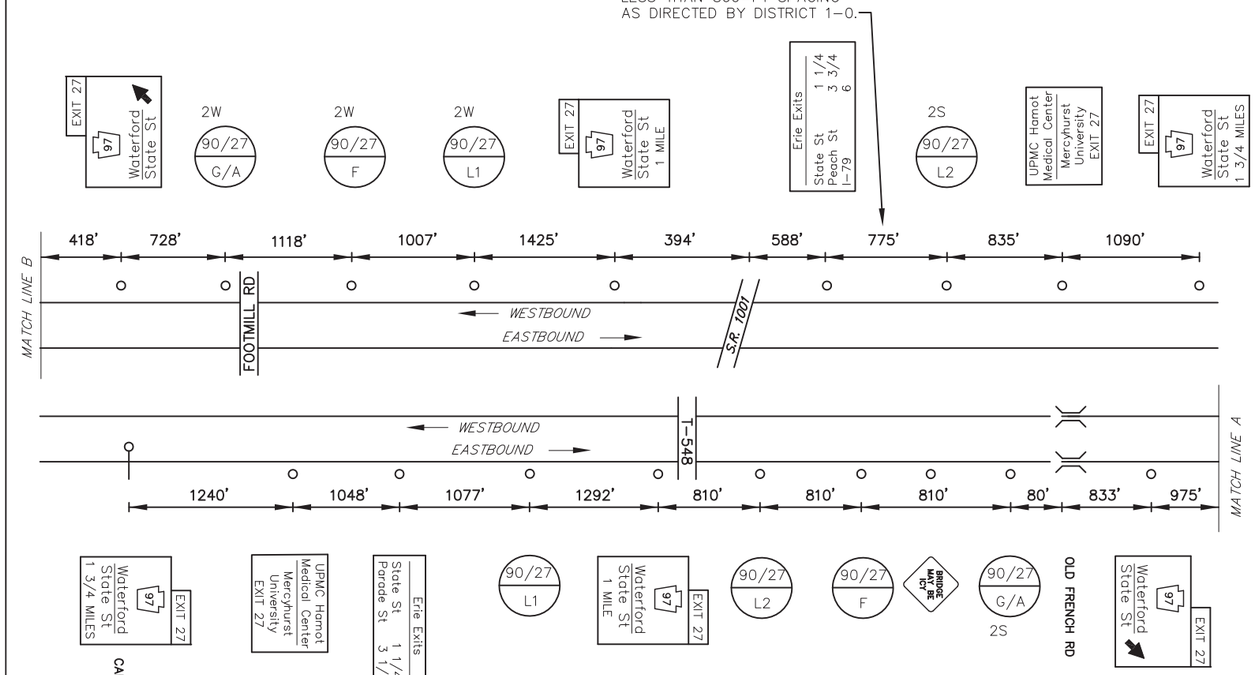

MAINLINE SCHEMATIC
NOT TO SCALE

DO NOT CLOSE OR RESTRICT TRAVEL LANES
BETWEEN 7:00 AM FRIDAY AND 7:00 AM MONDAY.
RE-OPEN CLOSED LANES IF SIGNIFICANT
TRAFFIC CONGESTION IS OBSERVED.
DO NOT WORK DURING HOLIDAY PERIODS.

EXIT 27 SPECIFIC INFORMATION PANEL			
SIGN NUMBER	LEGEND	BUSINESS	LOGO. NO.
90/27 L EB 90/27 L WB	LODGING	BAYMONT INN & SUITES	16
		RED ROOF INN	4
		DAYS INN	6
		QUALITY INN	7
		SUPER 8	8
		MOTEL 6	5
		LA QUINTA	10
90/27 F EB 90/27 F WB	FOOD	McDONALD'S (24 HRS)	1
		SUBWAY (24 HOURS)	2
		ARBY'S	3
		TIM HORTON'S CAFE & BAKE SHOP	13
		TACO BELL	17
90/27 G EB 90/27 G WB	GAS	COUNTRY FAIR CITGO (DIESEL)	9
		SHELL (Diesel/24 Hours)	12
		SHEETZ (DIESEL)	15
90/27 A EB 90/27 A WB	ATTRACTION	PRESQUE ISLE DOWNS & CASINO	11
		ERIE ZOO	14

EB SIGNS

16'Hx13'W
W10x26
B650 – #1, #1

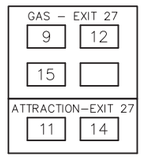

14'Hx13'W
FUTURE 16'H
W10x26
B650 – #1, #1

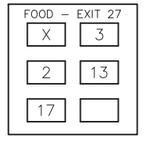

L2
6'Hx13'W
FUTURE 16'H
W14x30
TYPE IX LEGEND
TYPE III
BACKGROUND
B650 – #1, #2

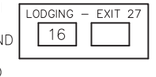

L1
14'Hx13'W
FUTURE 16'H
W10x26
B650 – #1, #1

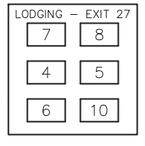

WB SIGNS

16'Hx13'W
W14x30
B650 – #2, #2

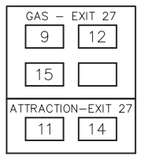

14'Hx13'W
FUTURE 14'H
W12x26
B650 – #2, #1

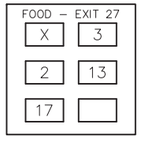

L1
14'Hx13'W
W12x26
B650 – #2, #1

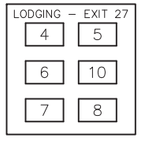

L2
6'Hx13'W
FUTURE 16'H
W18x40
TYPE IX LEGEND
TYPE III
BACKGROUND
B650 – #3, #3

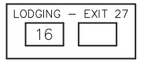

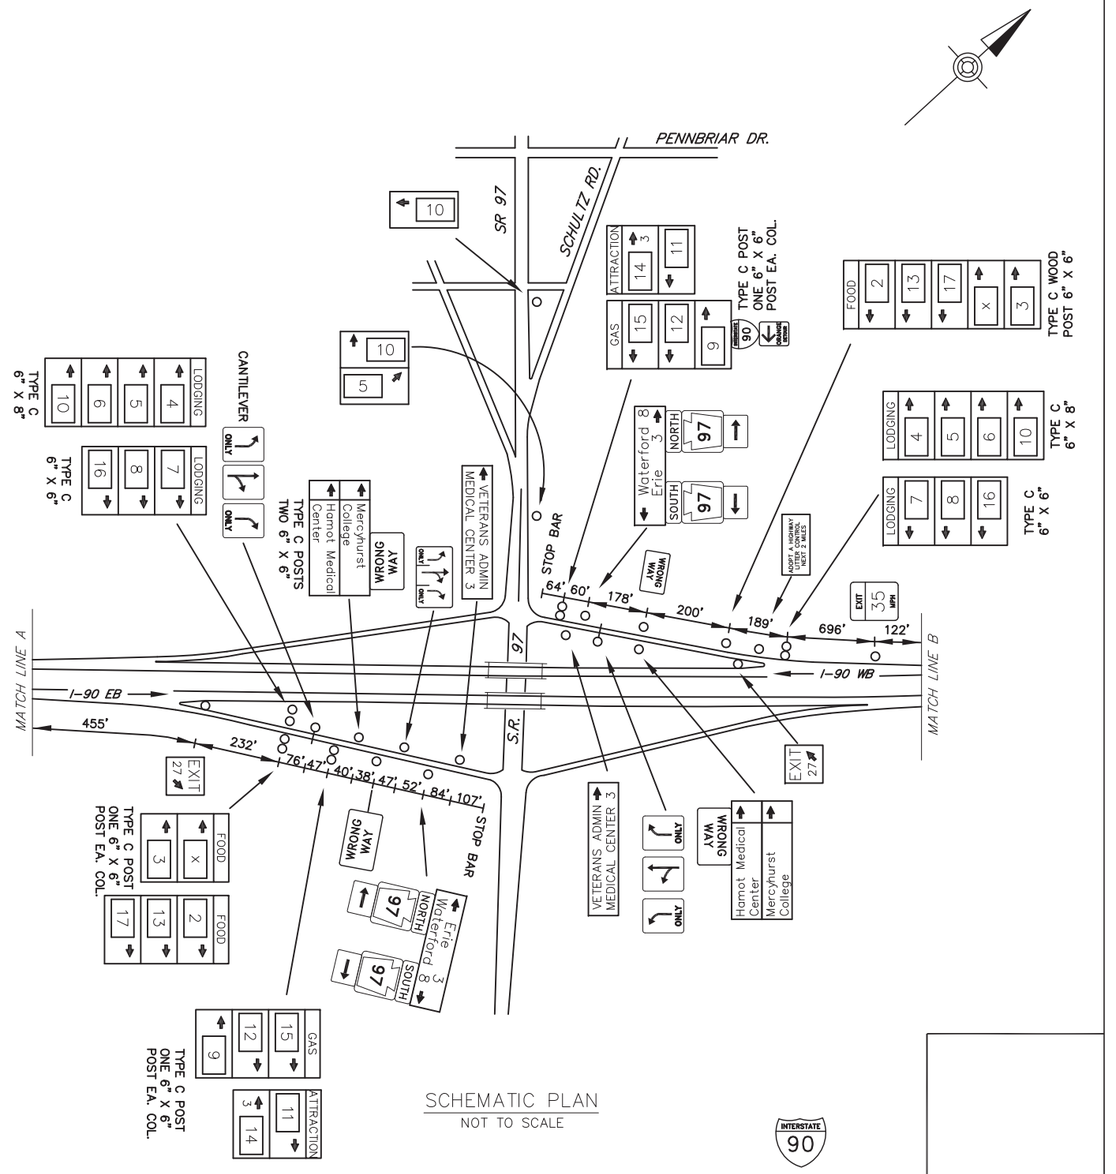

SCHEMATIC PLAN
NOT TO SCALE

INTERSTATE 90

STATE STREET
EXIT 27

D:\2015\ERI\215976-01\MKP\PSE\AS-BUILT DRAWINGS\PENNDOT DISTRICT 10\ERIE - 2015\0-XX SMTXX-190_EXIT 27 PLAN
October/2/2018 3:25 PM