DISTRICT	COUNTY	ROUTE	PROJECT	SHEET
1-0	ERIE	I-90		

MILL CREEK, GREENE, HARBORCREEK AND SUMMIT TOWNSHIPS

REVISIONS

TABULATION OF QUANTITIES		
ITEM	UNIT	QUANTITY
POST MOUNTED SIGNS, TYPE A, LOGO	SQ.FT.	
POST MOUNTED SIGNS, TYPE C, LOGO	SQ.FT.	
BREAKAWAY SYSTEMS	EACH	
STEEL W BEAM BREAKAWAY POSTS	LBS.	
LOGO SIGN MOUNTING	EACH	
FLAT SHEET PANEL REPLACEMENT	SQ. FT.	
EXTRUDED PANEL REPLACEMENT	SQ. FT.	
REMOVAL OF POST MOUNTED MOTORIST SERVICE SIGNS, TYPES B, C & F	L.S.	

* APPROXIMATE QUANTITY FOR INFORMATION ONLY

SYMBOLS

- ○ *Existing Sign to Remain*
- △ *Existing Sign to be Removed*
- □ *Existing Sign Reset as Shown*
- ● NEW SIGN
- × FUTURE SIGN
- Ø *Existing Utility Pole*

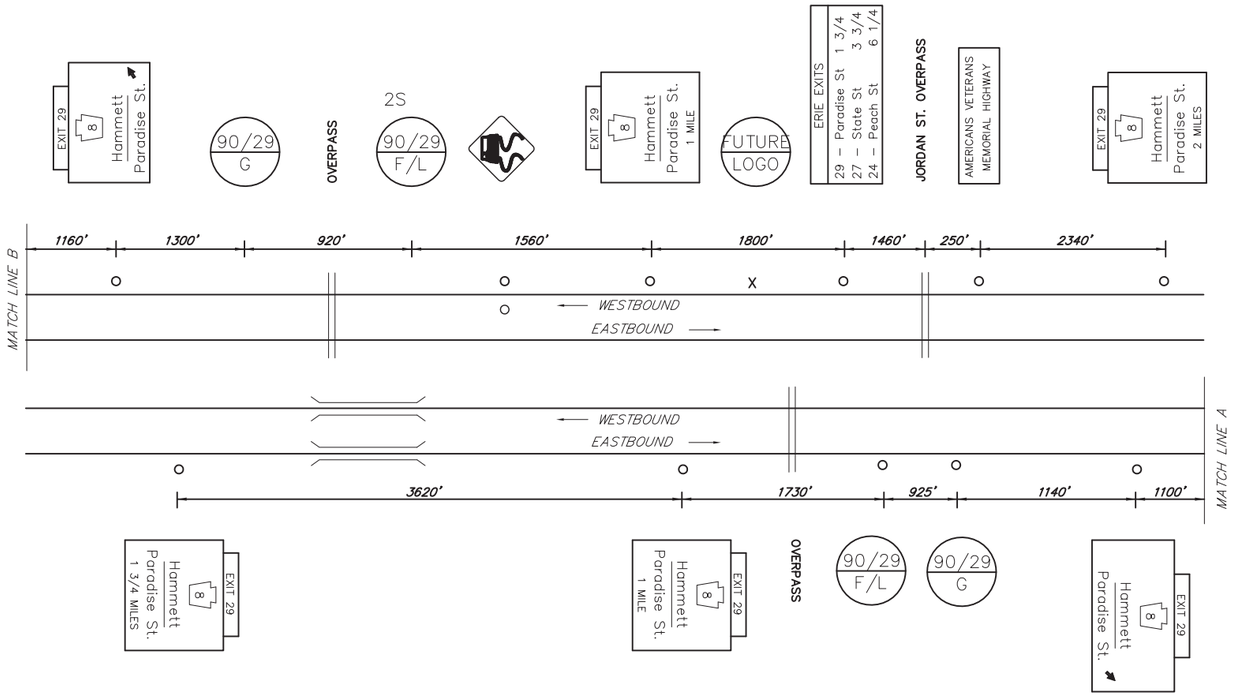

MAINLINE SCHEMATIC
NOT TO SCALE

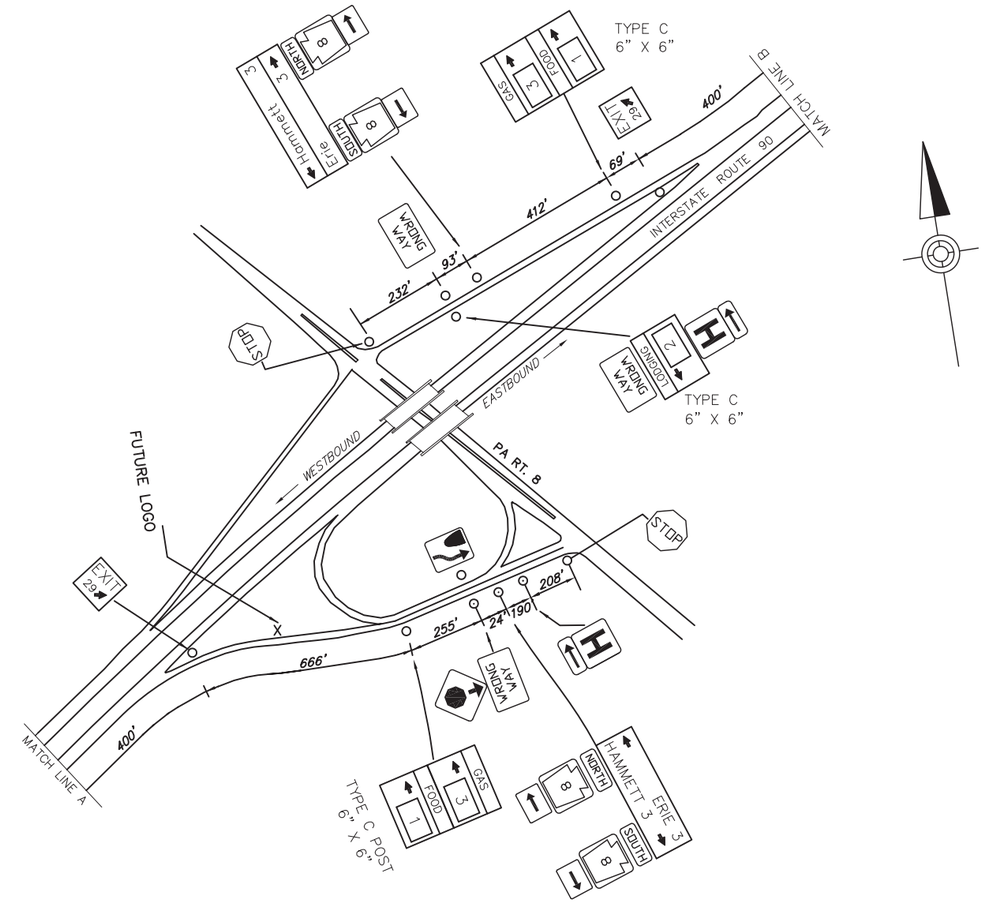

SCHEMATIC PLAN
NOT TO SCALE

EXIT 29 SPECIFIC INFORMATION PANEL			
SIGN NUMBER	LEGEND	BUSINESS	LOGO. NO.
90/29F EB 90/29F WB	FOOD	WENDY'S	1
90/29L EB 90/29L WB	LODGING	AMERICA'S BEST VALUE INN	2
90/29G EB 90/29G WB	GAS	COUNTRY FAIR CITGO	3

EB SIGNS

12'Hx19'W
W12x26
B650 – #2, #2

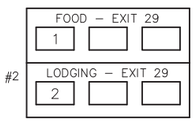

6'Hx19'W
FUTURE 12'H
W12x26
B650 – #2, #2

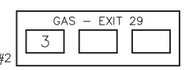

WB SIGNS

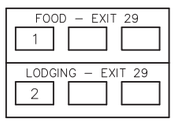

12'Hx19'W
W12x26
B650 – #3, #3

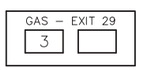

6'Hx13'W
FUTURE 16'H
W14x30
B650 – #2, #2

INTERSTATE 90

HAMMETT / PARADE ST

EXIT 29

D:\2015_ID\87\215976-01\MVPSE\AS-BUILT DRAWINGS\PENNDOT DISTRICT 01\ERIE - 215\0-XX SHTXX-190_EXIT 29 PLAN
October/2/2018 3:39 PM