DISTRICT	COUNTY	ROUTE	PROJECT	SHEET
1-0	ERIE	I-90		
HARBOR CREEK TOWNSHIP				
REVISIONS				

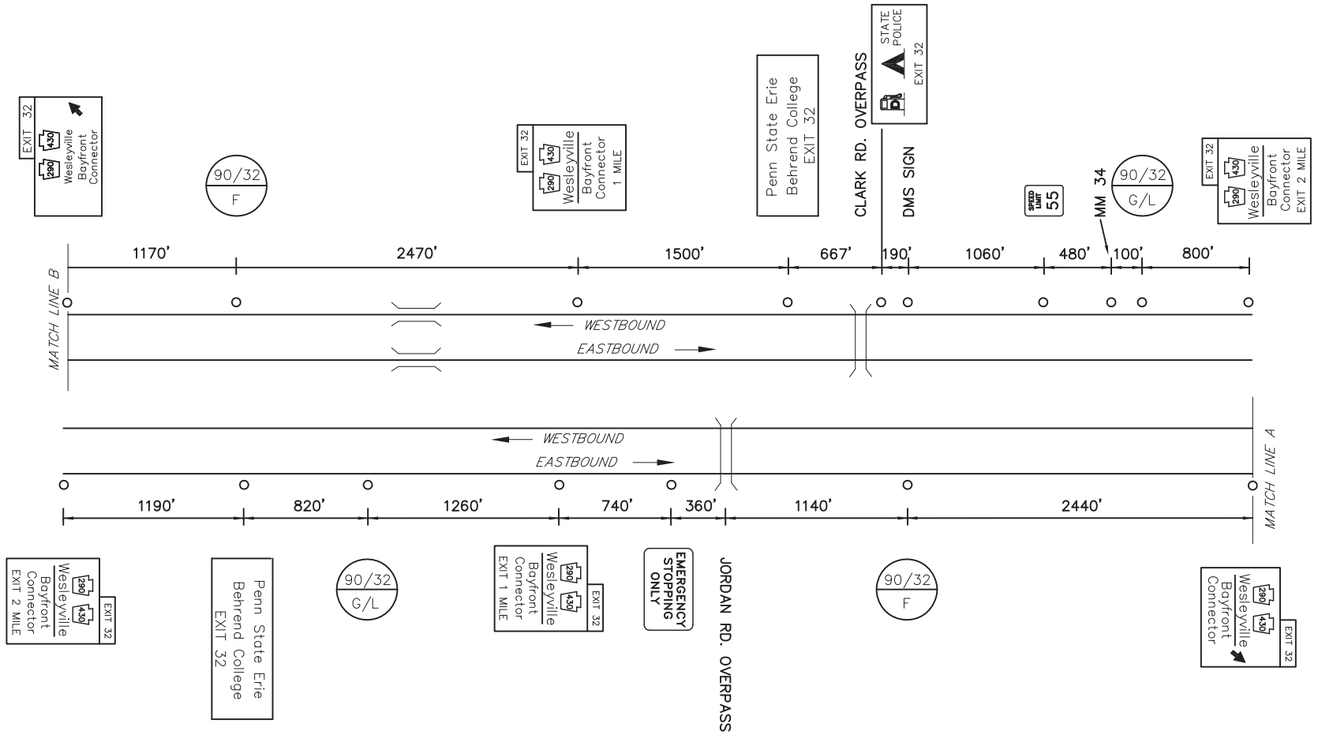

MAINLINE SCHEMATIC
NOT TO SCALE

TABULATION OF QUANTITIES		
ITEM	UNIT	QUANTITY
POST MOUNTED SIGNS, TYPE A, LOGO	SQ.FT.	–
POST MOUNTED SIGNS, TYPE B, LOGO	SQ.FT.	–
POST MOUNTED SIGNS, TYPE C, LOGO	SQ.FT.	–
BREAKAWAY SYSTEMS	EACH	–
* STEEL S OR W BEAM POSTS	LBS.	–
LOGO SIGN MOUNTING	EACH	–

* APPROXIMATE QUANTITY FOR INFORMATION ONLY

SYMBOLS

- ○ *Existing Sign to Remain*
- △ *Existing Sign to be Removed*
- □ *Existing Sign Reset as Shown*
- ● NEW SIGN
- × FUTURE SIGN
- Ø *Existing Utility Pole*

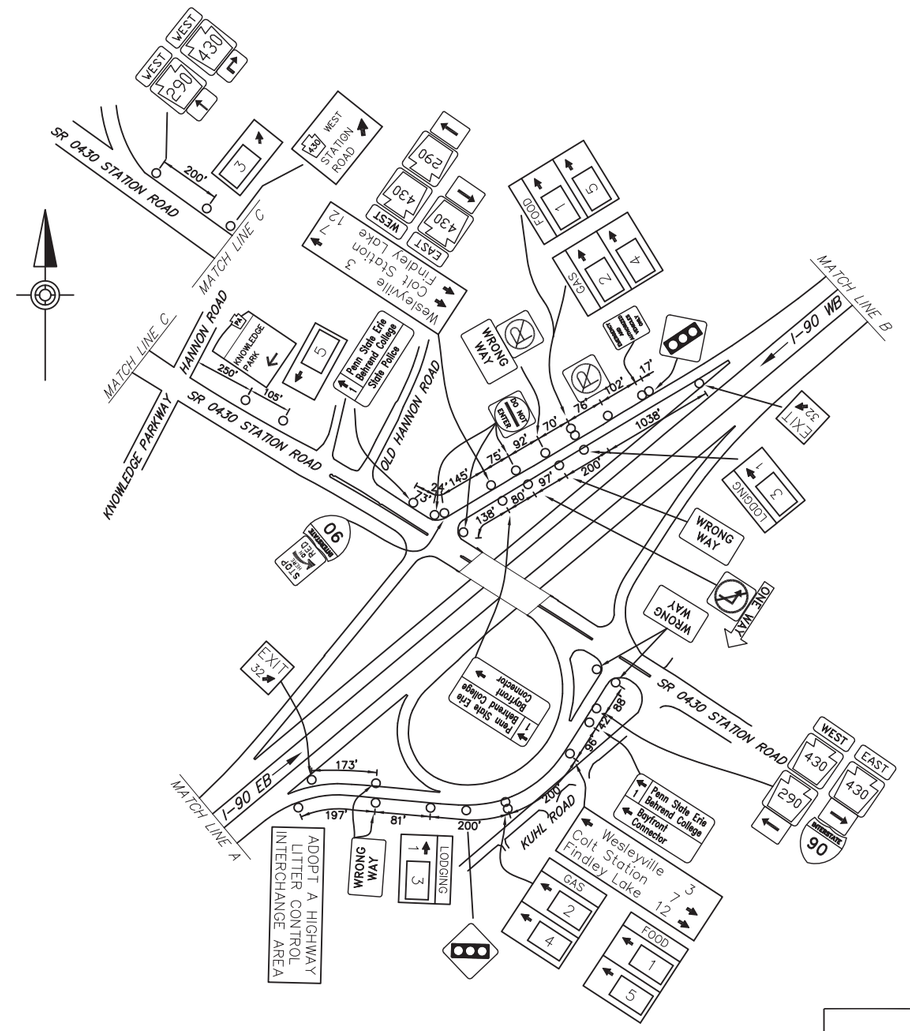

SCHEMATIC PLAN
NOT TO SCALE

NO LANE CLOSURES BETWEEN
6:00 AM & 9:00 AM AND
3:00 PM & 6:00 PM
NO LANE RESTRICTIONS PERMITTED
DURING HOLIDAY PERIODS.

EXIT 32 SPECIFIC INFORMATION PANEL			
SIGN NUMBER	LEGEND	BUSINESS	LOGO. NO.
90/32 F EB 90/32 F WB	FOOD	GETGO	1
		ERIE BREWING COMPANY	5
90/32 G EB 90/32 G WB	GAS	GETGO (DIESEL)	2
		COUNTRY FAIR CITGO (DIESEL)	4
90/32 L EB 90/32 L WB	LODGING	COBBLESTONE HOTEL & SUITES	3

	EB SIGNS	WB SIGNS	
6'Hx13'W FUTURE 16'H W10x26 A572 3M TYPE IV B650 – #1, #1	FOOD–EXIT 32 1 5	FOOD–EXIT 32 1 5	6'Hx13'W FUTURE 16'H W14x30 A572 3M TYPE IV B650 – #1, #1
12'Hx13'W FUTURE 16'H W14x30 A572 3M TYPE IV B650 – #1, #1	GAS–EXIT 32 2 4 LODGING–EXIT 32 3	GAS–EXIT 32 2 4 LODGING–EXIT 32 3	12'Hx13'W FUTURE 16'H W18x40 A572 3M TYPE IV B650 – #2, #2

INTERSTATE 90
STATION ROAD
EXIT 32

D:\2015_JBS\215076-01\HW\PSE\AS-BUILT DRAWINGS\PENNDOT DISTRICT 01\ERIE - 25\10-XX SHTOX-190_EXIT 32 PLAN
October/2/2018 3:50 PM