DISTRICT	COUNTY	ROUTE	PROJECT	SHEET
1-0	ERIE	I-90		
HARBOR CREEK TOWNSHIP				
REVISIONS				

TABULATION OF QUANTITIES		
ITEM	UNIT	QUANTITY
POST MOUNTED SIGNS, TYPE A, LOGO	SQ.FT.	
POST MOUNTED SIGNS, TYPE B, LOGO	SQ.FT.	
POST MOUNTED SIGNS, TYPE C, LOGO	SQ.FT.	
BREAKAWAY SYSTEMS	EACH	
* STEEL S OR W BEAM POSTS	LBS.	
LOGO SIGN MOUNTING	EACH	
REMOVAL OF POST MOUNTED MOTORIST SERVICE SIGNS, TYPES A & E	EACH	
REMOVAL OF POST MOUNTED MOTORIST SERVICE SIGNS, TYPES B, C & F	L.S.	

* APPROXIMATE QUANTITY FOR INFORMATION ONLY

SYMBOLS

- ○ *Existing Sign to Remain*
- △ *Existing Sign to be Removed*
- □ *Existing Sign Reset as Shown*
- ● NEW SIGN
- × FUTURE SIGN
- Ø *Existing Utility Pole*

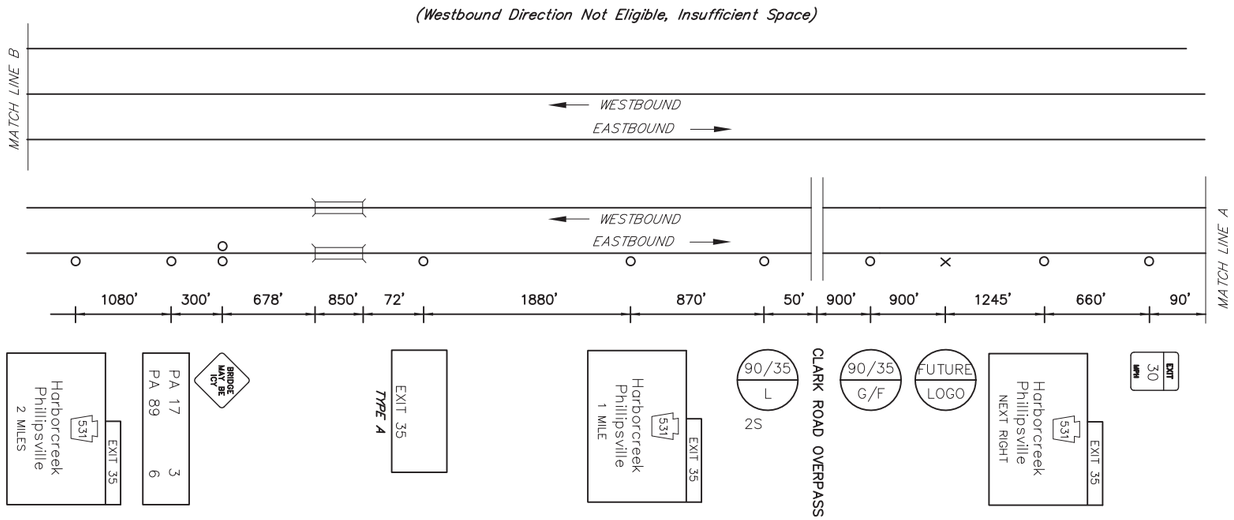

MAINLINE SCHEMATIC
NOT TO SCALE

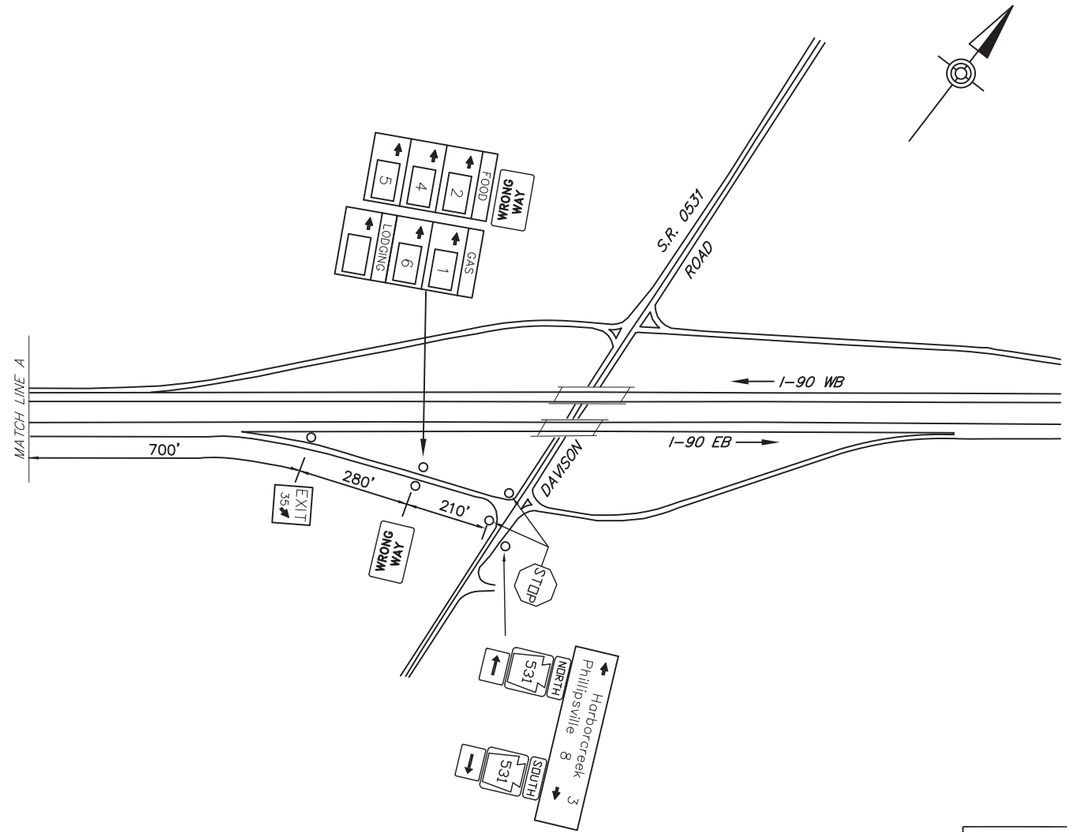

SCHEMATIC PLAN
NOT TO SCALE

EXIT 35 SPECIFIC INFORMATION PANEL			
SIGN NUMBER	LEGEND	BUSINESS	LOGO. NO.
90/35 F EB	FOOD	COUNTRY PRIDE RESTAURANT (24 HOURS)	2
		PIZZA HUT	4
		SUBWAY	5
90/35 G EB	GAS	BP #631	1
		TA (DIESEL)	6
90/35 L EB	LODGING		

EB SIGNS

12'Hx19'W
W14x30 A572
3M TYPE III
B650 – #2, #2

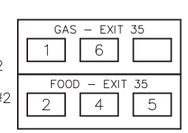

6'Hx13'W
W10x26
3M TYPE III
B650 – #1, #2

INTERSTATE 90
HARBORCREEK
EXIT 35

D:\2015_JOBS\215976-01\WV\PSE\AS-BUILT DRAWINGS\PENNDOT DISTRICT 01\ERIE - 25\10-XX SHTOX-190_EXIT 35 PLAN
October/2/2018 3:58 PM