DISTRICT	COUNTY	ROUTE	PROJECT	SHEET
11-0	BEAVER	I-376		
HOPEWELL TOWNSHIP				
11-0	ALLEGHENY			
MOON & FINDLAY TOWNSHIPS				
REVISIONS				

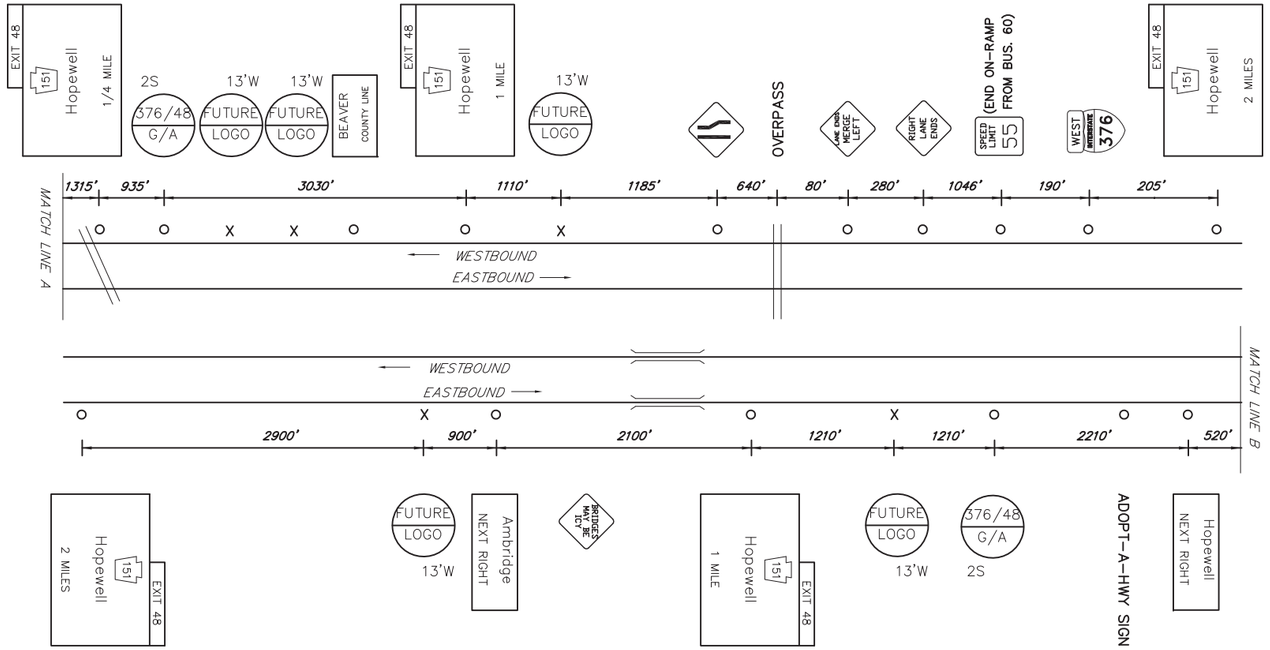

MAINLINE SCHEMATIC
NOT TO SCALE

TABULATION OF QUANTITIES		
ITEM	UNIT	QUANTITY
POST MOUNTED SIGNS, TYPE A, LOGO	SQ.FT.	
POST MOUNTED SIGNS, TYPE B, LOGO	SQ.FT.	
BREAKAWAY SYSTEMS	EACH	
* STEEL W BEAM BREAKAWAY POSTS	LBS.	
LOGO SIGN MOUNTING	EACH	
BREAKAWAY SYSTEM SUPPLIED BY TRUST	EACH	
REMOVAL OF POST MOUNTED MOTORIST SERVICE SIGNS, TYPES B, C & F	L.S.	—

* APPROXIMATE QUANTITY FOR INFORMATION ONLY

SYMBOLS

- ○ *Existing Sign to Remain*
- △ *Existing Sign to be Removed*
- □ *Existing Sign Reset as Shown*
- ● NEW SIGN
- × FUTURE SIGN
- Ø *Existing Utility Pole*

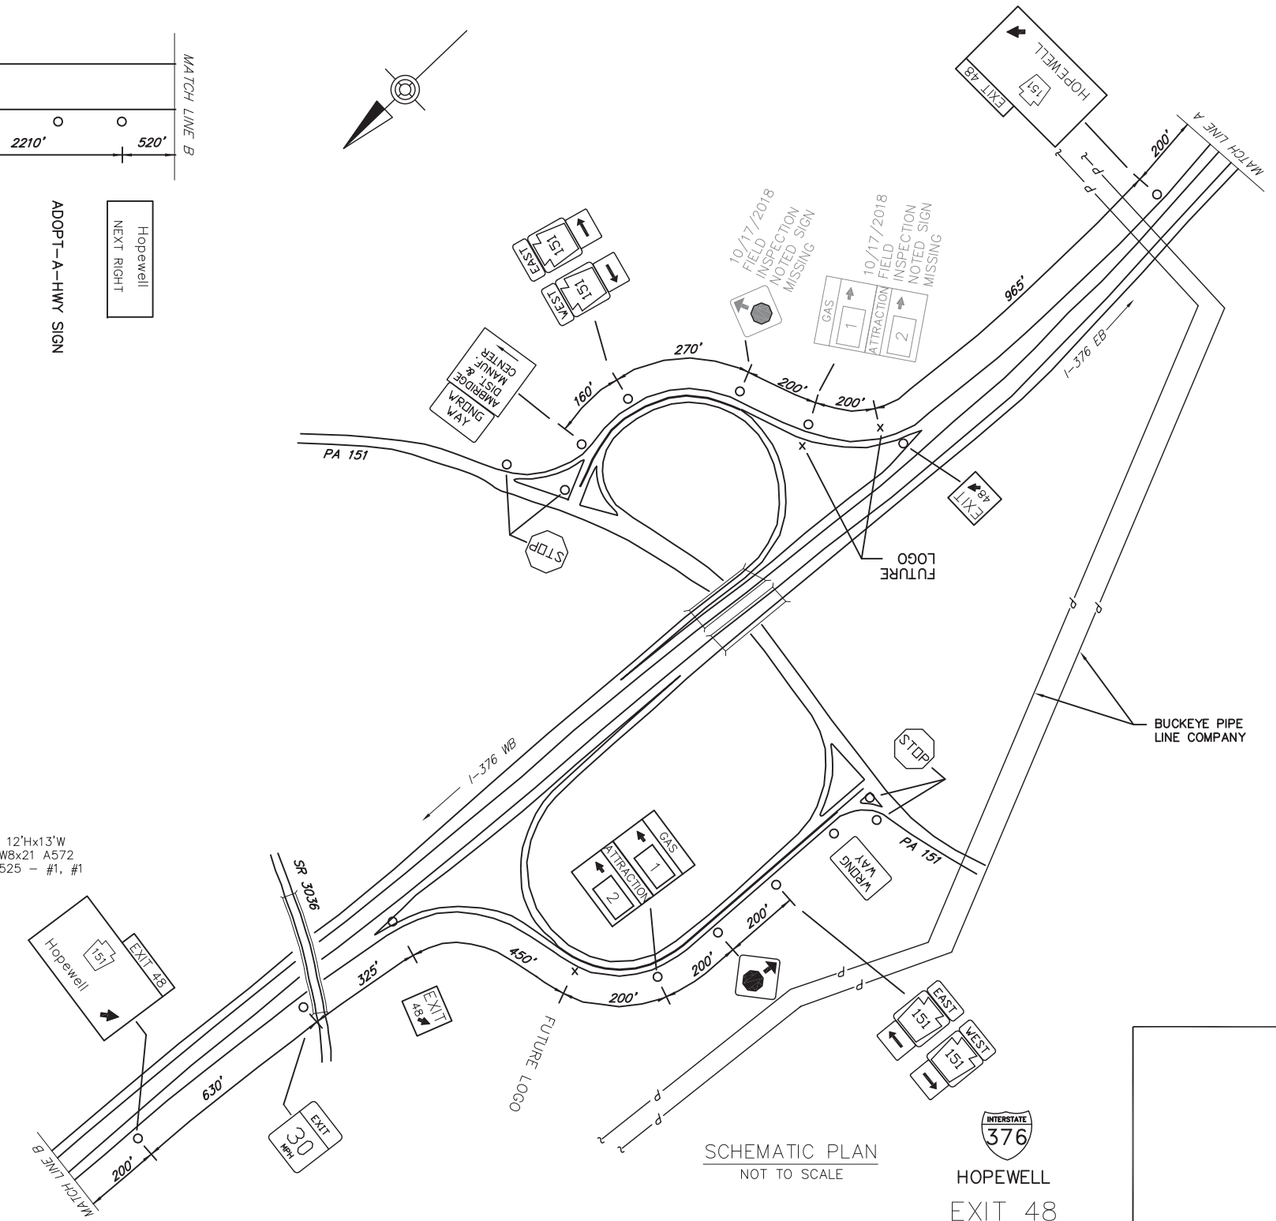

SCHEMATIC PLAN
NOT TO SCALE

HOPEWELL
EXIT 48
(OLD PA 60 EXIT 9)

EXIT 48 SPECIFIC INFORMATION PANEL			
SIGN NUMBER	LEGEND	BUSINESS	LOGO. NO.
376/48 G WB 376/48 G EB	GAS	CoGo's	1
376/48 A WB 376/48 A EB	ATTRACTION	HOPEWELL BUSINESS PARK	2

D:\2015JOBS\215976-01\HW\PSE\AS-BUILT DRAWINGS\PENNDOT DISTRICT 11\BEAVER - 04\10-XX SHTXX-1376_EXIT 48 PLAN
October/23/2018 11:54 AM