| DISTRICT | COUNTY | ROUTE | PROJECT | SHEET |
|---|---|---|---|---|
| 10-0 | INDIANA | U.S. 422 | | |
| WHITE TOWNSHIP | | | | |
| REVISIONS | | | | |

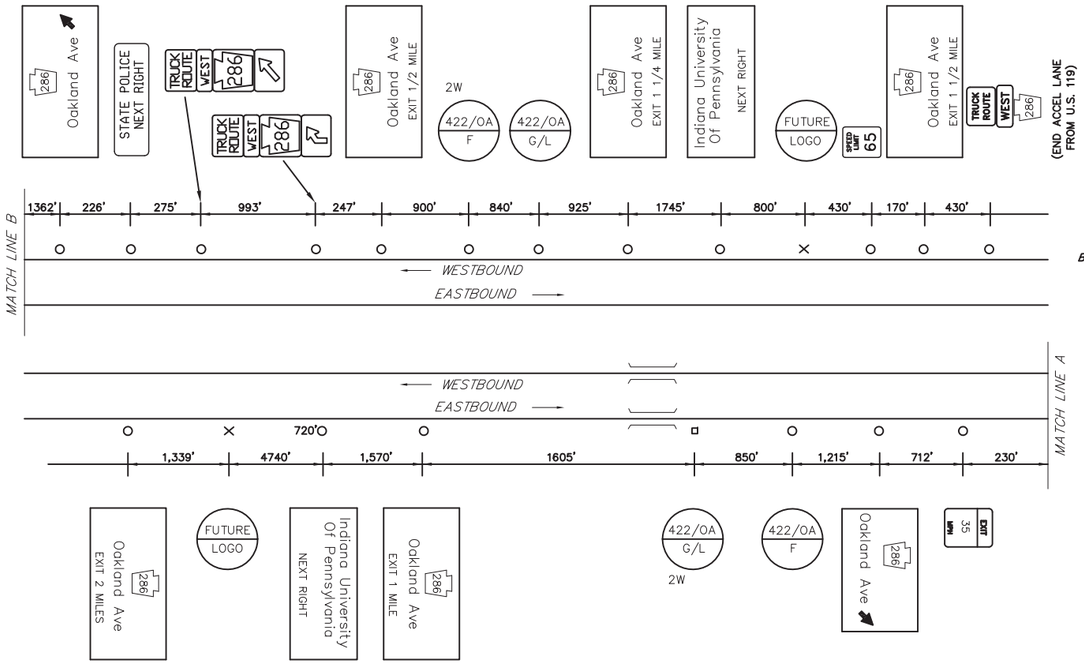


MAINLINE SCHEMATIC
NOT TO SCALE

| TABULATION OF QUANTITIES | | |
|---|---|---|
| ITEM | UNIT | QUANTITY |
| POST MOUNTED SIGNS, TYPE A | SQ.FT. | |
| POST MOUNTED SIGNS, TYPE B | SQ.FT. | |
| BREAKAWAY SYSTEMS | EACH | |
| * STEEL W BEAM BREAKAWAY POSTS | LBS. | |
| LOGO SIGN MOUNTING | EACH | |
| REMOVAL OF POST MOUNTED MOTORIST SERVICE SIGNS, TYPES A & E | EACH | |
| REMOVAL OF POST MOUNTED MOTORIST SERVICE SIGNS, TYPES B, C & F | L.S. | |

* APPROXIMATE QUANTITY FOR INFORMATION ONLY

SYMBOLS
- ○ *Existing Sign to Remain*
- △ *Existing Sign to be Removed*
- □ *Existing Sign Reset as Shown*
- ● NEW SIGN
- × FUTURE SIGN
- Ø *Existing Utility Pole*

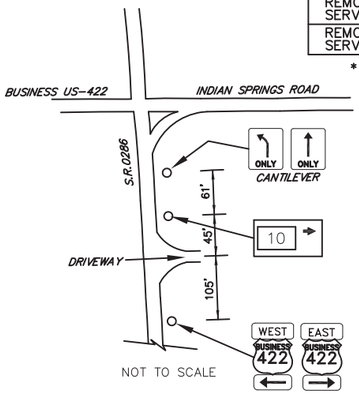


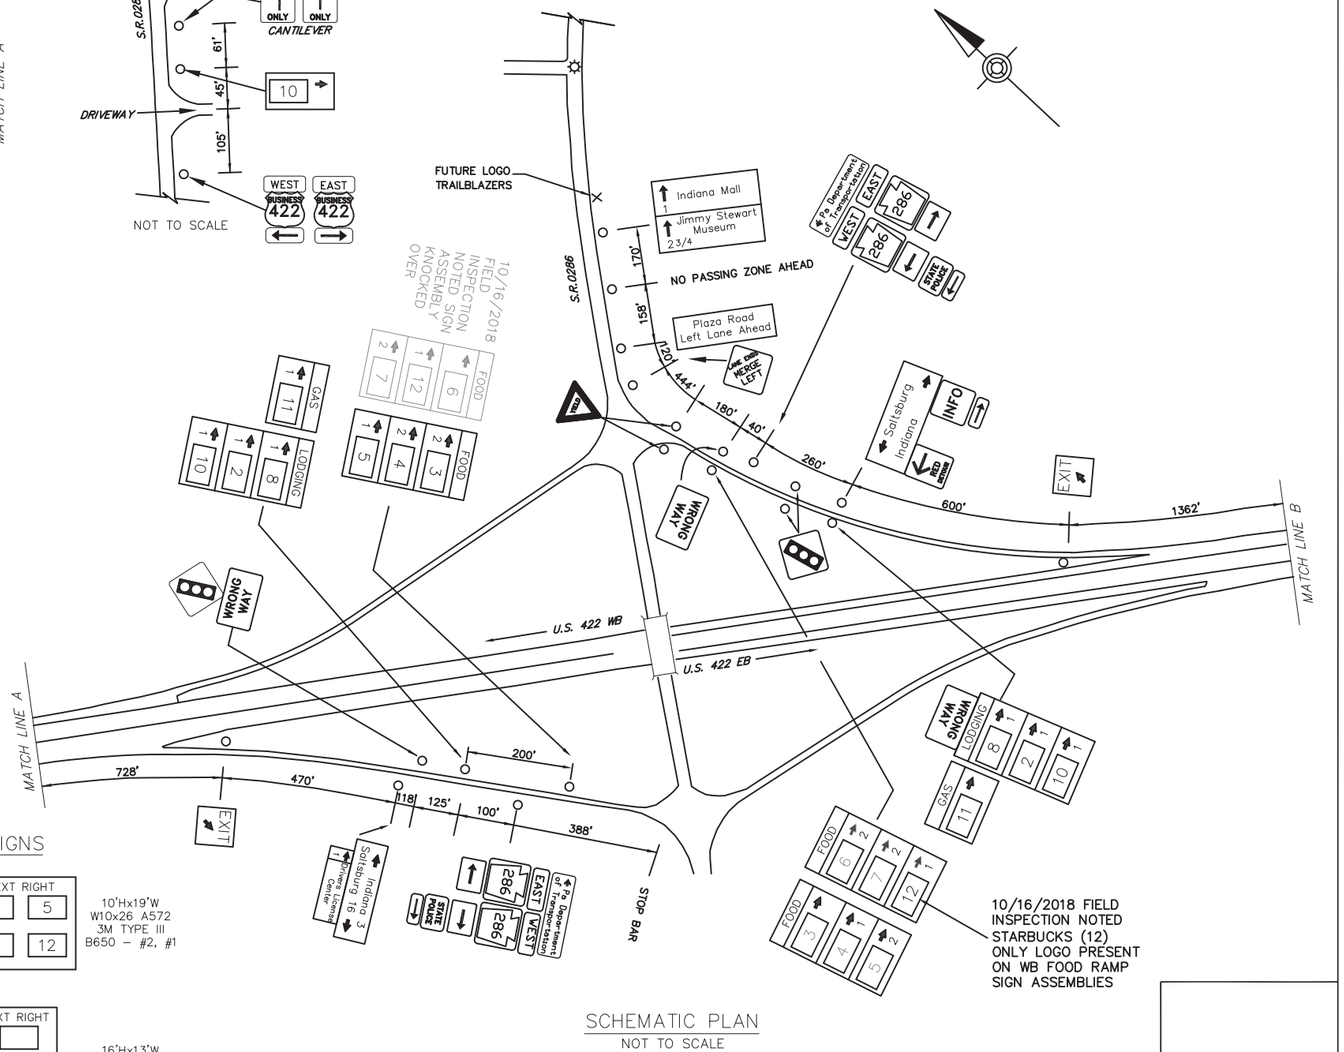


SCHEMATIC PLAN
NOT TO SCALE

FREEWAY LANE CLOSURES ONLY PERMITTED
MONDAY 7:00 AM THRU FRIDAY 8:00 AM.
ONLY ONE LANE CLOSURE PERMITTED AT A TIME.
LIMIT LANE CLOSURE LENGTHS TO 2,000 FEET OR LESS.
LANE CLOSURES REQUIRE SHADOW VEHICLE
(SEE PUB. 213 PATA 18).
RE-OPEN CLOSED LANES IF SIGNIFICANT QUEING IS OBSERVED.

WORK PROHIBITED DURING NIGHTTIME/HOURS OF DARKNESS.

| OAKLAND AVENUE SPECIFIC INFORMATION PANEL | | | |
|---|---|---|---|
| SIGN NUMBER | LEGEND | BUSINESS | LOGO. NO. |
| 422/OA F EB<br>422/OA F WB | FOOD | McDONALD'S | 3 |
| | | EAT'N PARK (24 HOURS) | 4 |
| | | WENDY'S | 5 |
| | | PERKINS FAMILY RESTAURANT | 6 |
| | | LONG JOHN SILVER'S | 7 |
| | | STARBUCKS | 12 |
| 422/OA G EB<br>422/OA G WB | GAS | GETGO | 11 |
| | | | |
| | | | |
| | | | |
| 422/OA L EB<br>422/OA L WB | LODGING | DAYS INN | 2 |
| | | BEST WESTERN | 8 |
| | | HAMPTON INN | 10 |
| | | | |

EB SIGNS

10'Hx19'W W10x22 A572 3M TYPE III B650 - #2, #2

| FOOD - NEXT RIGHT | | |
|---|---|---|
| 3 | 4 | 5 |
| 6 | 7 | 12 |

16'Hx13'W W12x26 A572 3M TYPE III B650 - #1, #1

AVERY TYPE IV

| GAS - NEXT RIGHT | |
|---|---|
| 11 | |
| LODGING-NEXT RIGHT | |
| 2 | 8 |
| 10 | |

WB SIGNS

| FOOD - NEXT RIGHT | | |
|---|---|---|
| 3 | 4 | 5 |
| 6 | 7 | 12 |

10'Hx19'W W10x26 A572 3M TYPE III B650 - #2, #1

16'Hx13'W W12x26 A572 TYPE IV B650 - #2, #2

AVERY TYPE IV

| GAS - NEXT RIGHT | |
|---|---|
| 11 | |
| LODGING-NEXT RIGHT | |
| 2 | 8 |
| 10 | |

422
PA 286
OAKLAND AVENUE

D:\2015_ADB\215076-01\WV\PSE\AS-BUILT DRAWINGS\PENNDOT DISTRICT 10\INDIANA - 32\10-XX_SHTXX US422 OAKLAND AVE PLAN
October/23/2018 1:46 PM