DISTRICT	COUNTY	ROUTE	PROJECT	SHEET
12-0	WESTMORELAND	I-70		

ROSTRAVER TOWNSHIP

REVISIONS

TABULATION OF QUANTITIES		
ITEM	UNIT	QUANTITY
POST MOUNTED SIGNS, TYPE A, LOGO	SQ.FT.	--
POST MOUNTED SIGNS, TYPE B, LOGO	SQ.FT.	--
POST MOUNTED SIGNS, TYPE C, LOGO	SQ.FT.	--
BREAKAWAY SYSTEMS	EACH	--
* STEEL S OR W BEAM POSTS	LBS.	--
LOGO SIGN MOUNTING	EACH	--
REMOVAL OF POST MOUNTED MOTORIST SERVICE SIGNS, TYPES B, C & F	L.S.	--

* APPROXIMATE QUANTITY FOR INFORMATION ONLY

SYMBOLS

- *Existing Sign to Remain*
- *Existing Sign to be Removed*
- *Existing Sign Reset as Shown*
- NEW SIGN
- FUTURE SIGN
- *Existing Utility Pole*

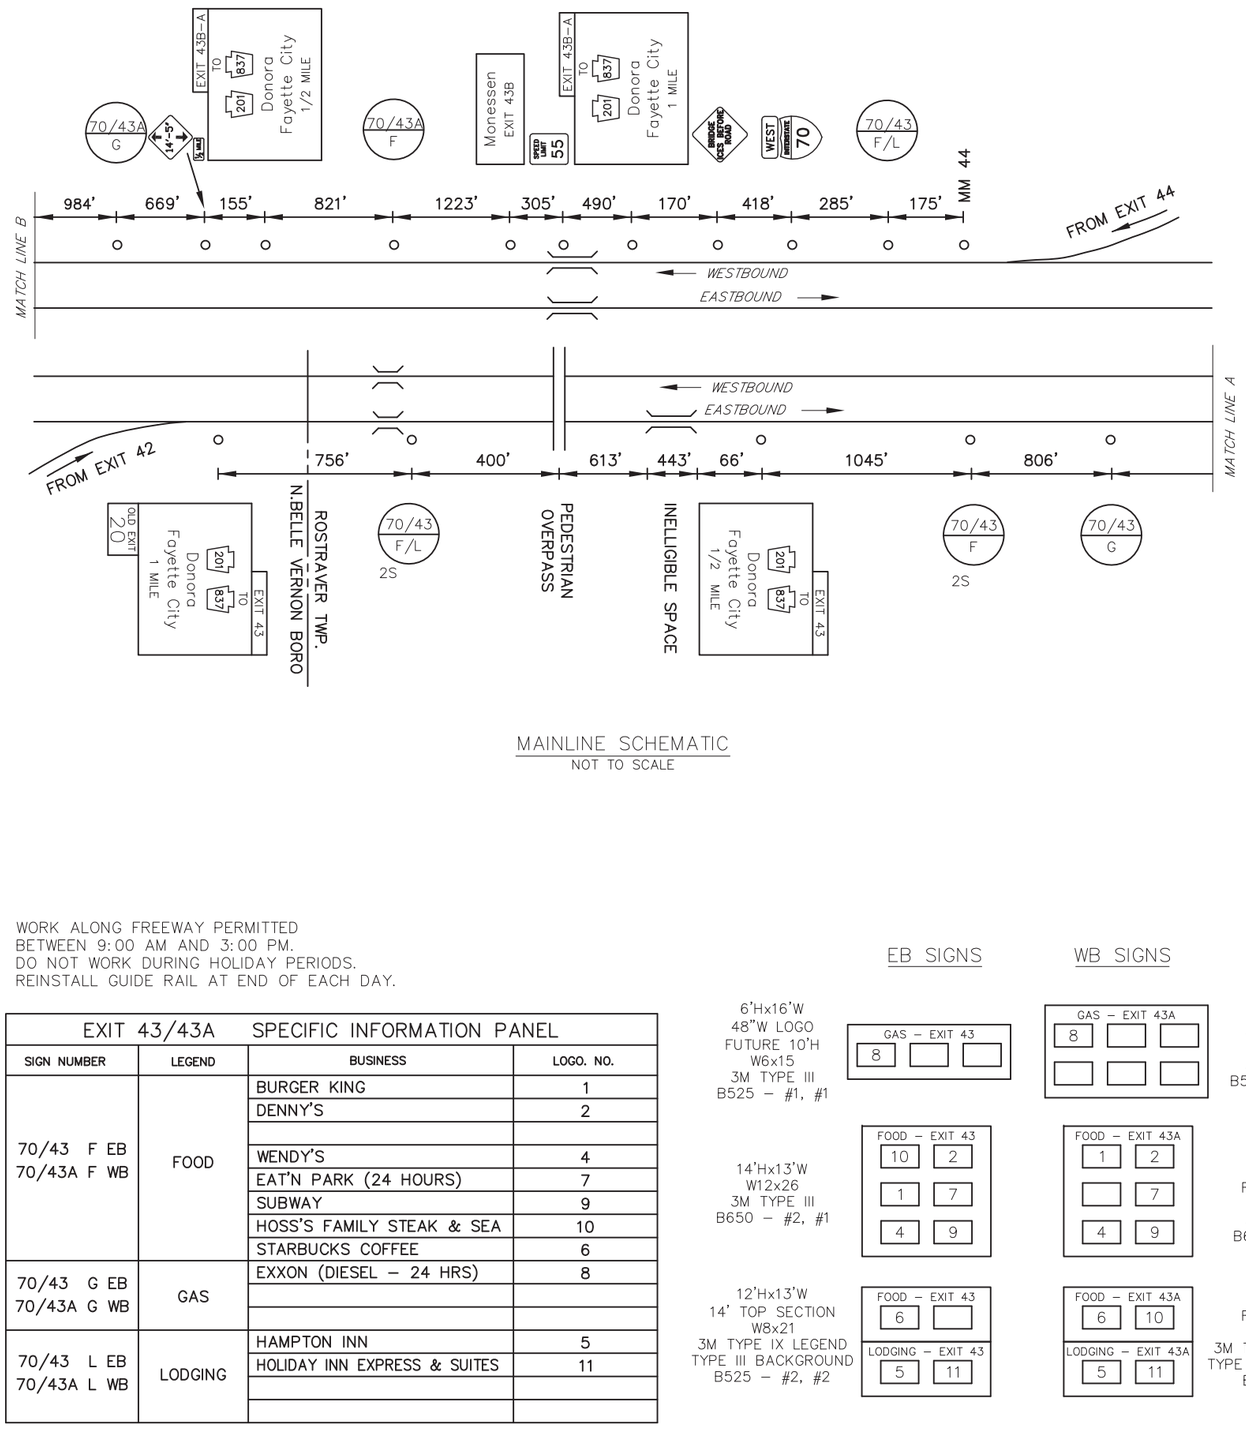

MAINLINE SCHEMATIC
NOT TO SCALE

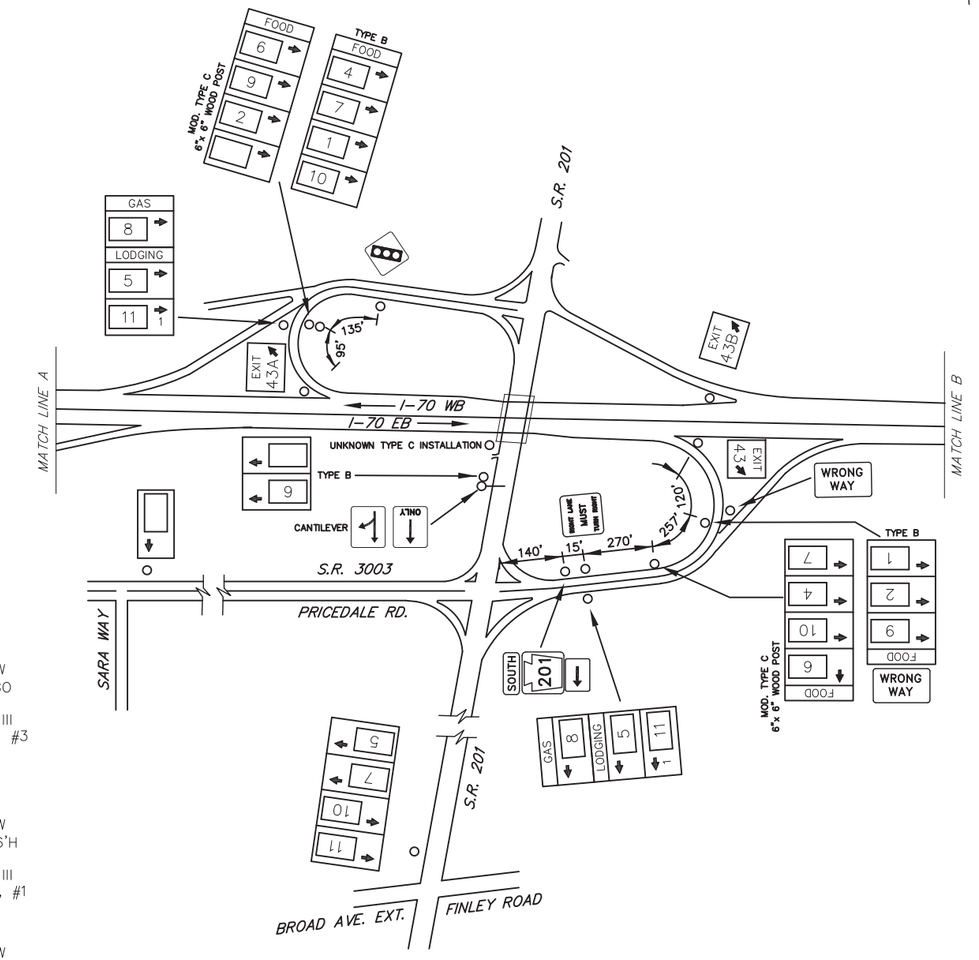

SCHEMATIC PLAN
NOT TO SCALE

WORK ALONG FREEWAY PERMITTED
BETWEEN 9:00 AM AND 3:00 PM.
DO NOT WORK DURING HOLIDAY PERIODS.
REINSTALL GUIDE RAIL AT END OF EACH DAY.

EXIT 43/43A SPECIFIC INFORMATION PANEL			
SIGN NUMBER	LEGEND	BUSINESS	LOGO. NO.
70/43 F EB 70/43A F WB	FOOD	BURGER KING	1
		DENNY'S	2
		WENDY'S	4
		EAT'N PARK (24 HOURS)	7
		SUBWAY	9
		HOSS'S FAMILY STEAK & SEA	10
		STARBUCKS COFFEE	6
70/43 G EB 70/43A G WB	GAS	EXXON (DIESEL - 24 HRS)	8
70/43 L EB 70/43A L WB	LODGING	HAMPTON INN	5
		HOLIDAY INN EXPRESS & SUITES	11

EB SIGNS

6'Hx16'W
48"W LOGO
FUTURE 10'H
W6x15
3M TYPE III
B525 - #1, #1

14'Hx13'W
W12x26
3M TYPE III
B650 - #2, #1

12'Hx13'W
14' TOP SECTION
W8x21
3M TYPE IX LEGEND
TYPE III BACKGROUND
B525 - #2, #2

WB SIGNS

10'Hx16'W
48"W LOGO
W8x18
3M TYPE III
B525 - #3, #3

14'Hx13'W
FUTURE 16'H
W10x26
3M TYPE III
B650 - #1, #1

12'Hx13'W
FUTURE 15'H
W14x30
3M TYPE IX LEGEND
TYPE III BACKGROUND
B650 #2, #1

INTERSTATE 70

FAYETTE CITY

EXIT 43/43A

D:\2015_JOBS\215076-01\MVP\SE\AS-BUILT DRAWINGS\PENNDOT DISTRICT 12\WESTMORELAND - 64\10-XX SHTXX-179_EXIT 43 PLAN
April/5/2019 4:59 PM