DISTRICT	COUNTY	ROUTE	PROJECT	SHEET
10-0	BUTLER	I-79	XXX-XX	X OF X
11-0	ALLEGHENY	I-79		
CRANBERRY TWP. BUTLER CO.; MARSHALL TWP. ALLEGHENY CO.				
REVISIONS				

TABULATION OF QUANTITIES		
ITEM	UNIT	QUANTITY
POST MOUNTED SIGNS, TYPE A, LOGO	SQ.FT.	--
POST MOUNTED SIGNS, TYPE B, LOGO	SQ.FT.	--
POST MOUNTED SIGNS, TYPE C, LOGO	SQ.FT.	--
BREAKAWAY SYSTEMS	EACH	--
* STEEL S OR W BEAM POSTS	LBS.	--
LOGO SIGN MOUNTING	EACH	--

* APPROXIMATE QUANTITY FOR INFORMATION ONLY

SYMBOLS

- Existing Sign to Remain
- Existing Sign to be Removed
- Existing Sign Reset as Shown
- NEW SIGN
- FUTURE SIGN
- Existing Utility Pole

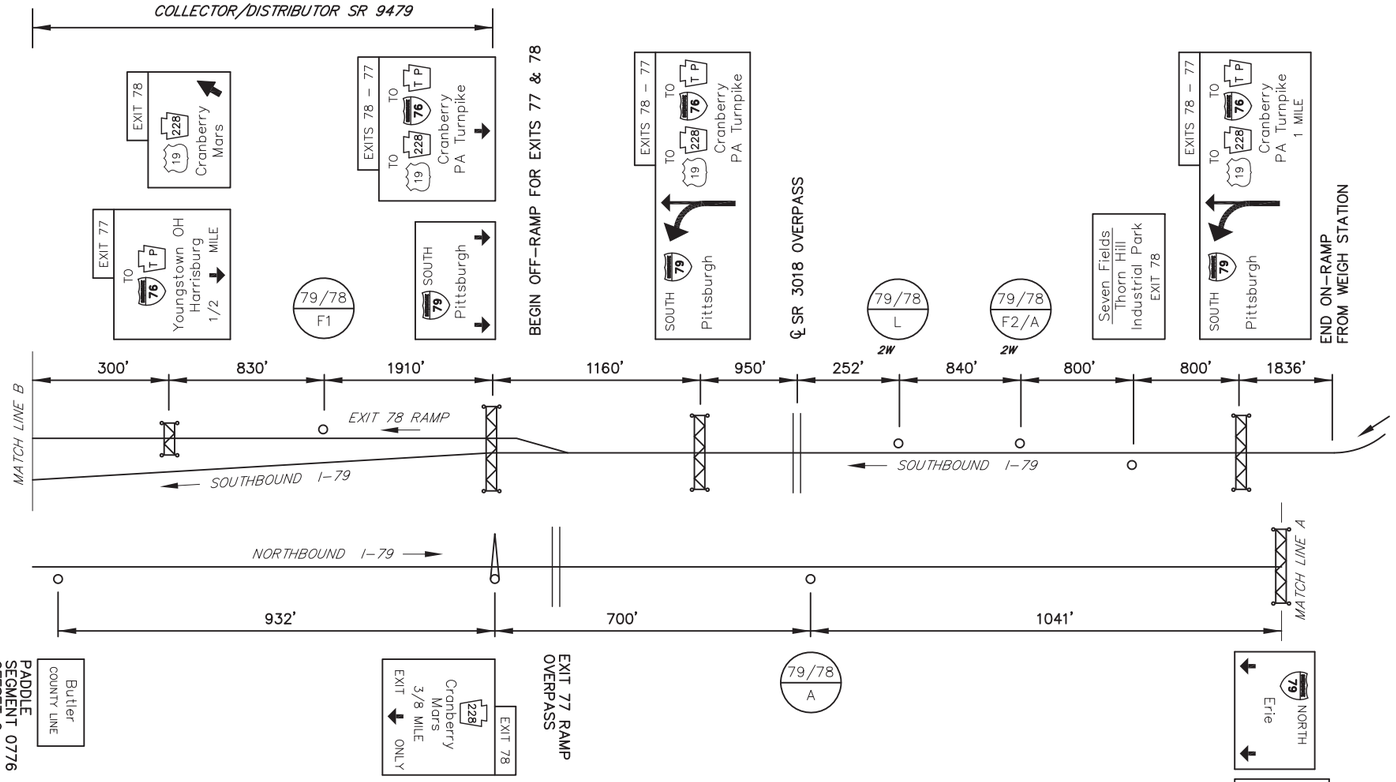

MAINLINE SCHEMATIC
NOT TO SCALE

NO LANE CLOSURES BETWEEN
6:00 AM & 9:00 AM AND
3:00 PM & 6:00 PM
NO LANE RESTRICTIONS PERMITTED
DURING HOLIDAY PERIODS.

EXIT 78 SPECIFIC INFORMATION PANEL			
SIGN NUMBER	LEGEND	BUSINESS	LOGO. NO.
79/78 G SB	GAS	MARATHON (24 HRS)	1
		SUNOCO (DIESEL/24 HRS)	2
		SHEETZ	24
79/78 F1 SB	FOOD	BURGER KING (20204 Route 19)	4
		PANERA BREAD	8
		OLIVE GARDEN	26
		DENNY'S	12
		GETGO (24 HRS)	6
		MCDONALD'S (1703 Route 228)	5
79/78 L SB	LODGING	RED ROOF INN	14
		HAMPTON INN	15
		BEST WESTERN PLUS	27
		QUALITY INN	18
		MARRIOTT	20
		RESIDENCE INN - MARRIOTT	21
79/78 A SB 79/78 A NB	ATTRACTION	UPMC LEMIEUX SPORTS COMPLEX	22
79/78 F2 SB	FOOD	JASON'S DELI	3
		CHICK-FIL-A (CLOSED SUNDAY)	9
		STARBUCKS	25

SB SIGNS

GAS - EXIT 78: 1, X, 2 / 24 — 10'Hx16'W, 48"W LOGO, W10x22, 3M TYPE III, B650 - #1, #1

FOOD - EXIT 78: 4, 8, 5 / 26, 6, 12 — F1, 10'Hx19'W, W8x21, 3M TYPE III, B525 - #2, #2

LODGING - EXIT 78: 21, 14, 18 / 15, 20, 27 — L, 10'Hx19'W, W10x22, B650 - #2, #1

FOOD - EXIT 78: 3, 9, 25 / ATTRACTION - EXIT 78: 22 — F2/A, 12'Hx19'W, W10x26, 3M TYPE III, B650 - #2, #1

NB SIGNS

ATTRACTION - EXIT 78: 22 — 6'Hx13'W, FUTURE 16'H, W18x35, 3M TYPE VI, B650 - #2, #2

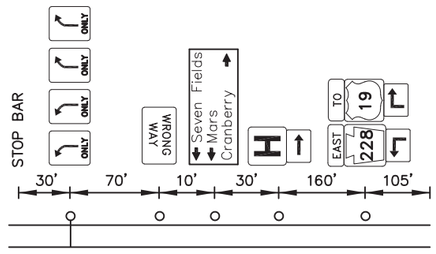

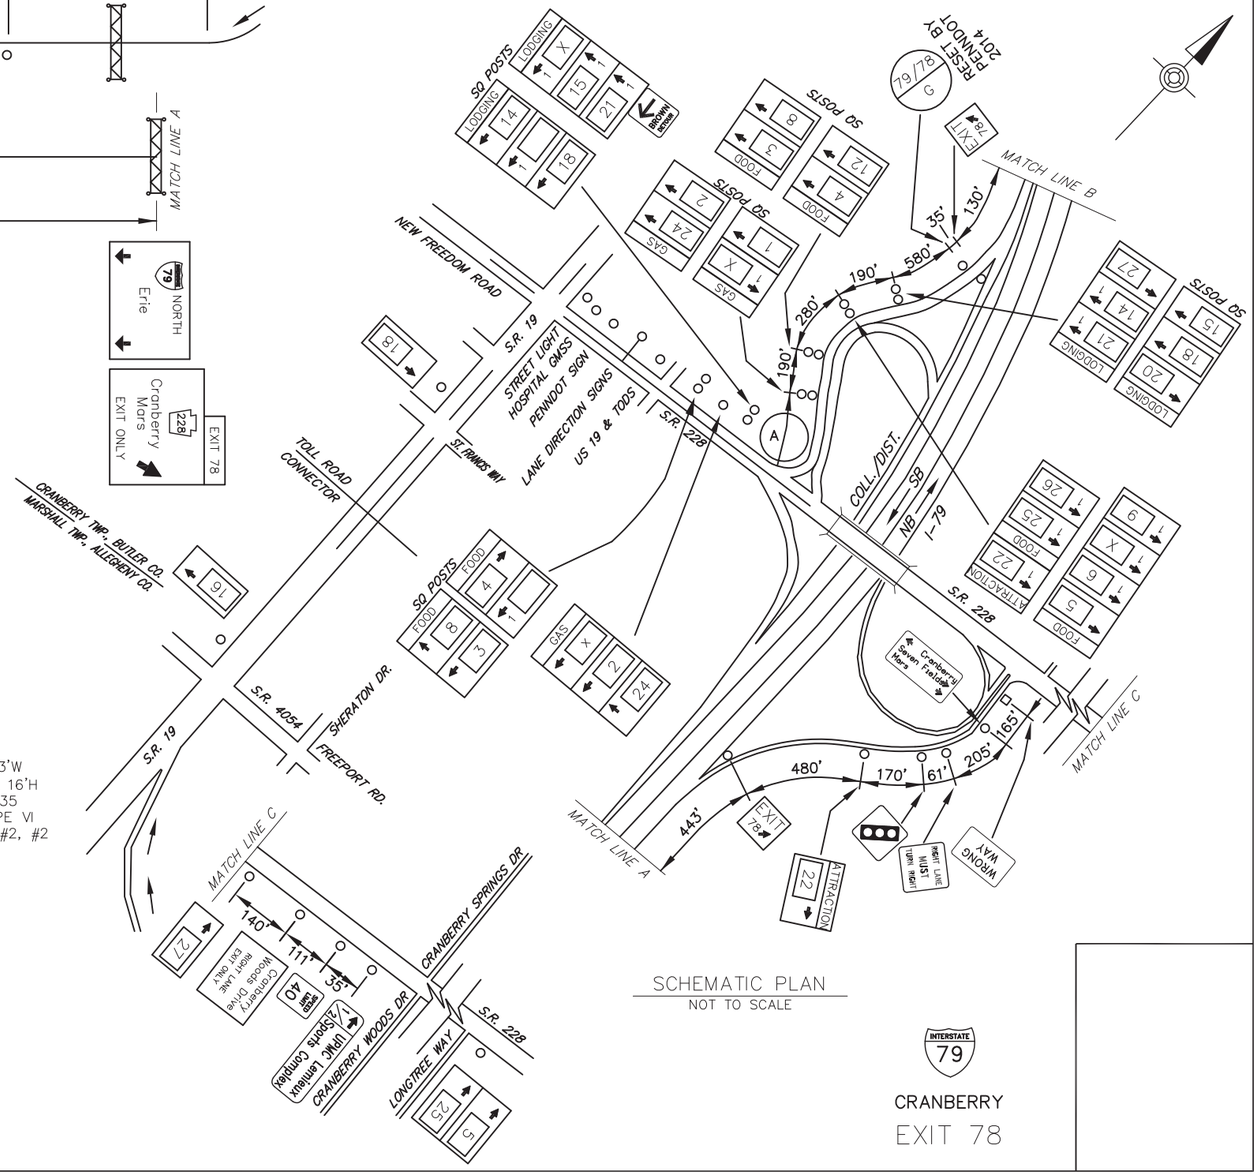

SCHEMATIC PLAN
NOT TO SCALE

INTERSTATE 79

CRANBERRY
EXIT 78

D:\2015_ID\BRS-215276-(1)\PW\PSE\AS-BUILT DRAWINGS\PENNDOT DISTRICT 10\BUTLER - 10\10-XX SHTXX-179_EXIT 78.PLAN
April/5/2019 5:49 PM