DISTRICT	COUNTY	ROUTE	PROJECT	SHEET
11–0	BEAVER	I–376		
CHIPPEWA TOWNSHIP				
REVISIONS				

TABULATION OF QUANTITIES		
ITEM	UNIT	QUANTITY
POST MOUNTED SIGNS, TYPE A, LOGO	SQ.FT.	
POST MOUNTED SIGNS, TYPE B, LOGO	SQ.FT.	
POST MOUNTED SIGNS, TYPE C, LOGO	SQ.FT.	–
BREAKAWAY SYSTEMS	EACH	
* STEEL S OR W BEAM POSTS	LBS.	
LOGO SIGN MOUNTING	EACH	
REMOVAL OF POST MOUNTED MOTORIST SERVICE SIGNS, TYPES A, B, C, E & F	L.S.	

* APPROXIMATE QUANTITY FOR INFORMATION ONLY

SYMBOLS

- ○ *Existing Sign to Remain*
- △ *Existing Sign to be Removed*
- □ *Existing Sign Reset as Shown*
- ● NEW SIGN
- × FUTURE SIGN
- Ø *Existing Utility Pole*

EASTBOUND LANES ARE UNDER JURISDICTION OF PA TURNPIKE COMMISSION

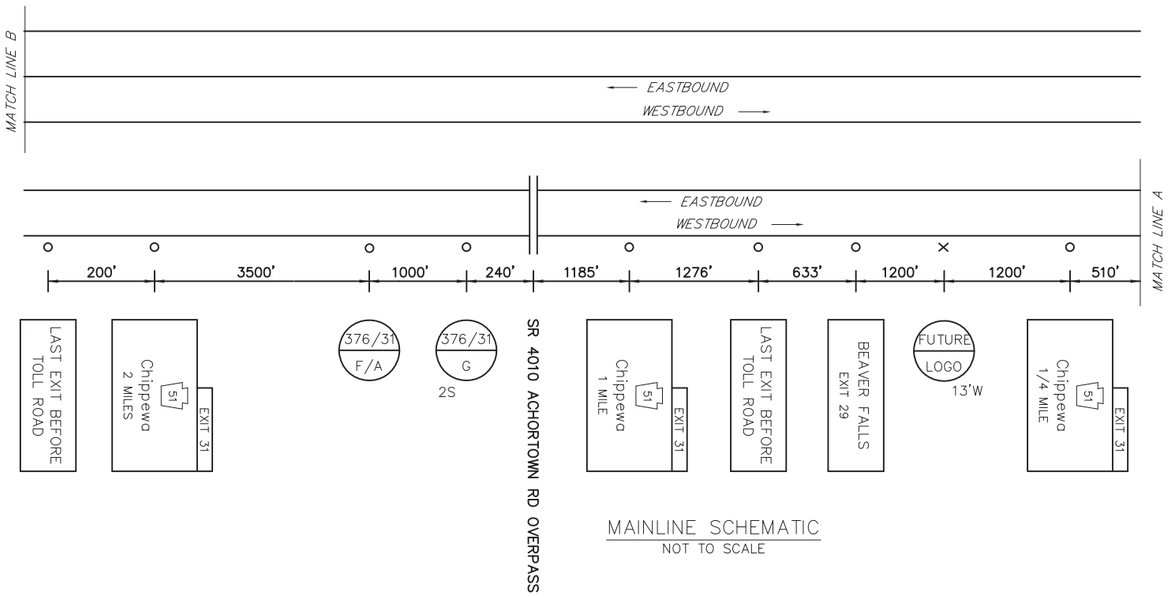

MAINLINE SCHEMATIC
NOT TO SCALE

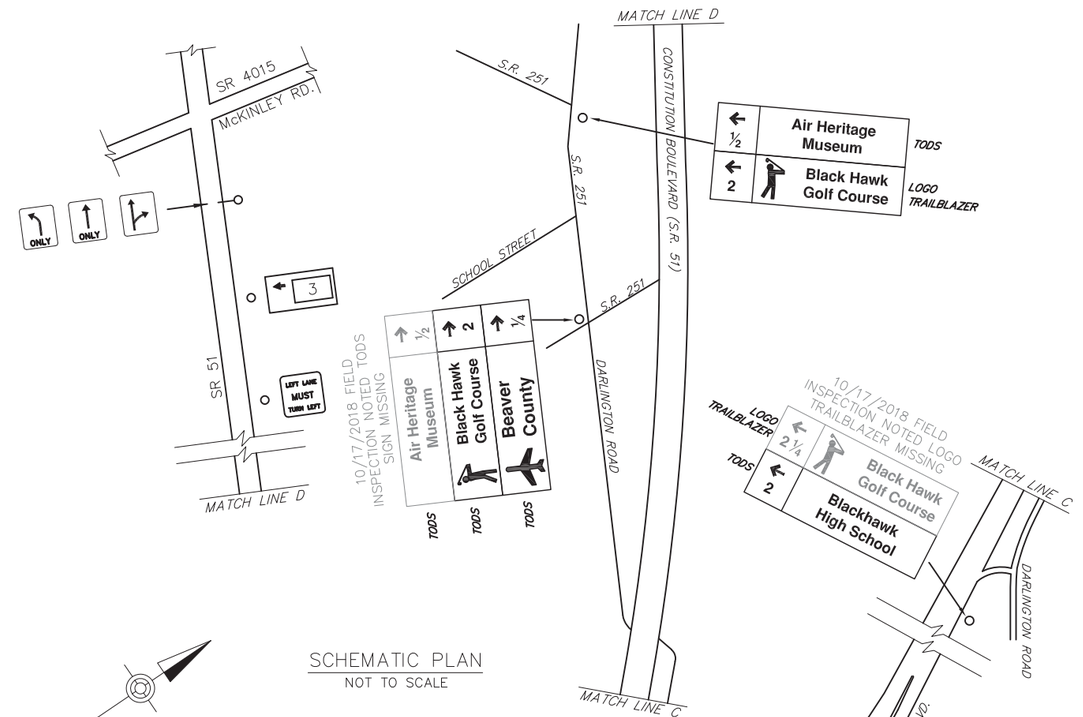

SCHEMATIC PLAN
NOT TO SCALE

DISTRICT 11–0
PROVIDE 3 DAYS NOTICE PRIOR TO START OF WORK TO DISTRICT 11–0 DAN QUARCOO 412–429–4971.
SEE SPECIAL PROVISION 4901–0001.

EXIT 31 SPECIFIC INFORMATION PANEL			
SIGN NUMBER	LEGEND	BUSINESS	LOGO. NO.
376/31 A WB	ATTRACTION	BLACK HAWK GOLF	1
376/31 F WB	FOOD	EAT'N PARK (24 HOURS)	2
		SAL'S RISTORANTE & BAR	3
		APPLEBEE'S	5
		MCDONALDS (24 HOURS)	6
376/31 G WB	GAS	GETGO (24 hrs – Diesel)	4

WB SIGNS

6'Hx13'W
FUTURE 16'H
W14x30 A572
TYPE IX LEGEND
TYPE III BACKGROUND
B650 – #1, #2

GAS – EXIT 31
4

16'Hx13'W
W14x30 A572
3M TYPE III
B650 – #1, #1

FOOD – EXIT 31
5 6
2 3
ATTRACTION–EXIT 31
1

INTERSTATE 376
CHIPPEWA
EXIT 31

\\DAVPROJ01\PROJECTS\2015\E85\2150776-01\WP\PSE-AS-BUILT DRAWINGS\PENNDOT DISTRICT 11\BEAVER – BA\10-XX SHTXX-I376_EXIT 31 PLAN
May/14/2019 202 PM