DISTRICT	COUNTY	ROUTE	PROJECT	SHEET
8-0	ADAMS	US 15		

MOUNT JOY & STRABAN TOWNSHIP

REVISIONS

TABULATION OF QUANTITIES		
ITEM	UNIT	QUANTITY
POST MOUNTED SIGNS, TYPE A, LOGO	SQ.FT.	
POST MOUNTED SIGNS, TYPE B, LOGO	SQ.FT.	
POST MOUNTED SIGNS, TYPE C, LOGO	SQ.FT.	
BREAKAWAY SYSTEMS	EACH	
* STEEL S OR W BEAM POSTS	LBS.	
LOGO SIGN MOUNTING	EACH	
REMOVAL OF POST MOUNTED MOTORIST SERVICE SIGNS, TYPES B, C & F	L.S.	

* APPROXIMATE QUANTITY FOR INFORMATION ONLY

SYMBOLS

- ○ *Existing Sign to Remain*
- △ *Existing Sign to be Removed*
- □ *Existing Sign Reset as Shown*
- ● NEW SIGN
- × FUTURE SIGN
- Ø *Existing Utility Pole*

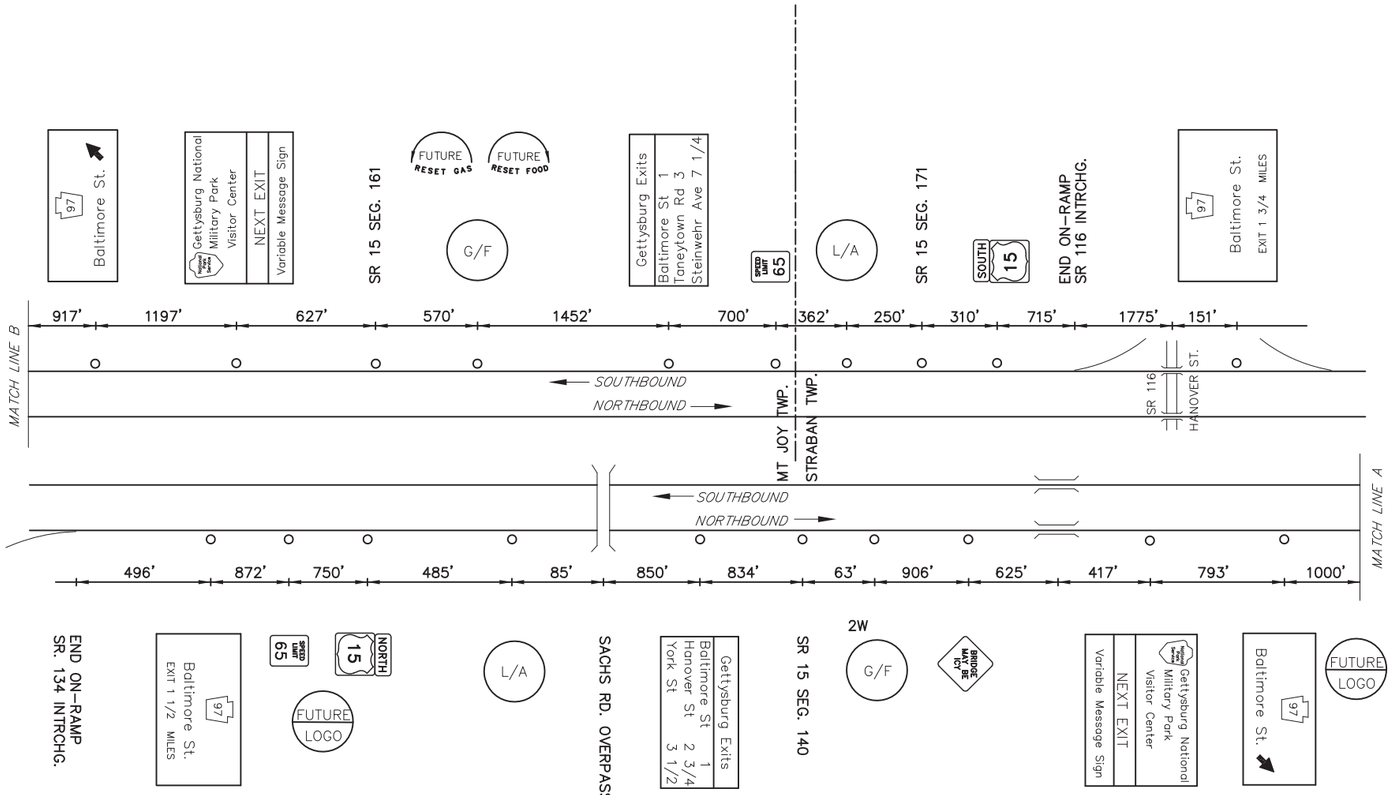

MAINLINE SCHEMATIC
NOT TO SCALE

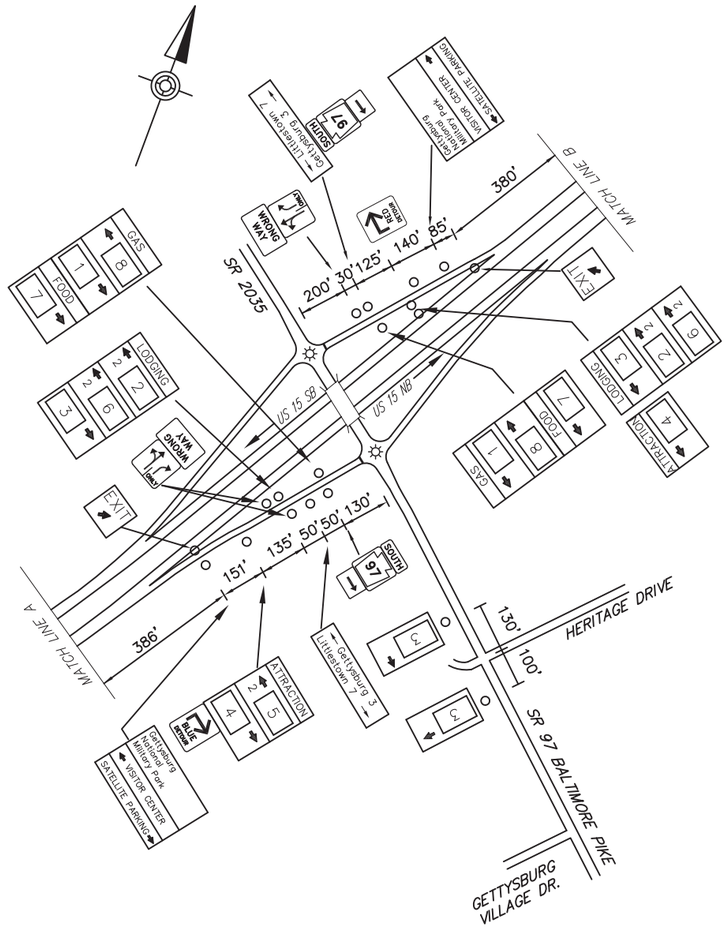

SCHEMATIC PLAN
NOT TO SCALE

LEGEND

2W – GUIDE RAIL

FREEWAY LANE CLOSURES & RESTRICTIONS
ONLY PERMITTED BETWEEN 9:00 PM AND
6:00 AM MONDAY THRU FRIDAY.
DO NOT WORK DURING HOLIDAY PERIODS.

BALTIMORE ST. EXIT SPECIFIC INFORMATION PANEL			
LEGEND	DIRECTION	BUSINESS	LOGO. NO.
GAS	NB/SB	SHEETZ (DIESEL)	1
		SUNOCO (DIESEL)	8
FOOD	NB/SB	SHEETZ	7
LODGING	NB/SB	COMFORT SUITES	2
		COUNTRY INN & SUITES	3
		1863 INN OF GETTYSBURG	6
ATTRACTION	NB/SB	THE OUTLET SHOPPES AT GETTYSBURG	4
	NB	GETTYSBURG TOUR CENTER	5

NB SIGNS

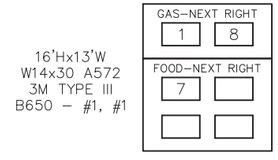

SB SIGNS

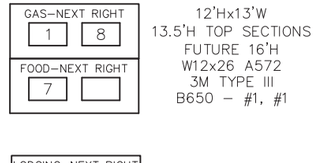

15
SR 97 / SR 2035
BALTIMORE ST.

D:\2015\08315215076-01\MVPSE\AS-BUILT DRAWINGS\PENNDOT DISTRICT 08\ADAMS - 01\08-XX_SHTXX US15 BALTIMORE ST PLAN
June/11/2019 3:48 PM