DISTRICT	COUNTY	ROUTE	PROJECT	SHEET
8-0	CUMBERLAND	U.S. 15		

UPPER ALLEN TOWNSHIP

REVISIONS

TABULATION OF QUANTITIES		
ITEM	UNIT	QUANTITY
POST MOUNTED SIGNS, TYPE A, LOGO	SQ.FT.	
POST MOUNTED SIGNS, TYPE B, LOGO	SQ.FT.	
POST MOUNTED SIGNS, TYPE C, LOGO	SQ.FT.	
BREAKAWAY SYSTEMS	EACH	
* STEEL S OR W BEAM POSTS	LBS.	
LOGO SIGN MOUNTING	EACH	
REMOVAL OF POST MOUNTED MOTORIST SERVICE SIGNS, TYPES B, C & F	L.S.	–

* APPROXIMATE QUANTITY FOR INFORMATION ONLY

SYMBOLS

- ○ *Existing Sign to Remain*
- △ *Existing Sign to be Removed*
- □ *Existing Sign Reset as Shown*
- ● NEW SIGN
- × FUTURE SIGN
- Ø *Existing Utility Pole*

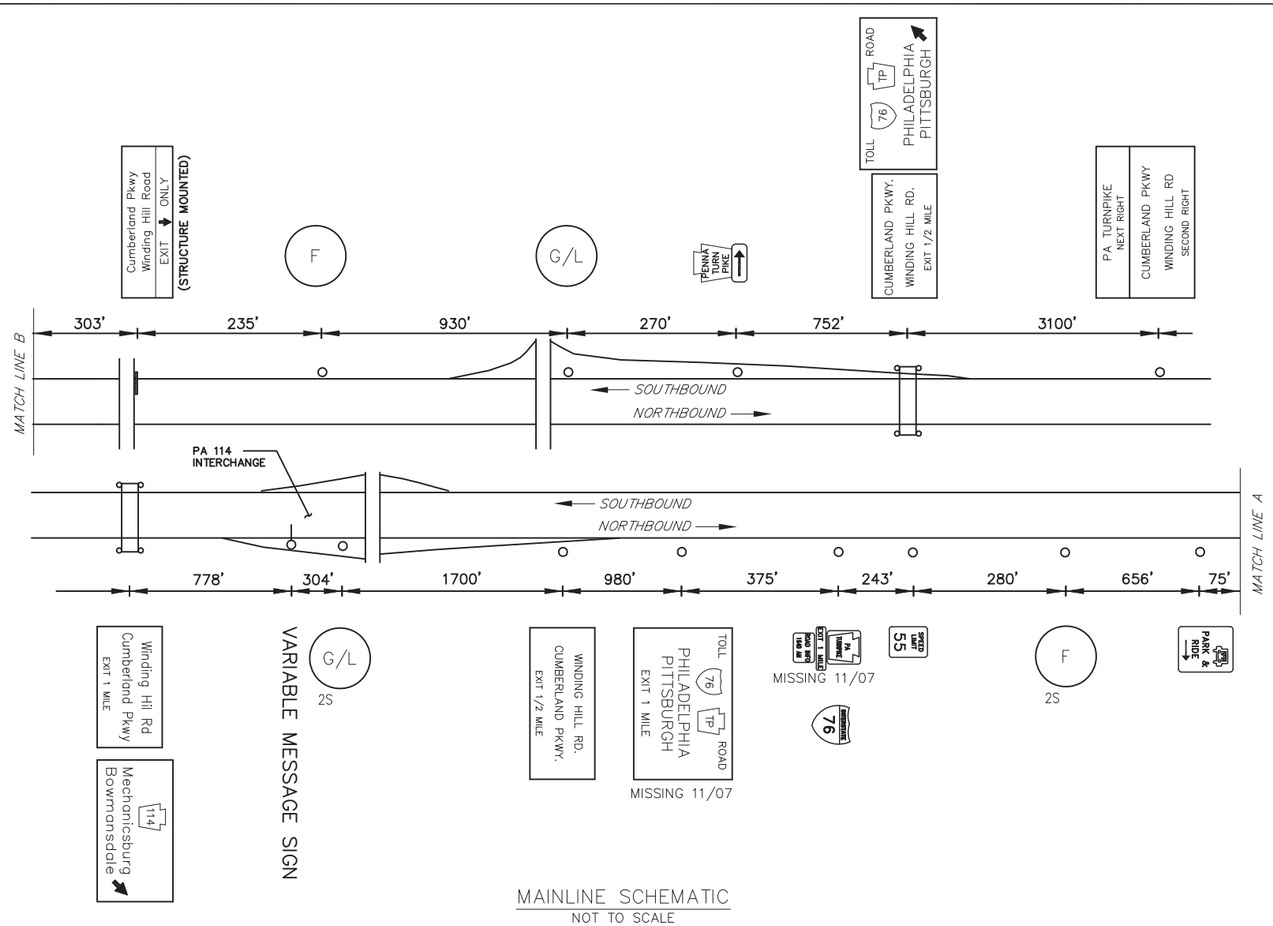

MAINLINE SCHEMATIC
NOT TO SCALE

LEGEND

2S – GUIDE RAIL

FREEWAY LANE CLOSURES & RESTRICTIONS
ONLY PERMITTED BETWEEN 9:00 PM AND
6:00 AM MONDAY THRU FRIDAY.
DO NOT WORK DURING HOLIDAY PERIODS.

CUMBERLAND PARKWAY SPECIFIC INFORMATION PANEL			
LEGEND	DIRECTION	BUSINESS	LOGO. NO.
LODGING	NB/SB	WINGATE BY WYNDHAM	3
GAS	SB	SHEETZ (DIESEL)	2
	NB/SB		
		GIANT GASOLINE	5
FOOD	NB/SB	WENDY'S	6
		CRACKER BARREL	7
		ARBY'S	8
		GIANT	9

NB SIGNS

10'Hx13'W
FUTURE 14'H
W14x30 A572
B650– #2, #2

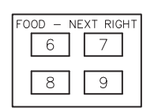

12'Hx19'W
W8x21 A572
STIM. TYPE IV
B525 – #2, #2

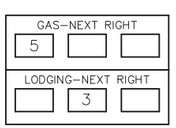

SB SIGNS

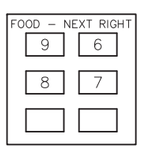

14'Hx13'W
FUTURE 16'H
W12x26 A572
STIM. TYPE IV
B650 – #2, #2

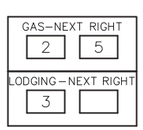

12'Hx13'W
FUTURE 16'H
W12x26 A572
STIM. TYPE IV
B650– #2, #1

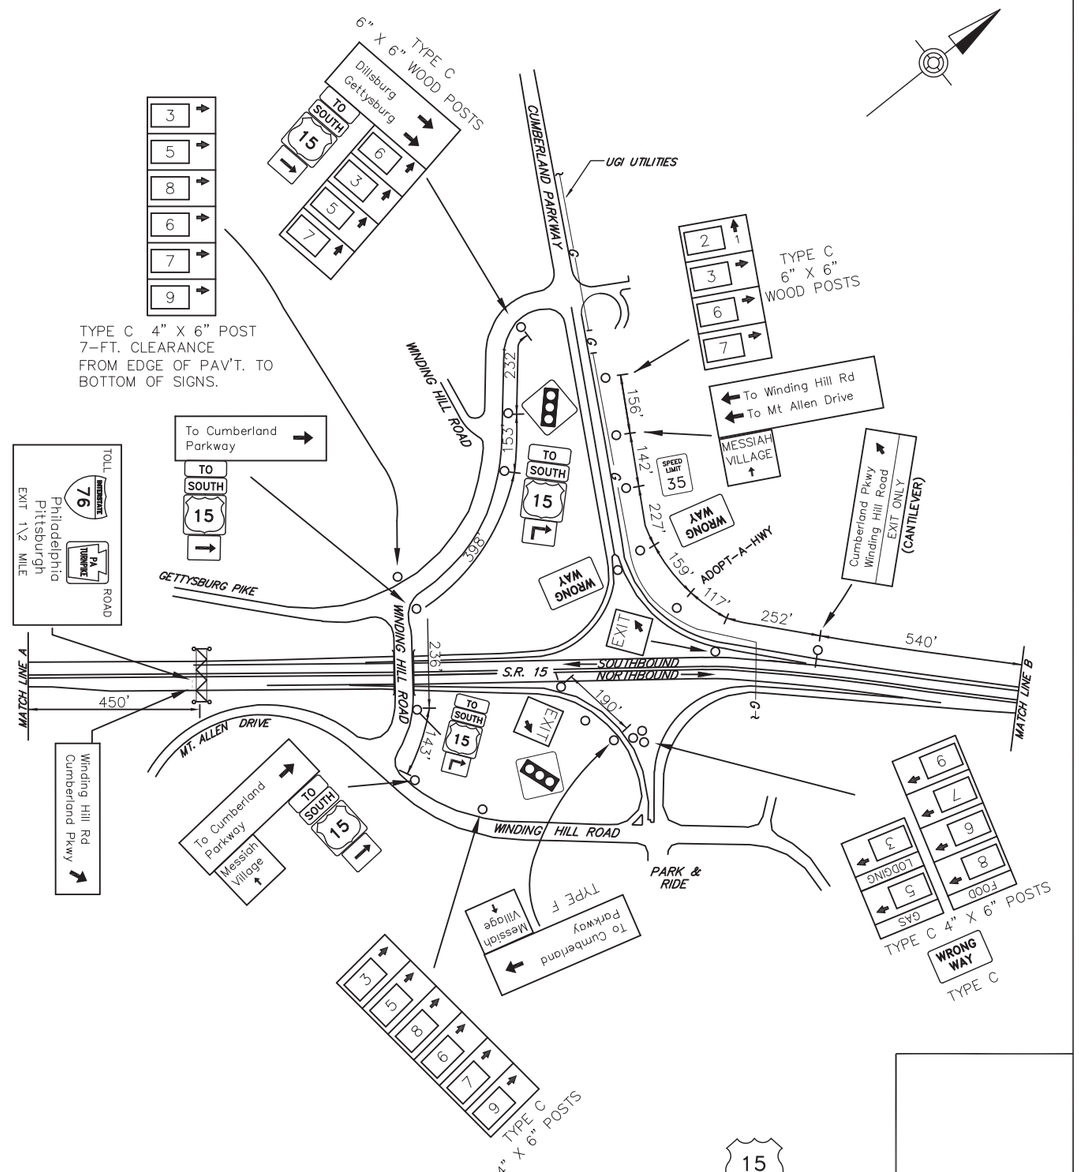

SCHEMATIC PLAN
NOT TO SCALE

15

SR 2010
CUMBERLAND PARKWAY
WINDING HILL ROAD

D:\2015_JOBS\215076-01\WW\PSE\AS-BUILT DRAWINGS\PENNDOT DISTRICT 08\CUMBERLAND - 215-XX_SHTXX US15_CUMBERLANDPARKWAY EX PLAN
June/11/2019 12:24 PM