DISTRICT	COUNTY	ROUTE	PROJECT	SHEET
9-0	BLAIR	I-99		

FREEDOM TOWNSHIP

REVISIONS

TABULATION OF QUANTITIES		
ITEM	UNIT	QUANTITY
POST MOUNTED SIGNS, TYPE A, LOGO	SQ.FT.	–
POST MOUNTED SIGNS, TYPE A, LOGO (MODIFIED)	SQ.FT.	–
POST MOUNTED SIGNS, TYPE C, LOGO	SQ.FT.	
BREAKAWAY SYSTEMS	EACH	–
* STEEL S OR W BEAM POSTS	LBS.	–
LOGO SIGN MOUNTING	EACH	–
LOGO SIGN MOUNTING, RESET	EACH	–
REMOVE POST MOUNTED SIGNS, TYPE A LOGO (MODIFIED)	EACH	–
REMOVE POST MOUNTED SIGNS, TYPE E SERVICE SIGNS, TYPES B, C & F	L.S.	

* APPROXIMATE QUANTITY FOR INFORMATION ONLY

SYMBOLS

- *Existing Sign to Remain*
- *Existing Sign to be Removed*
- *Existing Sign Reset as Shown*
- NEW SIGN
- FUTURE SIGN
- *Existing Utility Pole*

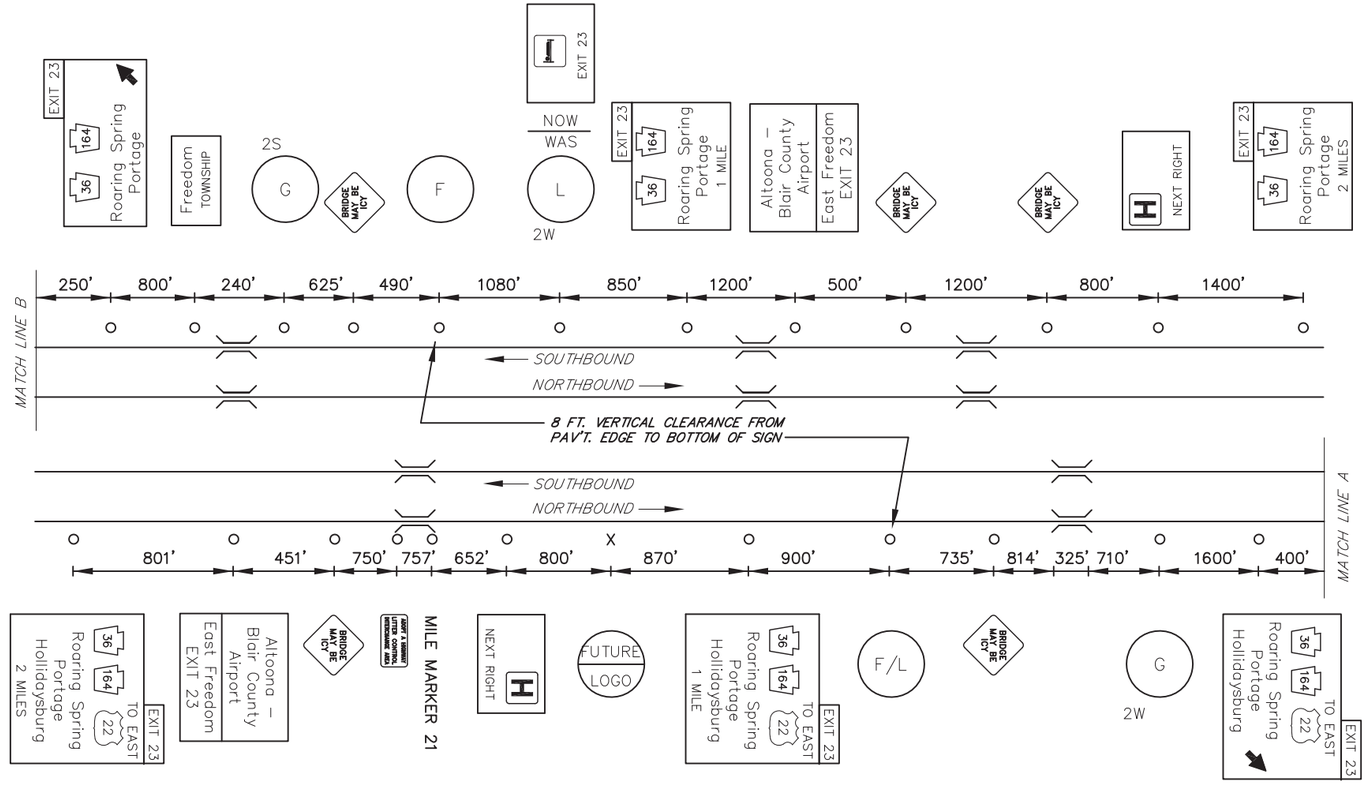

MAINLINE SCHEMATIC
NOT TO SCALE

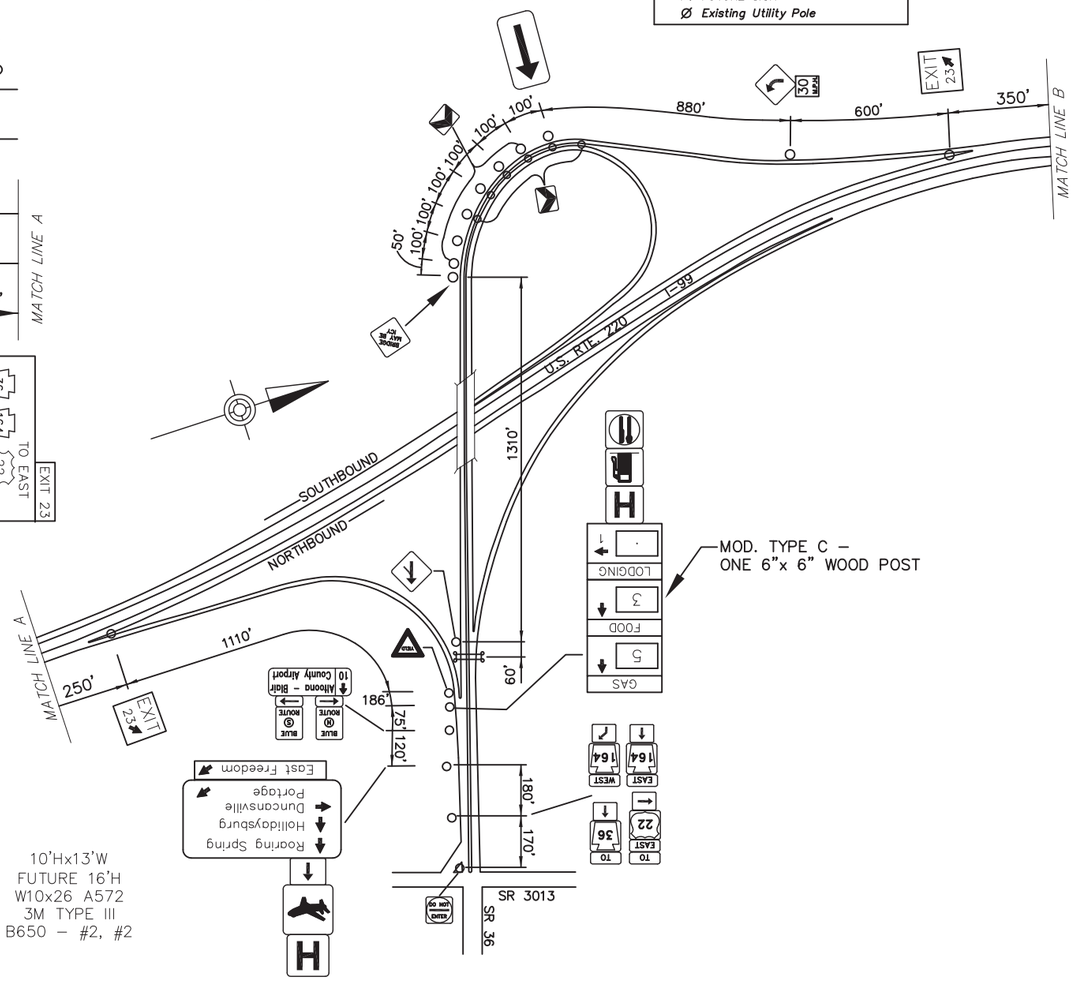

SCHEMATIC PLAN
NOT TO SCALE

LEGEND

2S/2W – GUIDE RAIL

EXIT 23 SPECIFIC INFORMATION PANEL			
LEGEND	DIRECTION	BUSINESS	LOGO. NO.
GAS	NB/SB	GETGO (#3701) (DIESEL)	4
		SHEETZ (#169) (DIESEL)	5
		TURKEY HILL	6
FOOD	NB/SB	TACO BELL	2
		SHEETZ	3
LODGING	NB/SB		

NB SIGNS

10'Hx13'W
W8x21 A572
3M TYPE III
B525 – #1, #1

GAS – EXIT 23: 6, 5, 4

12'Hx13'W
FUTURE 16'H
W12x26 A572
3M TYPE III
B650 – #1, #1

FOOD – EXIT 23: 2, 3
LODGING – EXIT 23

SB SIGNS

GAS – EXIT 23: 6, 5, 4

FOOD – EXIT 23: 2, 3

NOW
WAS

EXIT 23
LODGING – EXIT 23

10'Hx13'W
FUTURE 16'H
W10x26 A572
3M TYPE III
B650 – #2, #2

6'Hx13'W
FUTURE 14'H
W12x26 A572
3M TYPE III
B650 – #1, #1

05/15/2019 FIELD INSPECTION NOTED MAINLINE SIGN KNOCKED OVER

INSTALLED NEW PANEL ON EXISTING LOGO POSTS

6'Hx13'W
FUTURE 10'H
W8x21 A572
3M TYPE III
B525 – #1, #1

INTERSTATE 99

ROARING SPRING
EAST S.R. 22, S.R. 36, S.R. 164
HOLLIDAYSBURG, PORTAGE

EXIT 23

D:\2015_JOBS\215076-01\WA\PSE\AS-BUILT DRAWINGS\PENNDOT DISTRICT 09\BLAIR - 07\10-XX SHTXX-I99_EXIT 23 PLAN
June/11/2019 10:37 AM