DISTRICT	COUNTY	ROUTE	PROJECT	SHEET
9-0	BLAIR	I-99		
ANTIS TOWNSHIP				
REVISIONS				

TABULATION OF QUANTITIES		
ITEM	UNIT	QUANTITY
POST MOUNTED SIGNS, TYPE A, LOGO	SQ.FT.	–
POST MOUNTED SIGNS, TYPE B, LOGO	SQ.FT.	–
POST MOUNTED SIGNS, TYPE C, LOGO	SQ.FT.	–
BREAKAWAY SYSTEMS	EACH	–
* STEEL S OR W BEAM POSTS	LBS.	–
LOGO SIGN MOUNTING	EACH	–

* APPROXIMATE QUANTITY FOR INFORMATION ONLY

SYMBOLS

- ○ *Existing Sign to Remain*
- △ *Existing Sign to be Removed*
- □ *Existing Sign Reset as Shown*
- ● NEW SIGN
- × FUTURE SIGN
- Ø *Existing Utility Pole*

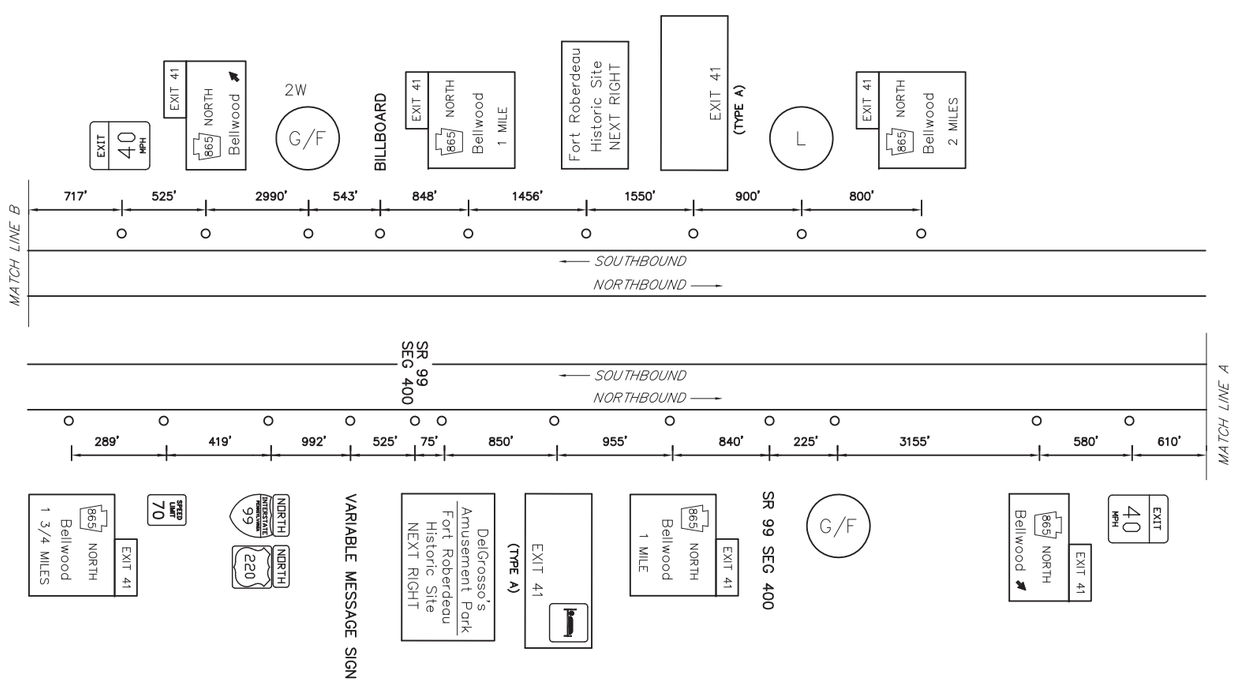

MAINLINE SCHEMATIC
NOT TO SCALE

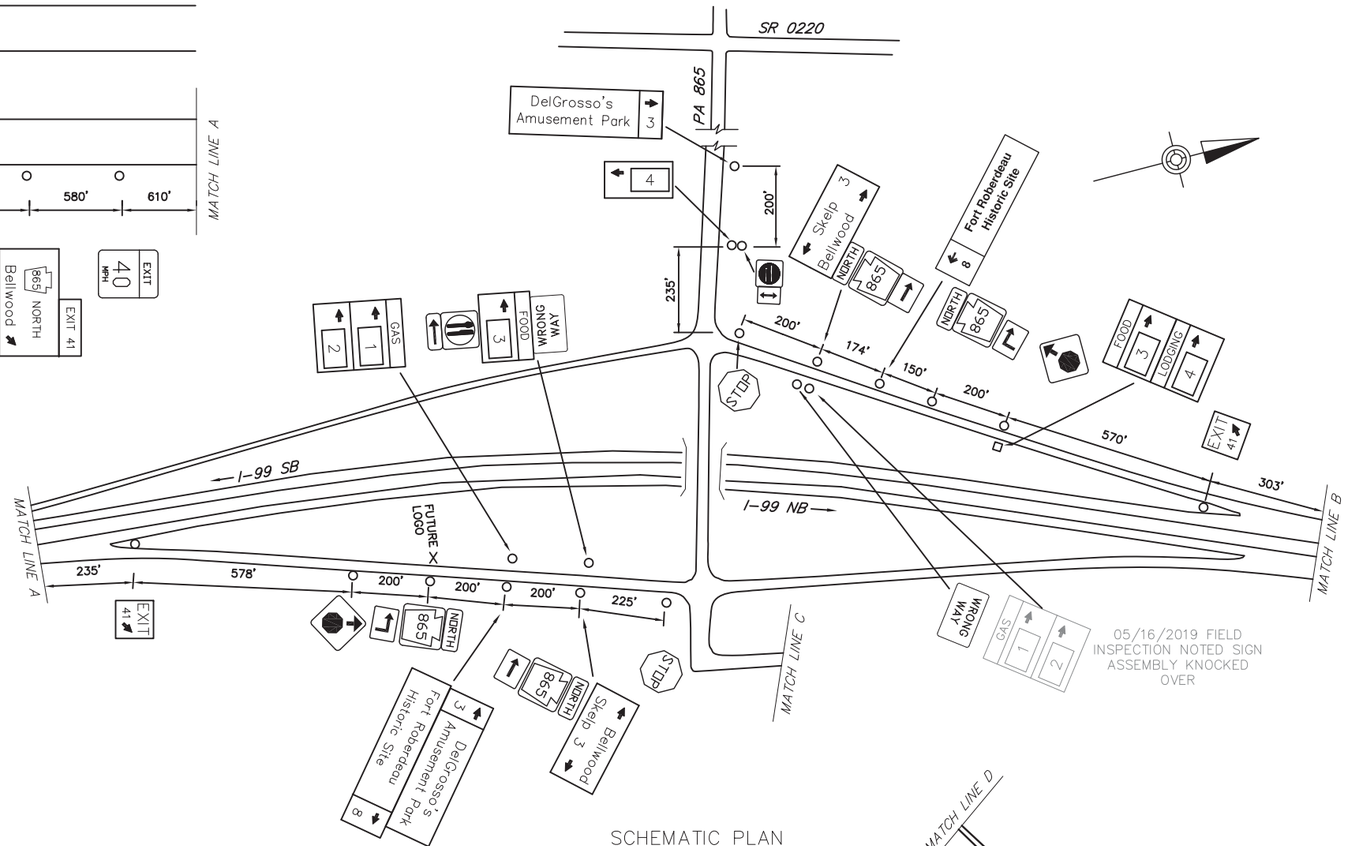

SCHEMATIC PLAN
NOT TO SCALE

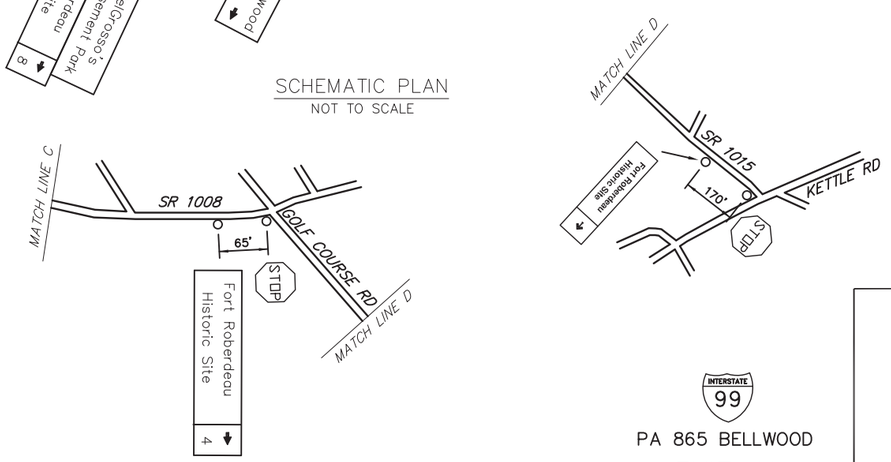

LEGEND

2W – GUIDE RAIL

EXIT 41 SPECIFIC INFORMATION PANEL			
LEGEND	DIRECTION	BUSINESS	LOGO. NO.
FOOD	NB/SB	SHEETZ	3
GAS	NB/SB	MARTIN GENERAL STORES (DIESEL)	1
		SHEETZ (DIESEL) #33	2
LODGING	SB	RELAX INN	4

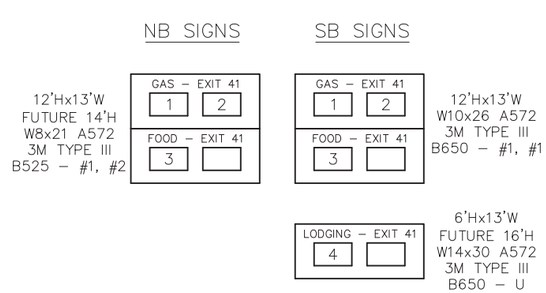

INTERSTATE 99

PA 865 BELLWOOD

EXIT 41

D:\2015JOBS\25076-01\HW\PSE\AS-BUILT DRAWINGS\PENNDOT DISTRICT 09\BLAIR - 07\10-XX SHTXX-199_EXIT 41 PLAN
June/10/2019 12:54 PM