DISTRICT	COUNTY	ROUTE	PROJECT	SHEET
3-0	TIOGA	US 15		
LIBERTY TOWNSHIP				
3-0	LYCOMING			
JACKSON TOWNSHIP				
REVISIONS				

TABULATION OF QUANTITIES		
ITEM	UNIT	QUANTITY
POST MOUNTED SIGNS, TYPE A, LOGO	SQ.FT.	—
POST MOUNTED SIGNS, TYPE B, LOGO	SQ.FT.	—
POST MOUNTED SIGNS, TYPE C, LOGO	SQ.FT.	—
BREAKAWAY SYSTEMS	EACH	—
* STEEL S OR W BEAM POSTS	LBS.	—
LOGO SIGN MOUNTING	EACH	—
FLAT SHEET PANEL REPLACEMENT	SQ.FT.	
EXTRUDED PANEL REPLACEMENT	SQ.FT.	—
REMOVAL OF POST MOUNTED MOTORIST SERVICE SIGNS, TYPES B, C & F	L.S.	

* APPROXIMATE QUANTITY FOR INFORMATION ONLY

SYMBOLS

- ○ *Existing Sign to Remain*
- △ *Existing Sign to be Removed*
- □ *Existing Sign Reset as Shown*
- ● NEW SIGN
- × FUTURE SIGN
- Ø *Existing Utility Pole*

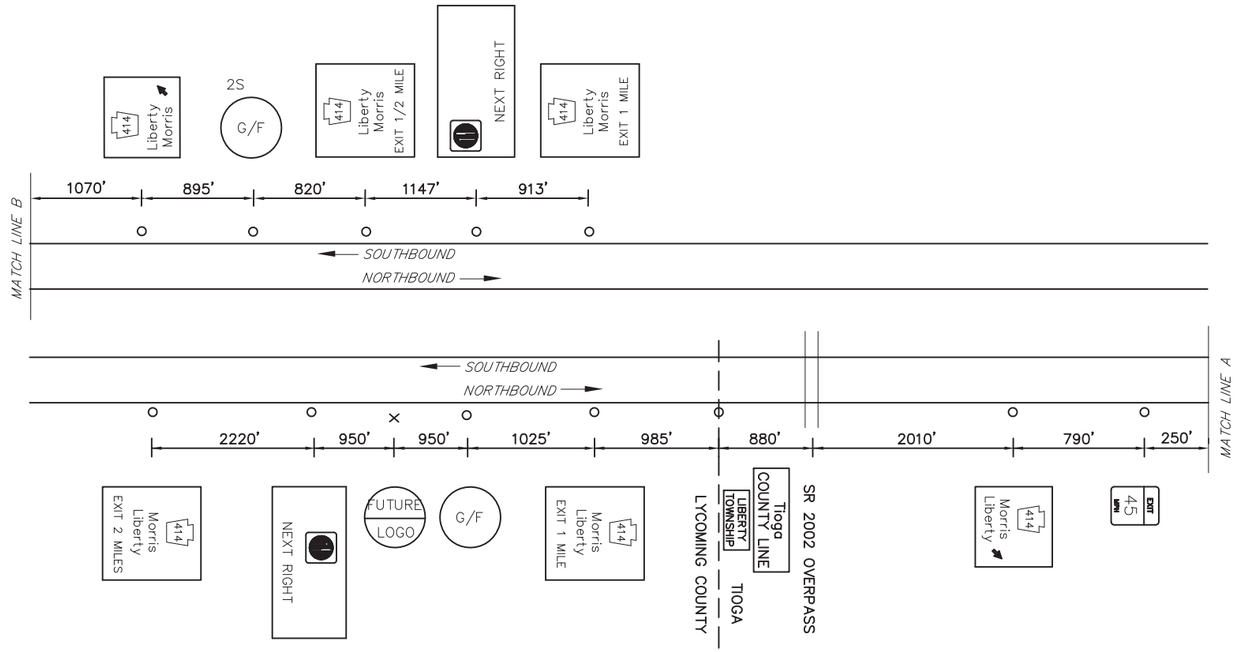

MAINLINE SCHEMATIC
NOT TO SCALE

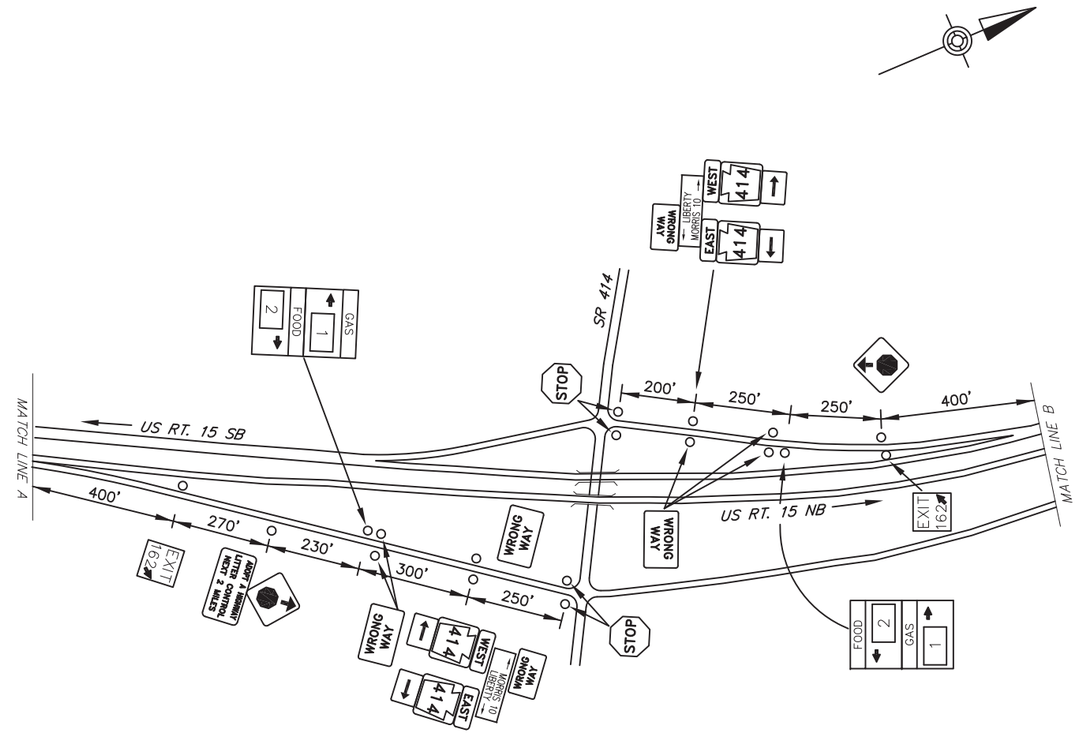

SCHEMATIC PLAN
NOT TO SCALE

LEGEND

2S – GUIDE RAIL

EXIT 162 SPECIFIC INFORMATION PANEL			
LEGEND	DIRECTION	BUSINESS	LOGO. NO.
GAS	NB/SB	EXXON (DIESEL)	1
FOOD	NB/SB	THE LANDING STRIP FAMILY RESTAURANT	2

NB SIGNS

12'Hx13'W
FUTURE 16'H
W14x30 A572
3M TYPE III
B650 – #2, #2

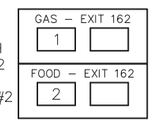

SB SIGNS

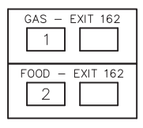

12'Hx13'W
W14x30 A572
3M TYPE III
B650 – #1, #1

15
S.R. 414
LIBERTY
EXIT 162

D:\2015_ADB\315076-01\WK\PSE\AS-BUILT DRAWINGS\PENNDOT DISTRICT 03\TIOGA - SR\10-XX SHT XX-US15_EXIT 162 (LIBERTY) PLAN
July/22/2019 11:34 AM