DISTRICT	COUNTY	ROUTE	PROJECT	SHEET
3-0	UNION	US 15		
WHITE DEER & KELLY TOWNSHIPS				
REVISIONS				

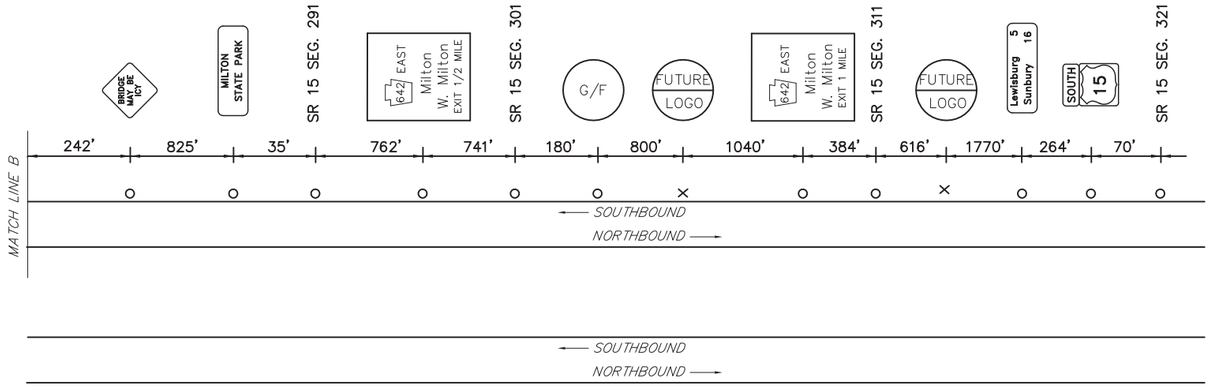

NORTHBOUND DIRECTION HAS INSUFFICIENT SPACE FOR LOGO SIGNING

MAINLINE SCHEMATIC
NOT TO SCALE

TABULATION OF QUANTITIES		
ITEM	UNIT	QUANTITY
POST MOUNTED SIGNS, TYPE A, LOGO	SQ.FT.	
POST MOUNTED SIGNS, TYPE B, LOGO	SQ.FT.	
POST MOUNTED SIGNS, TYPE C, LOGO	SQ.FT.	
BREAKAWAY SYSTEMS	EACH	
* STEEL S OR W BEAM POSTS	LBS.	
LOGO SIGN MOUNTING	EACH	
REMOVAL OF POST MOUNTED MOTORIST SERVICE SIGNS, TYPES A & E	EACH	–
REMOVAL OF POST MOUNTED MOTORIST SERVICE SIGNS, TYPES B, C & F	L.S.	

* APPROXIMATE QUANTITY FOR INFORMATION ONLY

SYMBOLS

- ○ *Existing Sign to Remain*
- △ *Existing Sign to be Removed*
- □ *Existing Sign Reset as Shown*
- ● NEW SIGN
- × FUTURE SIGN
- Ø *Existing Utility Pole*

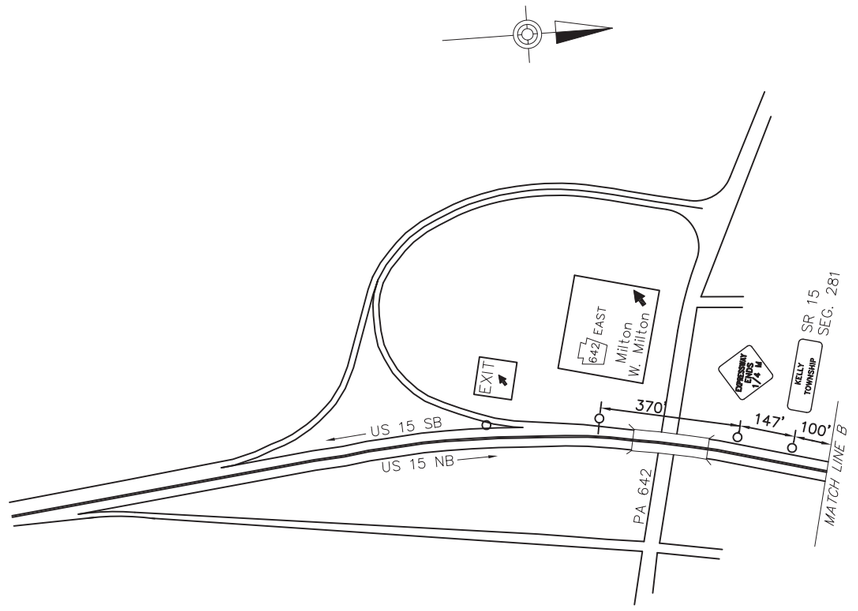

SCHEMATIC PLAN
NOT TO SCALE

W. MILTON EXIT SPECIFIC INFORMATION PANEL			
LEGEND	DIRECTION	BUSINESS	LOGO. NO.
GAS	SB	SUNOCO	1
FOOD	SB		

SB SIGNS

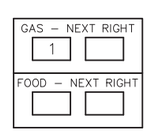

12'Hx13'W
FUTURE 16'H
W12x26
B650 – #1, #1

15
PA 642 EAST
W. MILTON

D:\2015_DBS\215076-01\HW\PSE\AS-BUILT DRAWINGS\PENNDOT DISTRICT 03\UNION - 59\10-XX SHT XX-US15_WMILTON EXIT PLAN
July/15/2019 10:53 AM