DISTRICT	COUNTY	ROUTE	PROJECT	SHEET
9-0	CAMBRIA	U.S. 219		

CAMBRIA TOWNSHIP

REVISIONS

TABULATION OF QUANTITIES		
ITEM	UNIT	QUANTITY
POST MOUNTED SIGNS, TYPE A, LOGO	SQ.FT.	
POST MOUNTED SIGNS, TYPE B, LOGO	SQ.FT.	
BREAKAWAY SYSTEMS	EACH	
* STEEL W BEAM BREAKAWAY POSTS	LBS.	
LOGO SIGN MOUNTING	EACH	
REMOVAL OF POST MOUNTED MOTORIST SERVICE SIGNS, TYPES A & E	EACH	–
REMOVAL OF POST MOUNTED MOTORIST SERVICE SIGNS, TYPES B, C & F	L.S.	–

* APPROXIMATE QUANTITY FOR INFORMATION ONLY

SYMBOLS

- ○ *Existing Sign to Remain*
- △ *Existing Sign to be Removed*
- □ *Existing Sign Reset as Shown*
- ● NEW SIGN
- × FUTURE SIGN
- Ø *Existing Utility Pole*

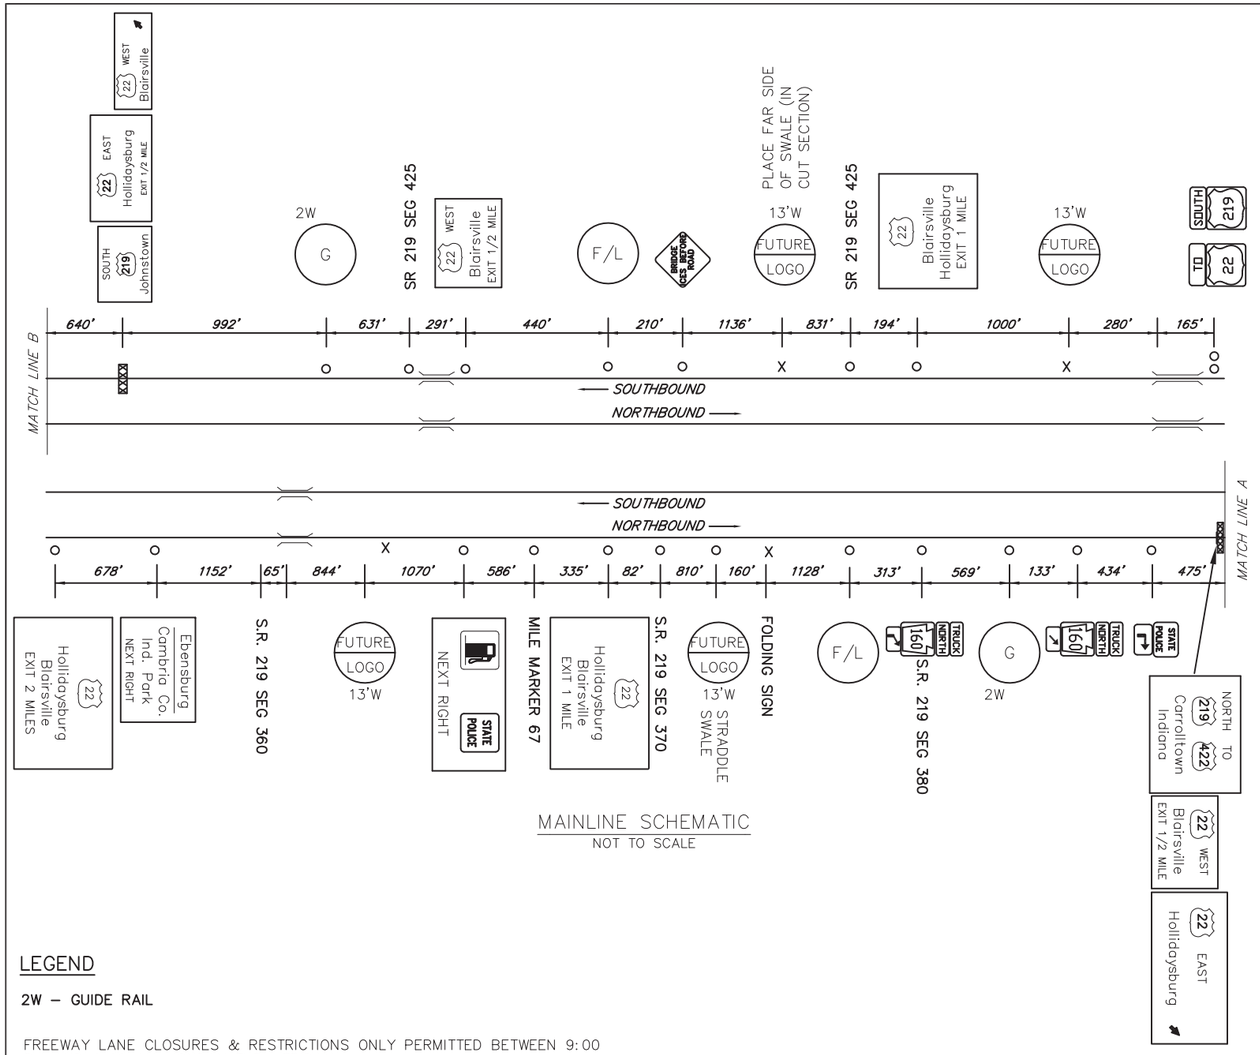

MAINLINE SCHEMATIC
NOT TO SCALE

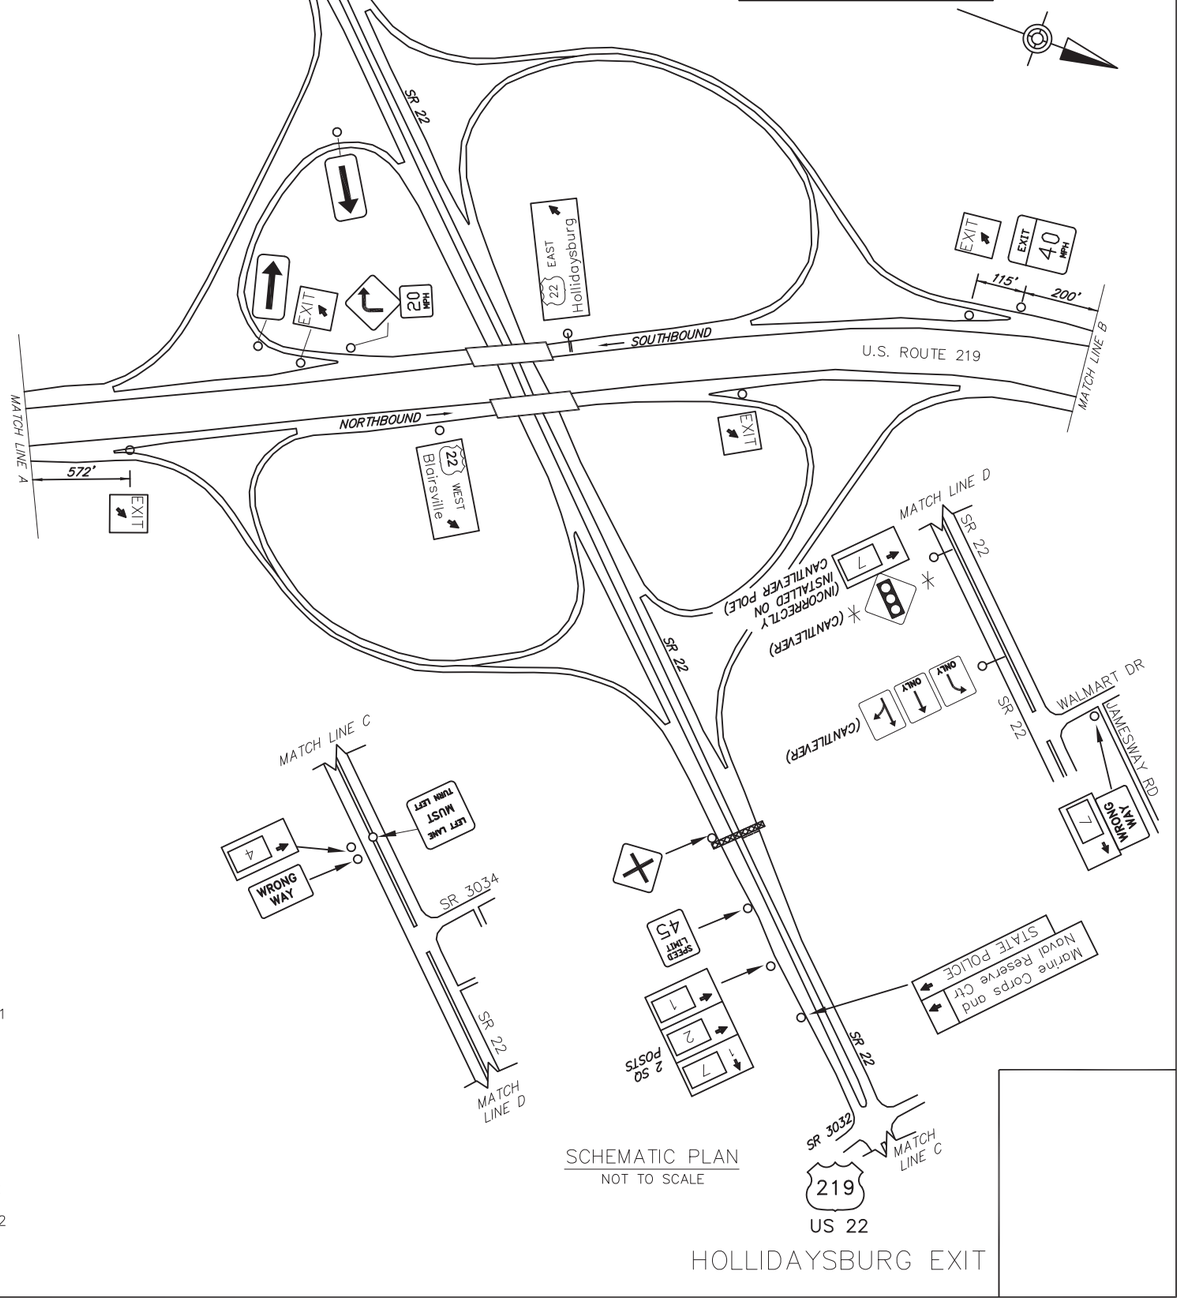

SCHEMATIC PLAN
NOT TO SCALE

LEGEND

2W – GUIDE RAIL

FREEWAY LANE CLOSURES & RESTRICTIONS ONLY PERMITTED BETWEEN 9:00 PM AND 6:00 AM MONDAY THRU FRIDAY.
WORK ALONG FREEWAY PERMITTED BETWEEN 9:00 AM AND 2:30 PM, UNLESS OTHERWISE APPROVED BY ENGINEERING DISTRICT.
DO NOT WORK DURING HOLIDAY PERIODS.
IF APPLICABLE, REINSTALL GUIDERAIL AT END OF EACH DAY.

HOLLIDAYSBURG SPECIFIC INFORMATION PANEL			
LEGEND	DIRECTION	BUSINESS	LOGO. NO.
FOOD	NB/SB	WENDY'S	1
		McDONALD'S	2
		APPLEBEE'S	7
LODGING	NB/SB		
GAS	NB/SB	GETGO	4
		SHEETZ (DIESEL)	5
		MARTIN GENERAL STORES (DIESEL)	6

NB SIGNS

12'Hx13'W FUTURE 14'H W14x30 B650 – #1, #1

GAS–NEXT RIGHT: 4 5
GAS–SECOND RIGHT: 6

16'Hx13'W W12x26 A572 (F) STIM TYPE IV (L) 3M TYPE III B650 – #1, #1

FOOD – NEXT RIGHT: 1 2 7
LODGING–NEXT RIGHT: X

SB SIGNS

12'Hx13'W W14x30 B650 – #1, #1

GAS–NEXT RIGHT: 6
GAS–SECOND RIGHT: 4 5

16'Hx13'W W12x26 A572 3M TYPE III B650 – #1, #2

FOOD – SECOND RIGHT: 1 2 7
LODGING – SECOND RIGHT: X

HOLLIDAYSBURG EXIT

D:\2015_JOBS\215076-01\WW\PSE\AS-BUILT DRAWINGS\PENNDOT DISTRICT 09\CAMBRIA - 11\19-XX SHTXX-219_HOLLIDAYSBURG EXIT PLAN
June/13/2019 3:02 PM