DISTRICT	COUNTY	ROUTE	PROJECT	SHEET
9-0	CAMBRIA	U.S. 22		
CRESSON TOWNSHIP				

TABULATION OF QUANTITIES		
ITEM	UNIT	QUANTITY
POST MOUNTED SIGNS, TYPE A, LOGO	SQ.FT.	
POST MOUNTED SIGNS, TYPE B, LOGO	SQ.FT.	
POST MOUNTED SIGNS, TYPE C, LOGO	SQ.FT.	
BREAKAWAY SYSTEMS	EACH	
* STEEL S OR W BEAM POSTS	LBS.	
LOGO SIGN MOUNTING	EACH	
BREAKAWAY SYSTEM SUPPLIED BY TRUST	EACH	
REMOVAL OF POST MOUNTED MOTORIST SERVICE SIGNS, TYPES B, C & F	L.S.	

* APPROXIMATE QUANTITY FOR INFORMATION ONLY

SYMBOLS

- ○ *Existing Sign to Remain*
- △ *Existing Sign to be Removed*
- □ *Existing Sign Reset as Shown*
- ● NEW SIGN
- × FUTURE SIGN
- Ø *Existing Utility Pole*

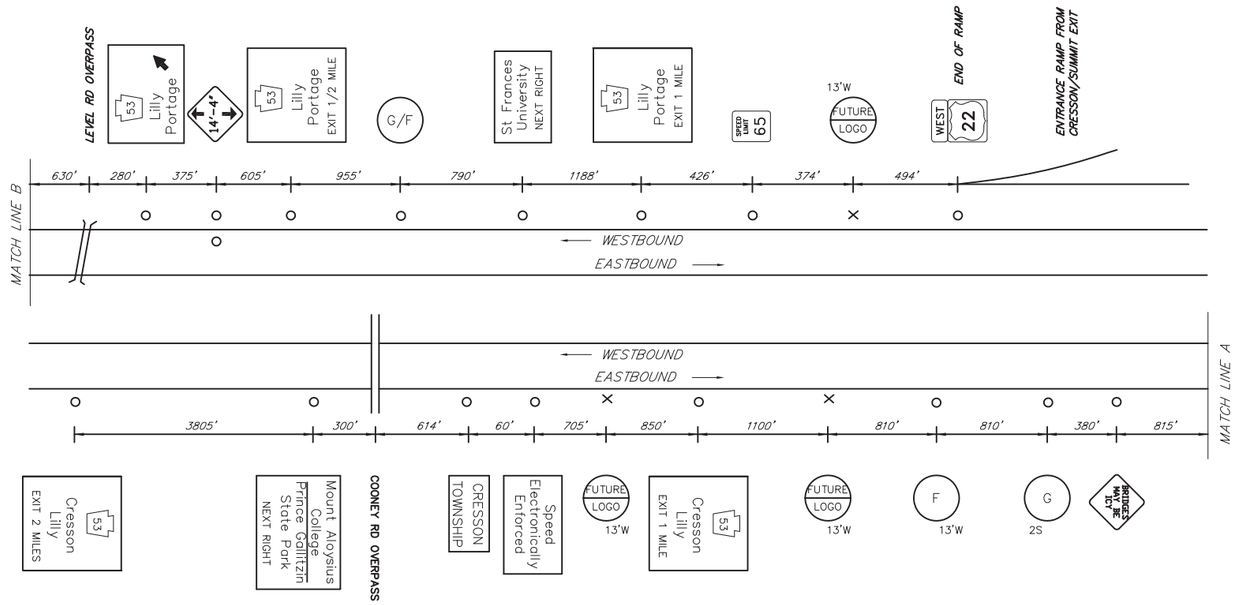

MAINLINE SCHEMATIC
NOT TO SCALE

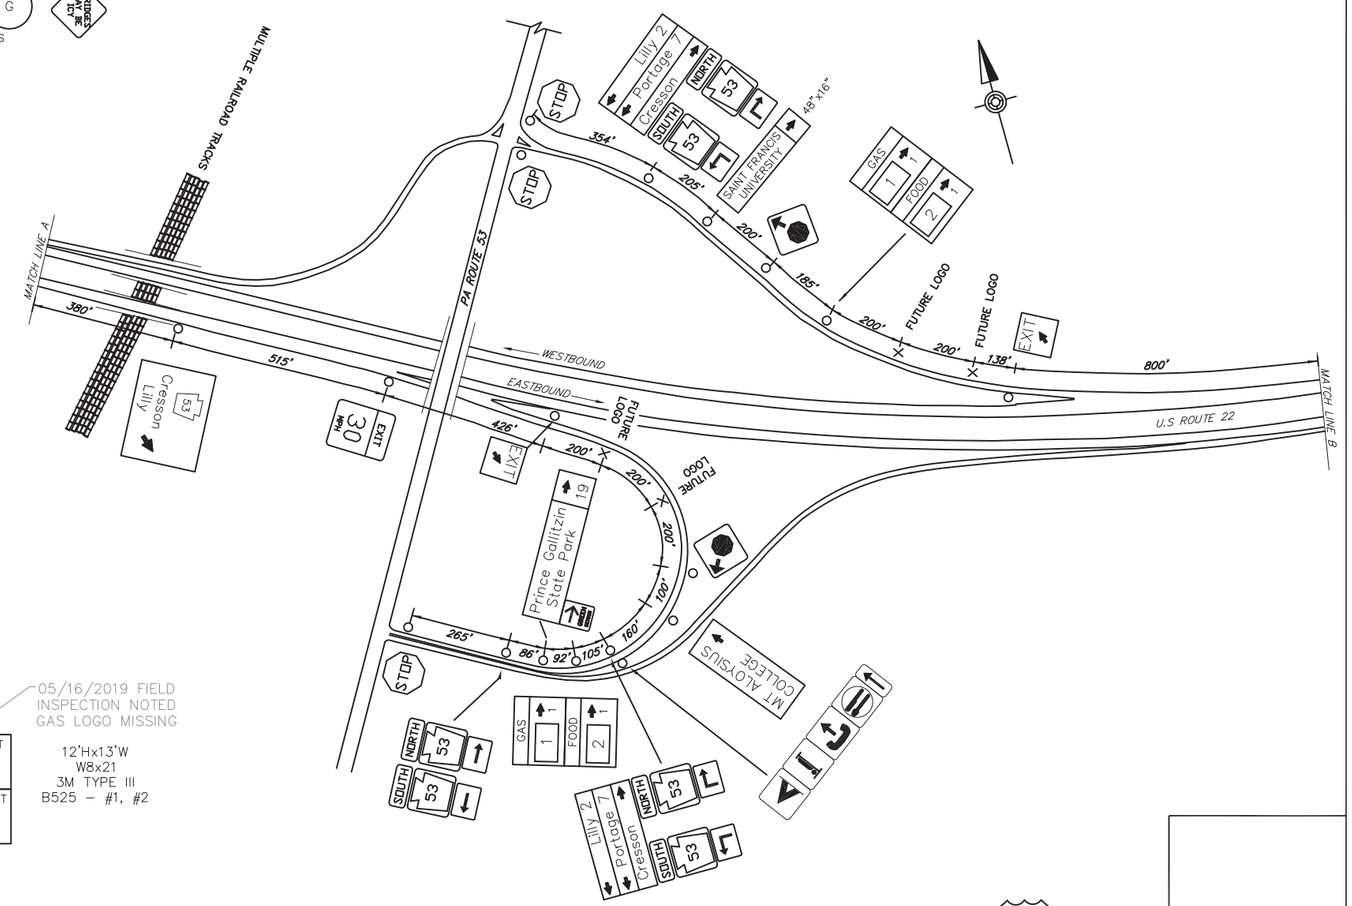

SCHEMATIC PLAN
NOT TO SCALE

LEGEND

2S – GUIDE RAIL

CRESSON SPECIFIC INFORMATION PANEL			
LEGEND	DIRECTION	BUSINESS	LOGO. NO.
GAS	EB/WB	SHEETZ (DIESEL)	1
FOOD	EB/WB	SHEETZ	2

EB SIGNS

6'Hx13'W FUTURE 12'H W8x21 3M TYPE III B525 – #1, #1

GAS – NEXT RIGHT: 1

6'Hx13'W FUTURE 16' W14x30 3M TYPE III B650 – #1, #1

FOOD – NEXT RIGHT: 2

WB SIGNS

GAS – NEXT RIGHT: (1)

FOOD – NEXT RIGHT: 2

12'Hx13'W W8x21 3M TYPE III B525 – #1, #2

05/16/2019 FIELD INSPECTION NOTED GAS LOGO MISSING

22

PA ROUTE 53

CRESSON/PORTAGE

D:\2015_ADBS\215076-01\PW\PSE\AS-BUILT DRAWINGS\PENNDOT DISTRICT 09\CAMBRIA - 11\10-XX SHTXX-22_CRESSON_PORTAGE EXIT PLAN
July/18/2019 3:09 PM