DISTRICT	COUNTY	ROUTE	PROJECT	SHEET
8-0	LANCASTER	US 30		
BORO OF MOUNTVILLE & WEST HEMPFIELD TWP.				
REVISIONS				

TABULATION OF QUANTITIES		
ITEM	UNIT	QUANTITY
POST MOUNTED SIGNS, TYPE A, LOGO	SQ.FT.	
POST MOUNTED SIGNS, TYPE B, LOGO	SQ.FT.	
POST MOUNTED SIGNS, TYPE C, LOGO	SQ.FT.	
BREAKAWAY SYSTEMS	EACH	
* STEEL S OR W BEAM POSTS	LBS.	
LOGO SIGN MOUNTING	EACH	
REMOVAL OF POST MOUNTED MOTORIST SERVICE SIGNS, TYPES A, B, C, E & F	L.S.	

* APPROXIMATE QUANTITY FOR INFORMATION ONLY

SYMBOLS

- ○ *Existing Sign to Remain*
- △ *Existing Sign to be Removed*
- □ *Existing Sign Reset as Shown*
- ● NEW SIGN
- × FUTURE SIGN
- Ø *Existing Utility Pole*

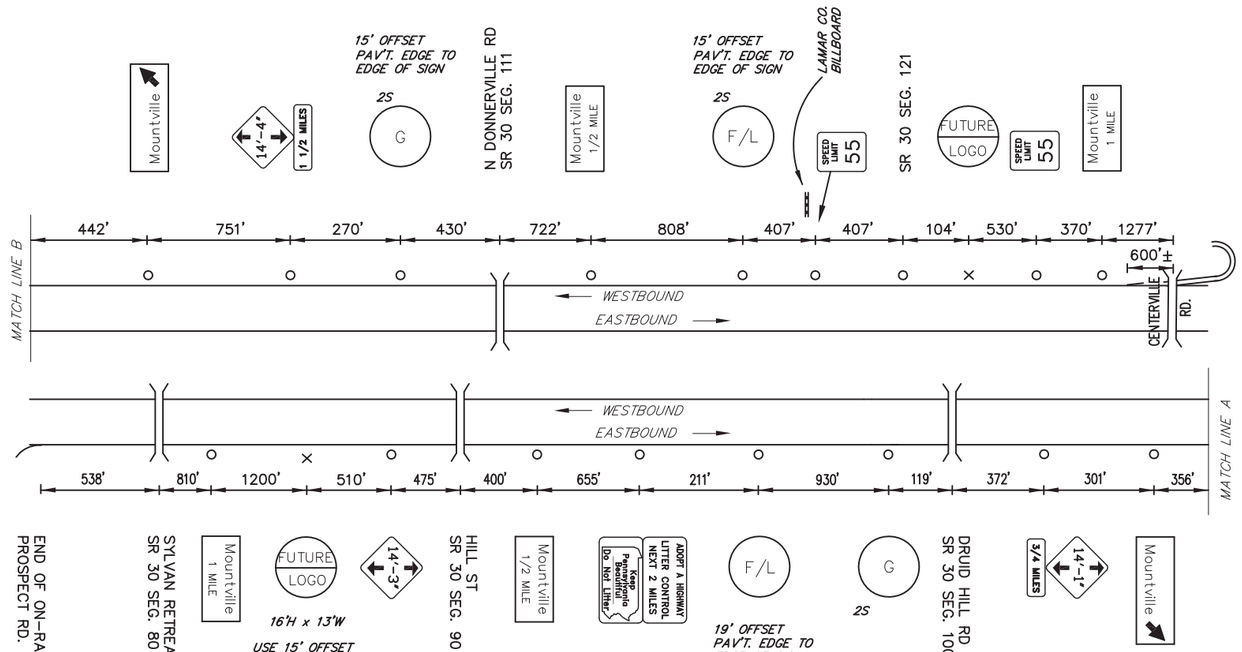

MAINLINE SCHEMATIC
NOT TO SCALE

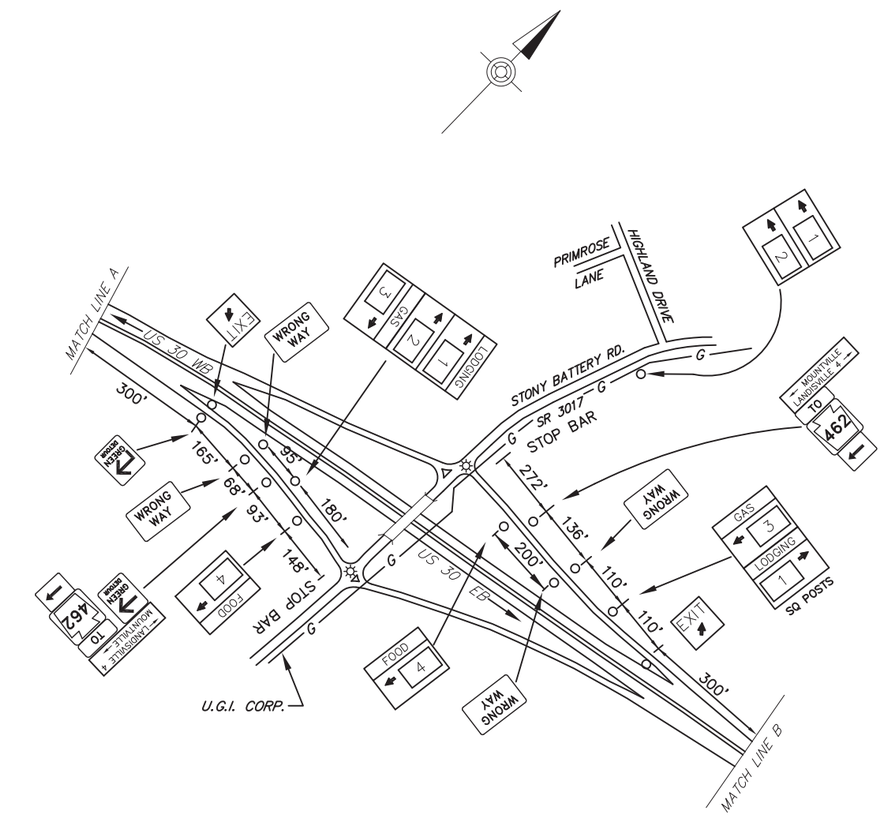

SCHEMATIC PLAN
NOT TO SCALE

LEGEND

2S – GUIDE RAIL

MOUNTVILLE SPECIFIC INFORMATION PANEL			
LEGEND	DIRECTION	BUSINESS	LOGO. NO.
FOOD	EB/WB	RUTTERS (24 HOURS)	4
LODGING	EB/WB	SLEEP INN–INN & SUITES P–041	1
	EB	MAINSTAY SUITES	2
GAS	EB/WB	RUTTER'S (24 HOURS – DIESEL)	3

EB SIGNS

6'Hx13'W FUTURE 16'H W10x26 A572 TYPE III B650 – #1, #1

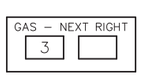

12'Hx13'W FUTURE 16'H W14x30 A572 3M TYPE III B650 – #2, #2

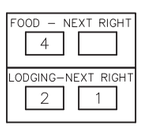

WB SIGNS

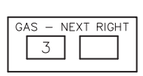

6'Hx13'W FUTURE 16'H W14x30 A572 TYPE III B650 – #1, #1

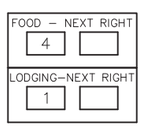

12'Hx13'W FUTURE 16'H W14x30 A572 STIM. TYPE IV B650 – #1, #1

30
SR 3017
STONY BATTERY ROAD
MOUNTVILLE

D:\2015_DIST\215074-01\MKVPSE\AS-BUILT DRAWINGS\PENNDOT DISTRICT 08\LANCASTER - 3X10-XX SHTXX_US30_MOUNTVILLE RD
July/26/2019 12:23 PM