DISTRICT	COUNTY	ROUTE	PROJECT	SHEET
2-0	CLINTON	I-80		
PORTER TOWNSHIP				
REVISIONS				

TABULATION OF QUANTITIES		
ITEM	UNIT	QUANTITY
POST MOUNTED SIGNS, TYPE A, LOGO	SQ.FT.	-
POST MOUNTED SIGNS, TYPE B, LOGO	SQ.FT.	-
POST MOUNTED SIGNS, TYPE C, LOGO	SQ.FT.	-
BREAKAWAY SYSTEMS	EACH	-
* STEEL S OR W BEAM POSTS	LBS.	-
LOGO SIGN MOUNTING	EACH	-
FLAT SHEET PANEL REPLACEMENT	SQ.FT.	
EXTRUDED PANEL REPLACEMENT	SQ.FT.	
REMOVAL OF POST MOUNTED MOTORIST SERVICE SIGNS, TYPES B, C & F	L.S.	

* APPROXIMATE QUANTITY FOR INFORMATION ONLY

SYMBOLS

- ○ *Existing Sign to Remain*
- △ *Existing Sign to be Removed*
- □ *Existing Sign Reset as Shown*
- ● NEW SIGN
- × FUTURE SIGN
- Ø *Existing Utility Pole*

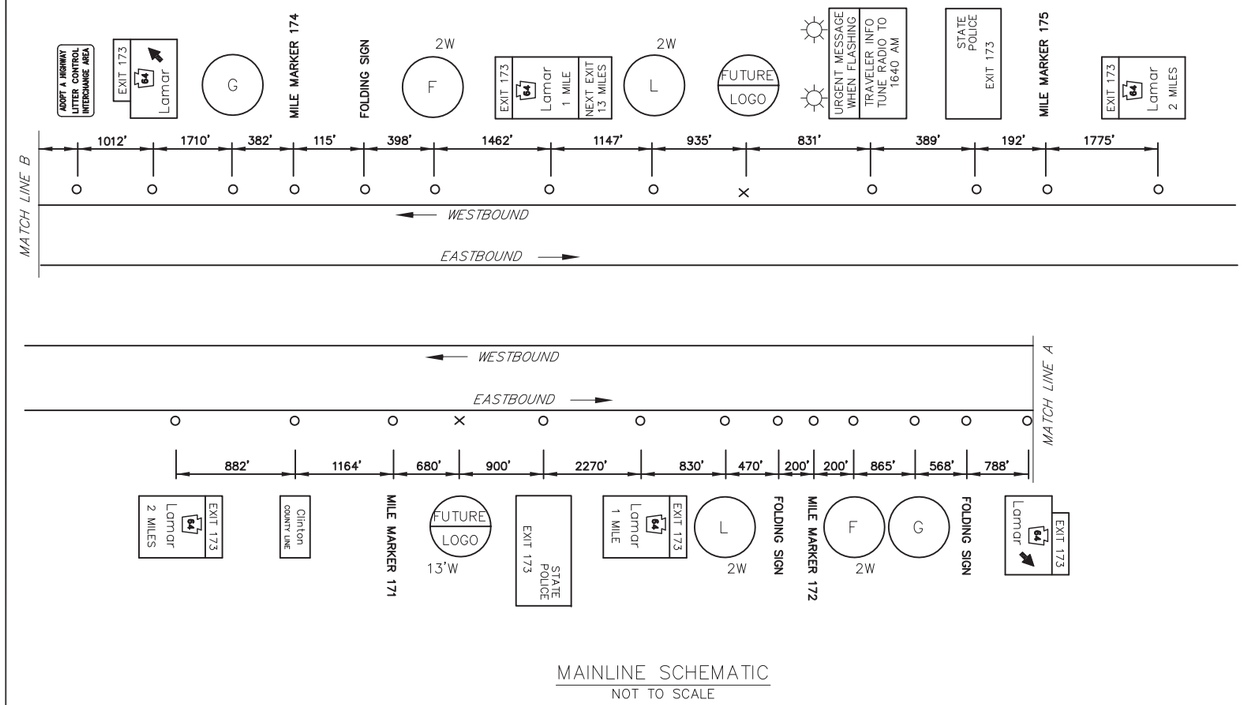

MAINLINE SCHEMATIC
NOT TO SCALE

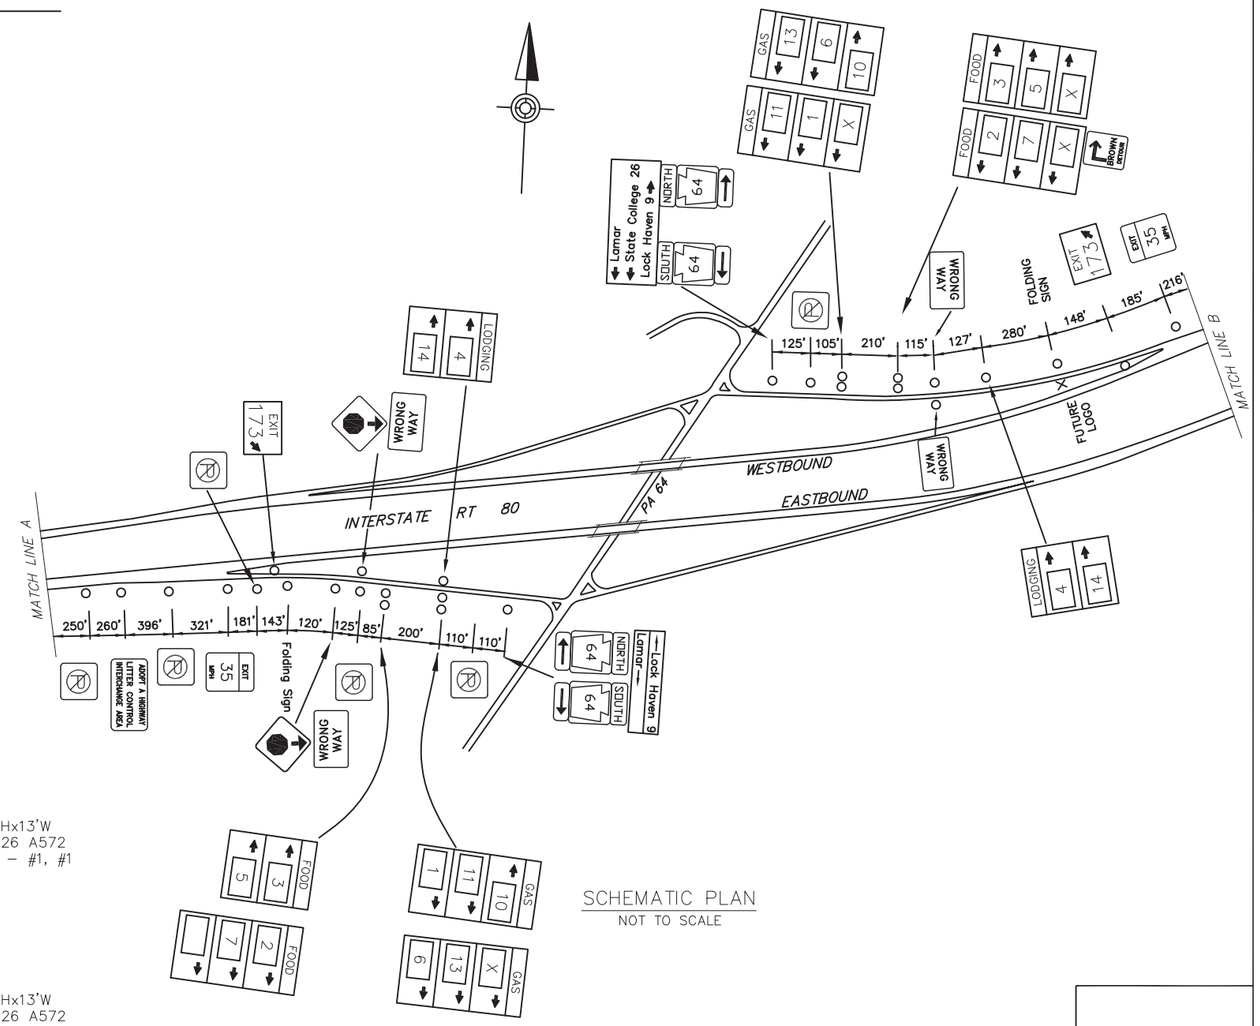

SCHEMATIC PLAN
NOT TO SCALE

LEGEND

2W - GUIDE RAIL

FREEWAY LANE CLOSURES/RESTRICTIONS
NOT PERMITTED ON FRIDAYS.

EXIT 173 SPECIFIC INFORMATION PANEL			
LEGEND	DIRECTION	BUSINESS	LOGO. NO.
GAS	EB/WB	SHELL (24 HOURS)	1
		VALERO	6
		PILOT TRAVEL CENTERS (24 HOURS)	10
		TA (DIESEL/24 HOURS)	11
		FLYING J (24 HOURS)	13
FOOD	EB/WB	COUNTRY PRIDE RESTAURANT	2
		THE COTTAGE FAMILY RESTAURANT	3
		McDONALD'S	5
		DENNY'S (24 HOURS)	7
LODGING	EB/WB	QUALITY INN	4
		HAMPTON INN & SUITES	14

EB SIGNS

14'Hx13'W
W12x26 A572
B650 - #1, #1

GAS - EXIT 173: 11 1 / 13 / 6 10

14'Hx13'W
W14x30 A572
3M TYPE III
B650 - #1, #1

FOOD - EXIT 173: 2 3 / 5 X / X 7

6'Hx13'W
FUTURE 12'H
W10x26 A36
3M TYPE III
B650 - #2, #1

LODGING-EXIT 173: 4 14

WB SIGNS

14'Hx13'W
W12x26 A572
B650 - #1, #1

GAS - EXIT 173: 10 11 / 1 / 13 6

14'Hx13'W
W12x26 A572
3M TYPE III
B650 - #1, #1

FOOD - EXIT 173: 2 3 / 5 X / X 7

6'Hx13'W
FUTURE 12'H
W10x26 A36
B650 - #2, #1

LODGING-EXIT 173: 4 14

INTERSTATE 80
LAMAR
EXIT 173

D:\2015_EBRS\215076-01\MX\PSE\AS-BUILT DRAWINGS\PENNDOT DISTRICT 02\CLINTON - I80\I-XX SHTXX-I80_EXIT 173 PLAN
August 7, 2019 12:59 PM