DISTRICT	COUNTY	ROUTE	PROJECT	SHEET
5-0	MONROE	I-80	–	–
TOBYHANNA TOWNSHIP, MONROE COUNTY				
5-0	CARBON	I-80		
KIDDER TOWNSHIP				
REVISIONS				

TABULATION OF QUANTITIES		
ITEM	UNIT	QUANTITY
POST MOUNTED SIGNS, TYPE A, LOGO	SQ.FT.	–
POST MOUNTED SIGNS, TYPE B, LOGO	SQ.FT.	–
POST MOUNTED SIGNS, TYPE C, LOGO	SQ.FT.	–
BREAKAWAY SYSTEMS	EACH	–
* STEEL S OR W BEAM POSTS	LBS.	–
LOGO SIGN MOUNTING	EACH	–
FLAT SHEET PANEL REPLACEMENT	SQ.FT.	–
EXTRUDED PANEL REPLACEMENT	SQ.FT.	–
REMOVAL OF POST MOUNTED MOTORIST SERVICE SIGNS, TYPES B, C & F	L.S.	–

* APPROXIMATE QUANTITY FOR INFORMATION ONLY

SYMBOLS

- ○ *Existing Sign to Remain*
- △ *Existing Sign to be Removed*
- □ *Existing Sign Reset as Shown*
- ● NEW SIGN
- × FUTURE SIGN
- Ø *Existing Utility Pole*

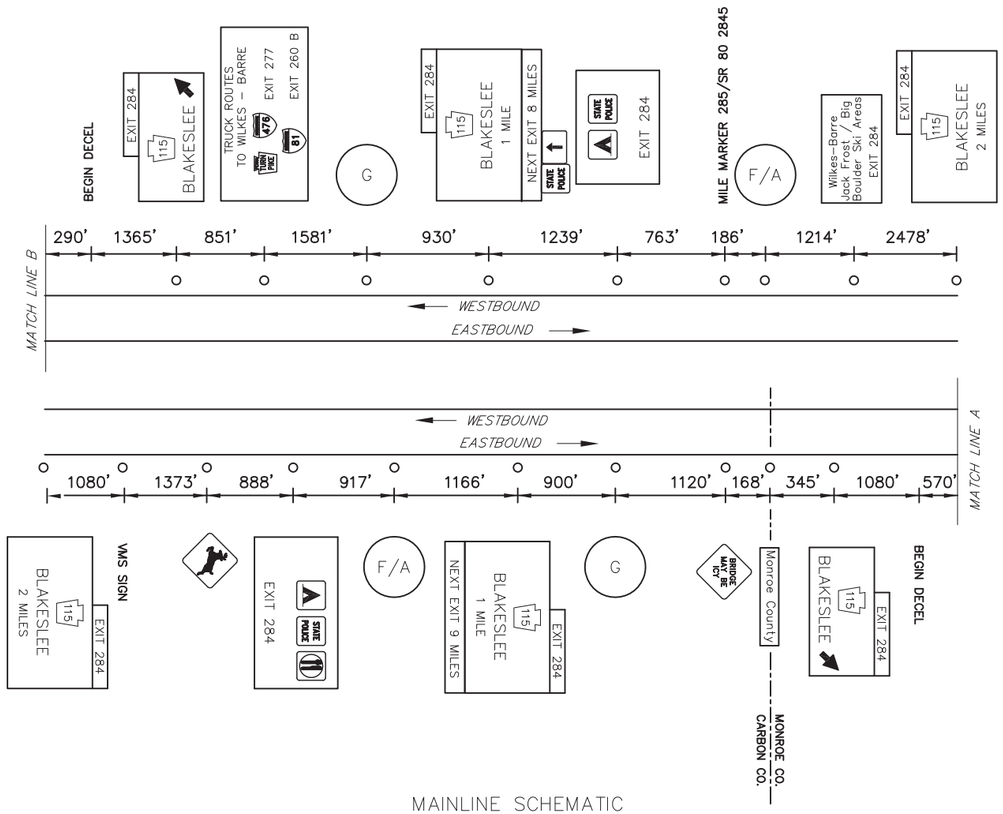

MAINLINE SCHEMATIC
NOT TO SCALE

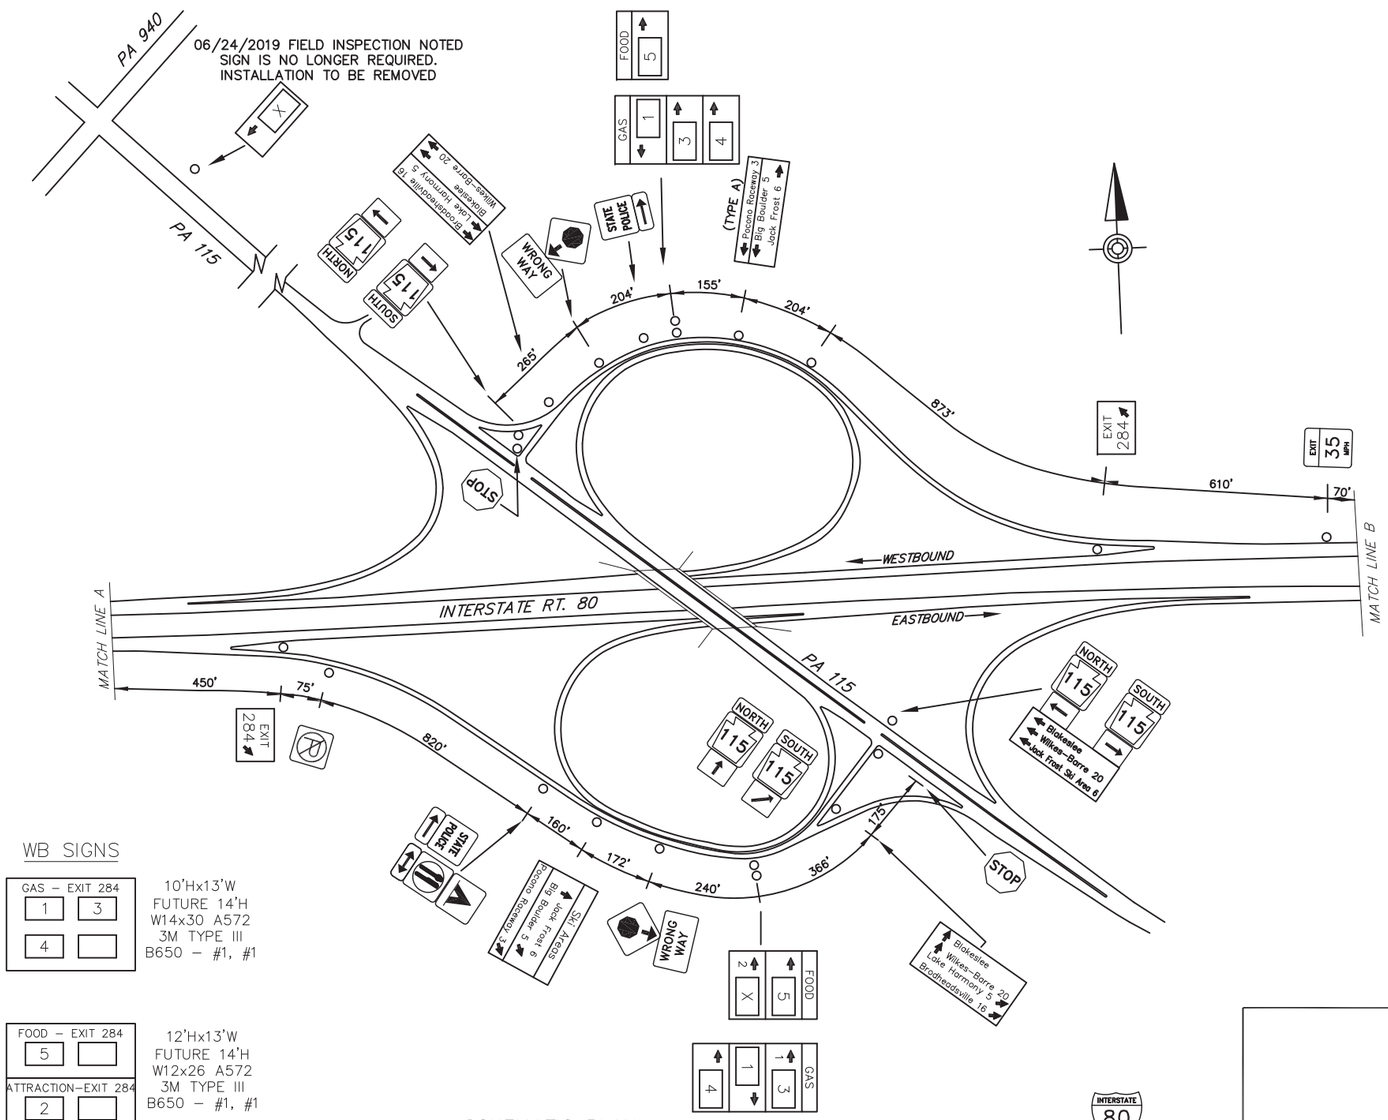

SCHEMATIC PLAN
NOT TO SCALE

DO NOT CLOSE OR RESTRICT TRAVEL LANES BETWEEN 6:00 AM AND 9:00 AM, AND BETWEEN 3:00 PM AND 6:00 PM, MONDAY THRU FRIDAY. DO NOT WORK DURING HOLIDAY PERIODS.

NO WORK PERMITTED ON POCONO RACEWAY EVENT DATES.

EXIT 284 SPECIFIC INFORMATION PANEL			
LEGEND	DIRECTION	BUSINESS	LOGO. NO.
GAS	EB/WB	GULF (24 HRS / DIESEL)	1
		WAWA (DIESEL)	3
		SUNOCO (DIESEL)	4
FOOD	EB/WB	BURGER KING	5
ATTRACTION	EB/WB	POCONO RACEWAY	2

EB SIGNS

10'Hx13'W
FUTURE 16'H
W10x26 A572
3M TYPE III
B650– #1, #1

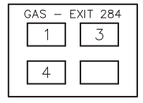

12'Hx13'W
FUTURE 16'H
W12x26 A572
3M TYPE III
B650 – #1, #1

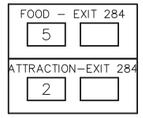

WB SIGNS

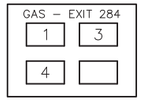

10'Hx13'W
FUTURE 14'H
W14x30 A572
3M TYPE III
B650 – #1, #1

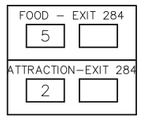

12'Hx13'W
FUTURE 14'H
W12x26 A572
3M TYPE III
B650 – #1, #1

INTERSTATE 80

BLAKESLEE

EXIT 284

D:\2015_ADES\215076-01\WORKSPACE\AS-BUILT DRAWINGS\PENNDOT DISTRICT 05\MONROE - 45\10-XX SHTXX-180_EXIT 284 A PLAN
August 7, 2019 11:59 AM