DISTRICT	COUNTY	ROUTE	PROJECT	SHEET
8-0	YORK	I-83		

SPRING GARDEN AND SPRINGETTSBURY TOWNSHIP
REVISIONS

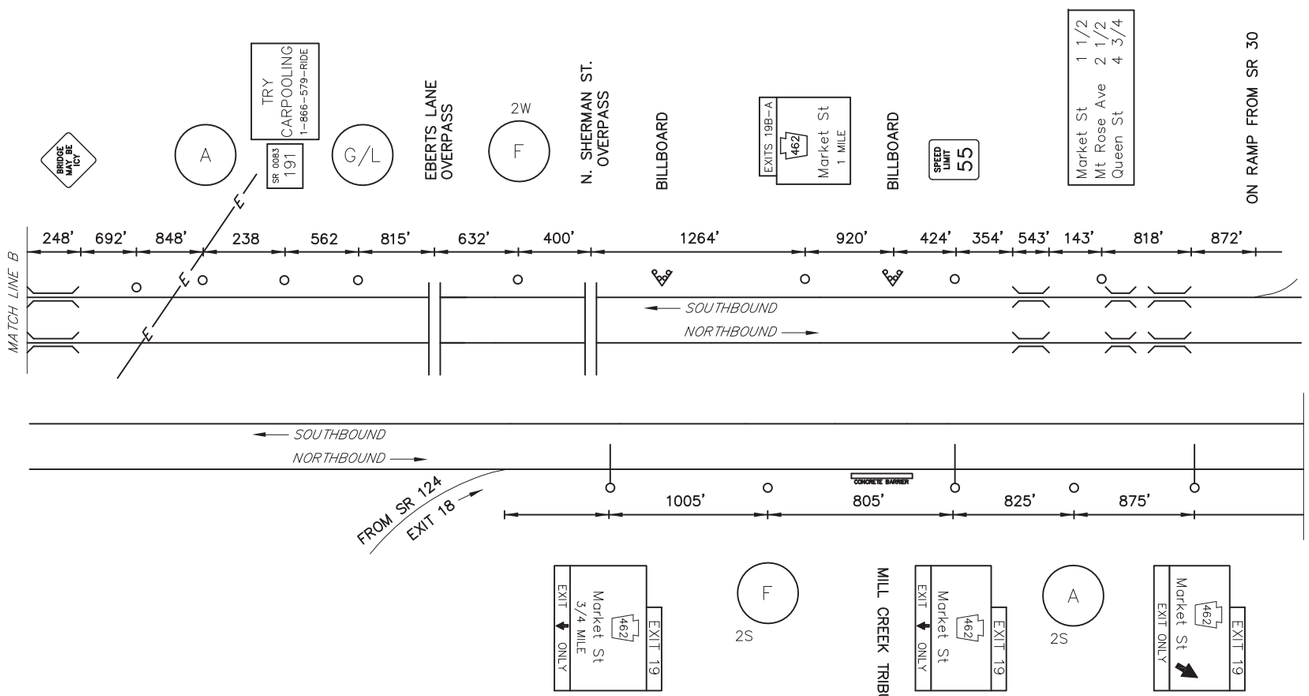

MAINLINE SCHEMATIC
NOT TO SCALE

TABULATION OF QUANTITIES		
ITEM	UNIT	QUANTITY
POST MOUNTED SIGNS, TYPE A, LOGO	SQ.FT.	–
POST MOUNTED SIGNS, TYPE B, LOGO	SQ.FT.	–
POST MOUNTED SIGNS, TYPE C, LOGO	SQ.FT.	–
BREAKAWAY SYSTEMS	EACH	–
* STEEL S OR W BEAM POSTS	LBS.	–
LOGO SIGN MOUNTING	EACH	–

* APPROXIMATE QUANTITY FOR INFORMATION ONLY

SYMBOLS

- ○ *Existing Sign to Remain*
- △ *Existing Sign to be Removed*
- □ *Existing Sign Reset as Shown*
- ○ NEW SIGN
- × FUTURE SIGN
- Ø *Existing Utility Pole*

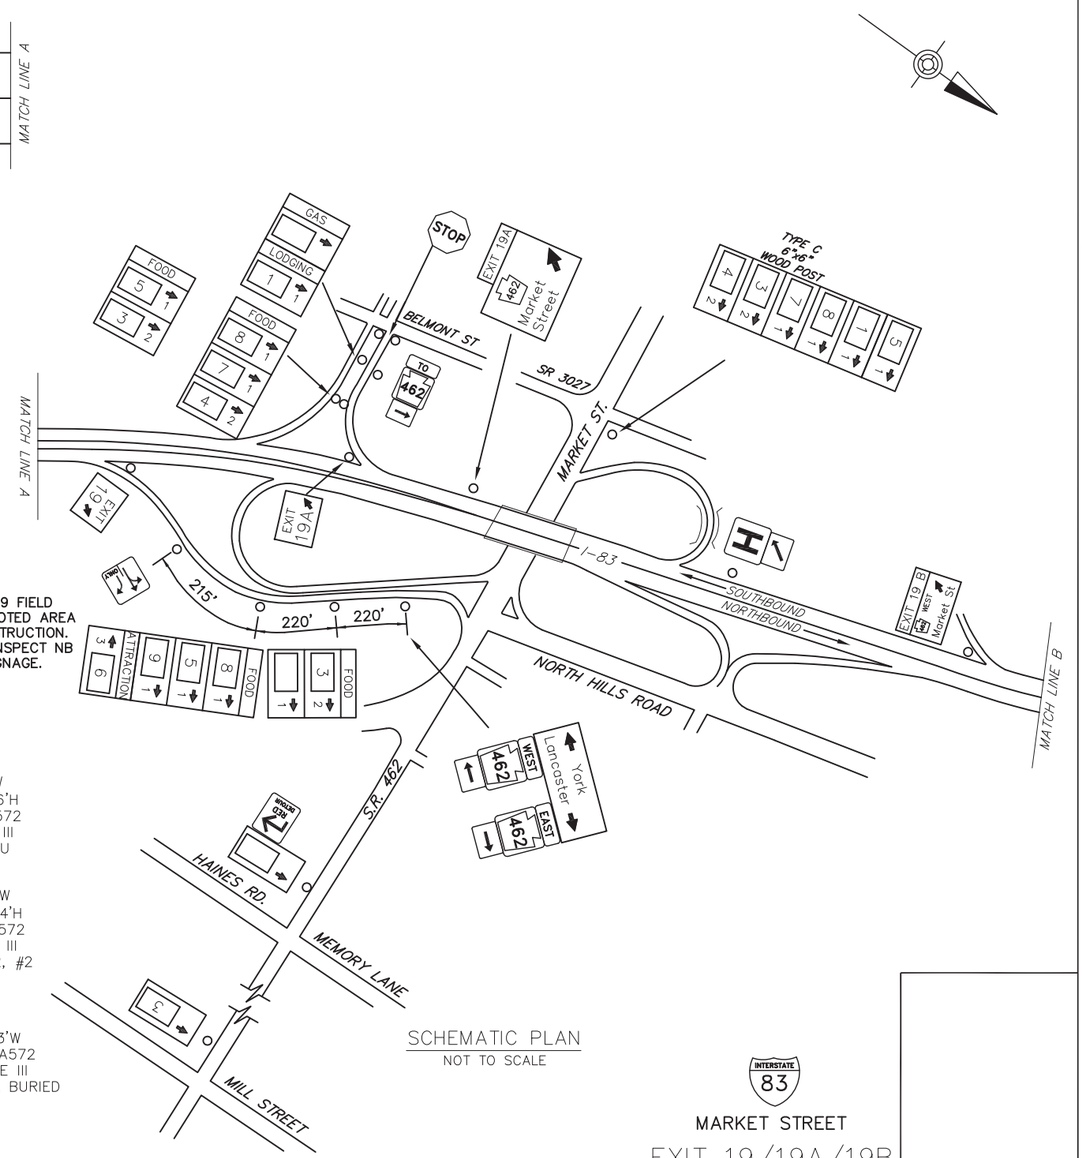

05/14/2019 FIELD INSPECTION NOTED AREA UNDER CONSTRUCTION. UNABLE TO INSPECT NB RAMP SIGNAGE.

SCHEMATIC PLAN
NOT TO SCALE

LEGEND

2S/2W – GUIDE RAIL

FREEWAY LANE CLOSURES & RESTRICTIONS ONLY PERMITTED BETWEEN 9:00 PM AND 6:00 AM MONDAY THRU FRIDAY. DO NOT WORK DURING HOLIDAY PERIODS.

EXIT 19/19A SPECIFIC INFORMATION PANEL			
LEGEND	DIRECTION	BUSINESS	LOGO. NO.
GAS	SB		
LODGING	SB	QUALITY INN & SUITES	1
ATTRACTION	NB	HISTORIC DOWNTOWN YORK	6
FOOD	NB/SB	CHICK-FIL-A (CLOSED SUNDAY)	3
		DUNKIN DONUTS	5
		WENDY'S	8
	NB	FUDDRUCKER'S	9
	SB	APPLEBEE'S	4
		ARBY'S	7

NB SIGNS

05/14/2019 FIELD INSPECTION NOTED AREA UNDER CONSTRUCTION. UNABLE TO INSPECT NB MAINLINE SIGNAGE.

PROPOSED

6'Hx13'W
FUTURE 16'H
W14x30 A572
3M TYPE III
SBM-B650

ATTRACTION-EXIT 19: 6

14'Hx13'W
FUTURE 16'
W14x30 A572
B650 – #2, #1

FOOD-EXIT 19: 5, 8, 9, 3

SB SIGNS

ATTRACTION-EXIT 19B

6'Hx13'W
FUTURE 16'H
W18x40 A572
3M TYPE III
B650 – U

GAS – EXIT 19A
LODGING – EXIT 19A: 1

12'Hx13'W
FUTURE 14'H
W14x30 A572
3M TYPE III
B650 – #2, #2

FOOD-EXIT 19A: X, 4, 3, 7, 5, 8

14'Hx13'W
W14x30 A572
3M TYPE III
B650 – #2, BURIED

INTERSTATE 83

MARKET STREET

EXIT 19/19A/19B

D:\2015_GBS\215076-01\HW\PSE\AS-BUILT DRAWINGS\PENNDOT DISTRICT 08\YORK - 66\10-XX SHT0X-I83_EXIT 19A PLAN
June/10/2019 5:39 PM