DISTRICT	COUNTY	ROUTE	PROJECT	SHEET
8-0	YORK	I-83		
MANCHESTER TOWNSHIP				
REVISIONS				

TABULATION OF QUANTITIES		
ITEM	UNIT	QUANTITY
POST MOUNTED SIGNS, TYPE B TODS	SQ.FT.	
POST MOUNTED SIGNS, TYPE E TODS	SQ.FT.	--
FLAT SHEET PANEL REPLACEMENT	SQ.FT.	--
MAINTENANCE & PROTECTION OF TRAFFIC AND OTHER ANCILLARY WORK AS DIRECTED	LS	INCLUDED

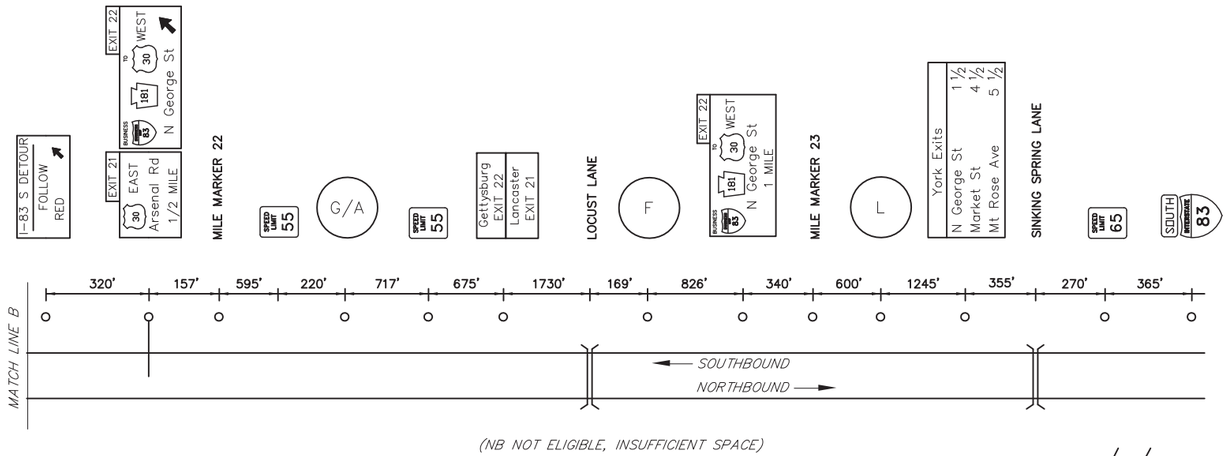

(NB NOT ELIGIBLE, INSUFFICIENT SPACE)

MAINLINE SCHEMATIC
NOT TO SCALE

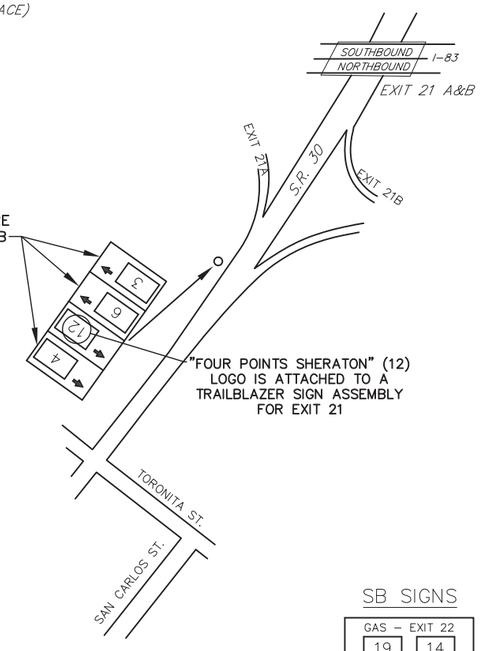

FREEWAY LANE CLOSURES & RESTRICTIONS
ONLY PERMITTED BETWEEN 9:00 PM AND
6:00 AM MONDAY THRU FRIDAY.
DO NOT WORK DURING HOLIDAY PERIODS.

EXIT 22 SPECIFIC INFORMATION PANEL			
LEGEND	DIRECTION	BUSINESS	LOGO. NO.
FOOD	SB	DUNKIN DONUTS (OPEN 24 HRS)	1
		SUBWAY	2
		WENDY'S	3
		TACO BELL	4
		ARBY'S	6
LODGING	SB	RODEWAY INN	7
		COMFORT INN	9
		SUPER 8	10
		HOMEWOOD SUITES - HILTON	11
		FOUR POINTS SHERATON	12
GAS	SB	RUTTER'S (DIESEL 24 HRS)	19
		RUTTER'S (24 HOURS)	14
ATTRACTION	SB	HACC - YORK CAMPUS	18

SB SIGNS

16'Hx13'W
W14x30 A572
3M TYPE III
B650 - #2, #2

GAS - EXIT 22	
19	14
ATTRACTION-EXIT 22	
	18
X	

14'Hx13'W
W12x26 A572
3M TYPE III
B650 - #1, #2

FOOD - EXIT 22	
6	2
1	3
4	X

14'Hx13'W
W10x22 A572
3M TYPE III
B650 - #2, #2

LODGING - EXIT 22	
7	
11	10
12	9

SYMBOLS
- ○ Existing Sign to Remain
- △ Existing Sign to be Removed
- □ Existing Sign Reset as Shown
- ● NEW SIGN
- × FUTURE SIGN
- Ø Existing Utility Pole

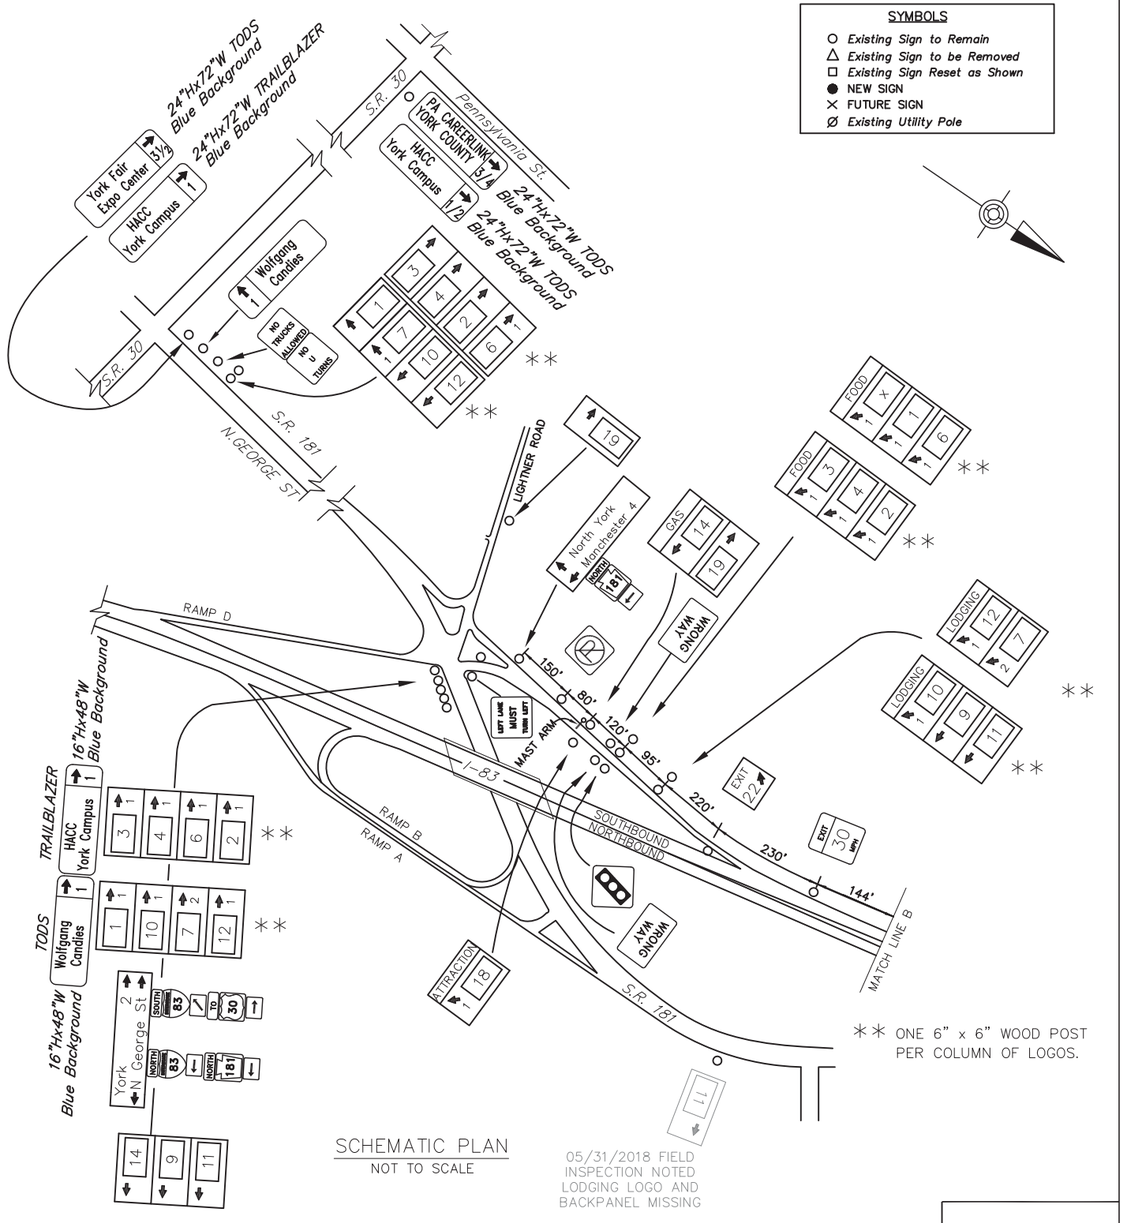

** ONE 6" x 6" WOOD POST PER COLUMN OF LOGOS.

SCHEMATIC PLAN
NOT TO SCALE

05/31/2018 FIELD INSPECTION NOTED LODGING LOGO AND BACKPANEL MISSING

INTERSTATE 83

N. GEORGE STREET

EXIT 22

D:\2015_ED\81-215076-01\MVPSE\AS-BUILT DRAWINGS\PENNDOT DISTRICT 08\YORK - 66\10-XX SHTOX-183_EXIT 22 PLAN
August 1, 2019 5:03 PM